

MAIZE ROAD

PROP. 18" SWS


WESTLAKES CT.

WESTLAKES CT.

19

45

THIS DWG IS IN  
OFF DATUM/  
PLEASE DO NOT ADJUST

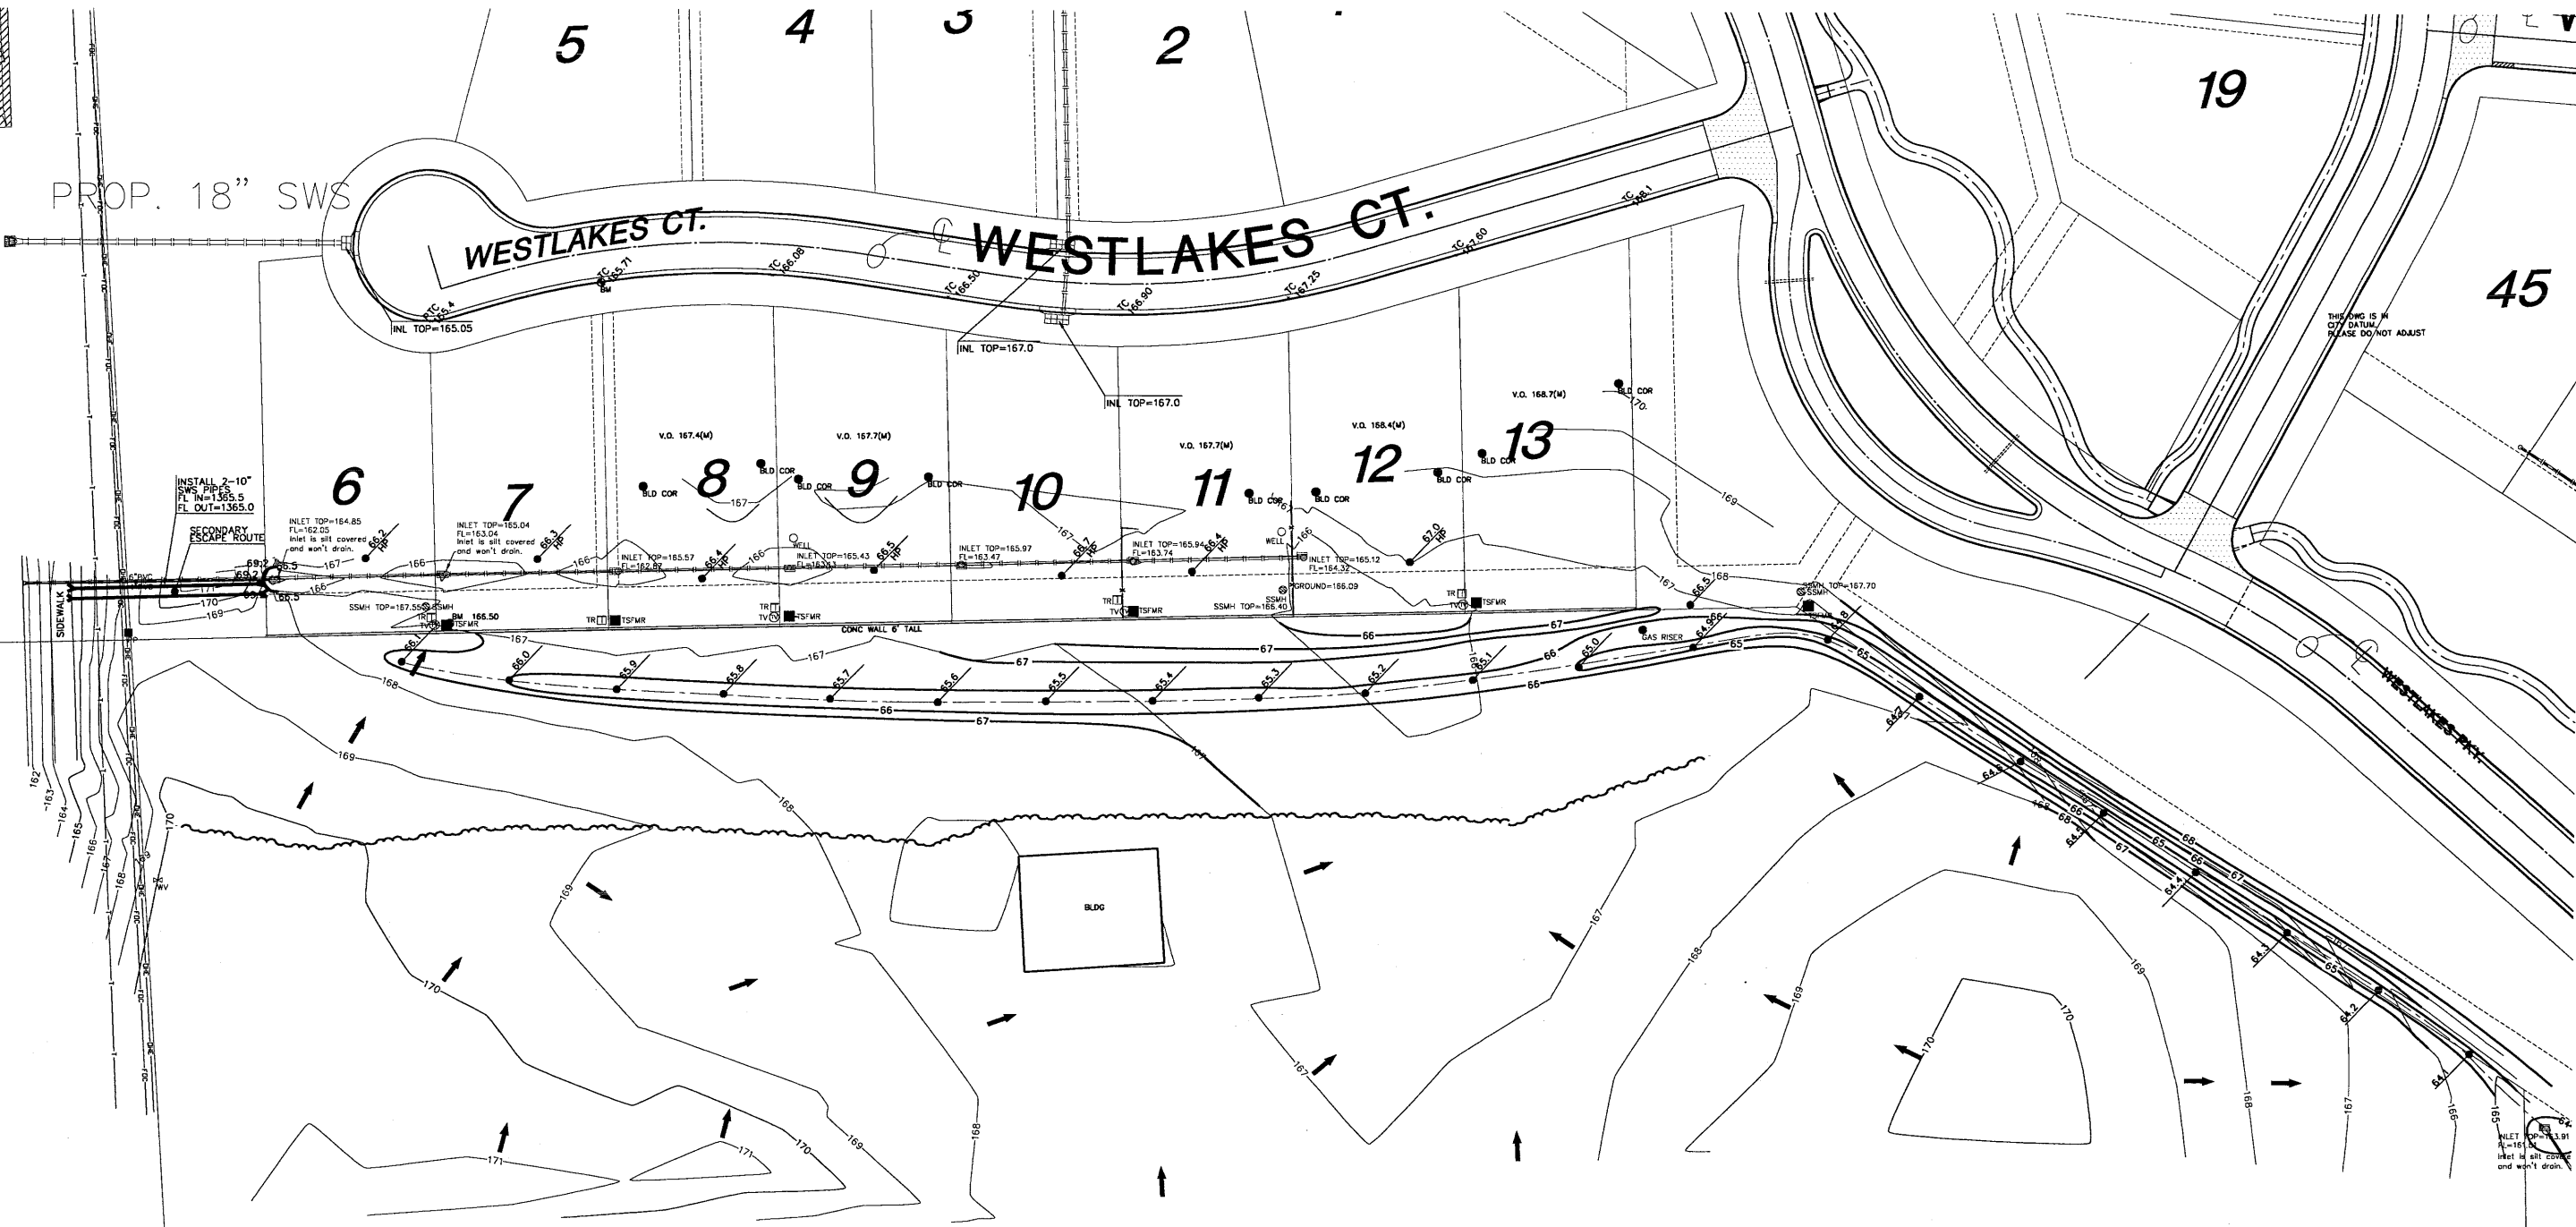

INSTALL 2-10" SWS PIPE INLET INLET=1365.5 FL OUT=1365.0

SECONDARY ESCAPE ROUTE

INLET TOP=164.85 FL=162.05 Inlet is silt covered and won't drain.

INLET TOP=165.04 FL=163.04 Inlet is silt covered and won't drain.

INLET TOP=165.57 FL=162.57

INLET TOP=165.97 FL=163.47

INLET TOP=165.94 FL=163.74

INLET TOP=165.12 FL=164.32

SSMH TOP=167.70

BLDG

INLET TOP=163.91 FL=161.91 Inlet is silt covered and won't drain.