


SCALE: 1" = 40'

Parent Benchmark:
Chiseled square on top of curb at west end
of Southwest return at Central and Ellison
Elevation 1387.88

BM A:
Chiseled square on south corner of culvert
just south of drive return of Lot 7, Block 1
Elevation 1370.91

BM B:
Chiseled square on top of curb, west of
drive return of 329 Crest Circle
Elevation 1370.20

BM C:
Chiseled square on the east side, Northwest
corner of RCBC in Reserve B
Elevation 1370.79

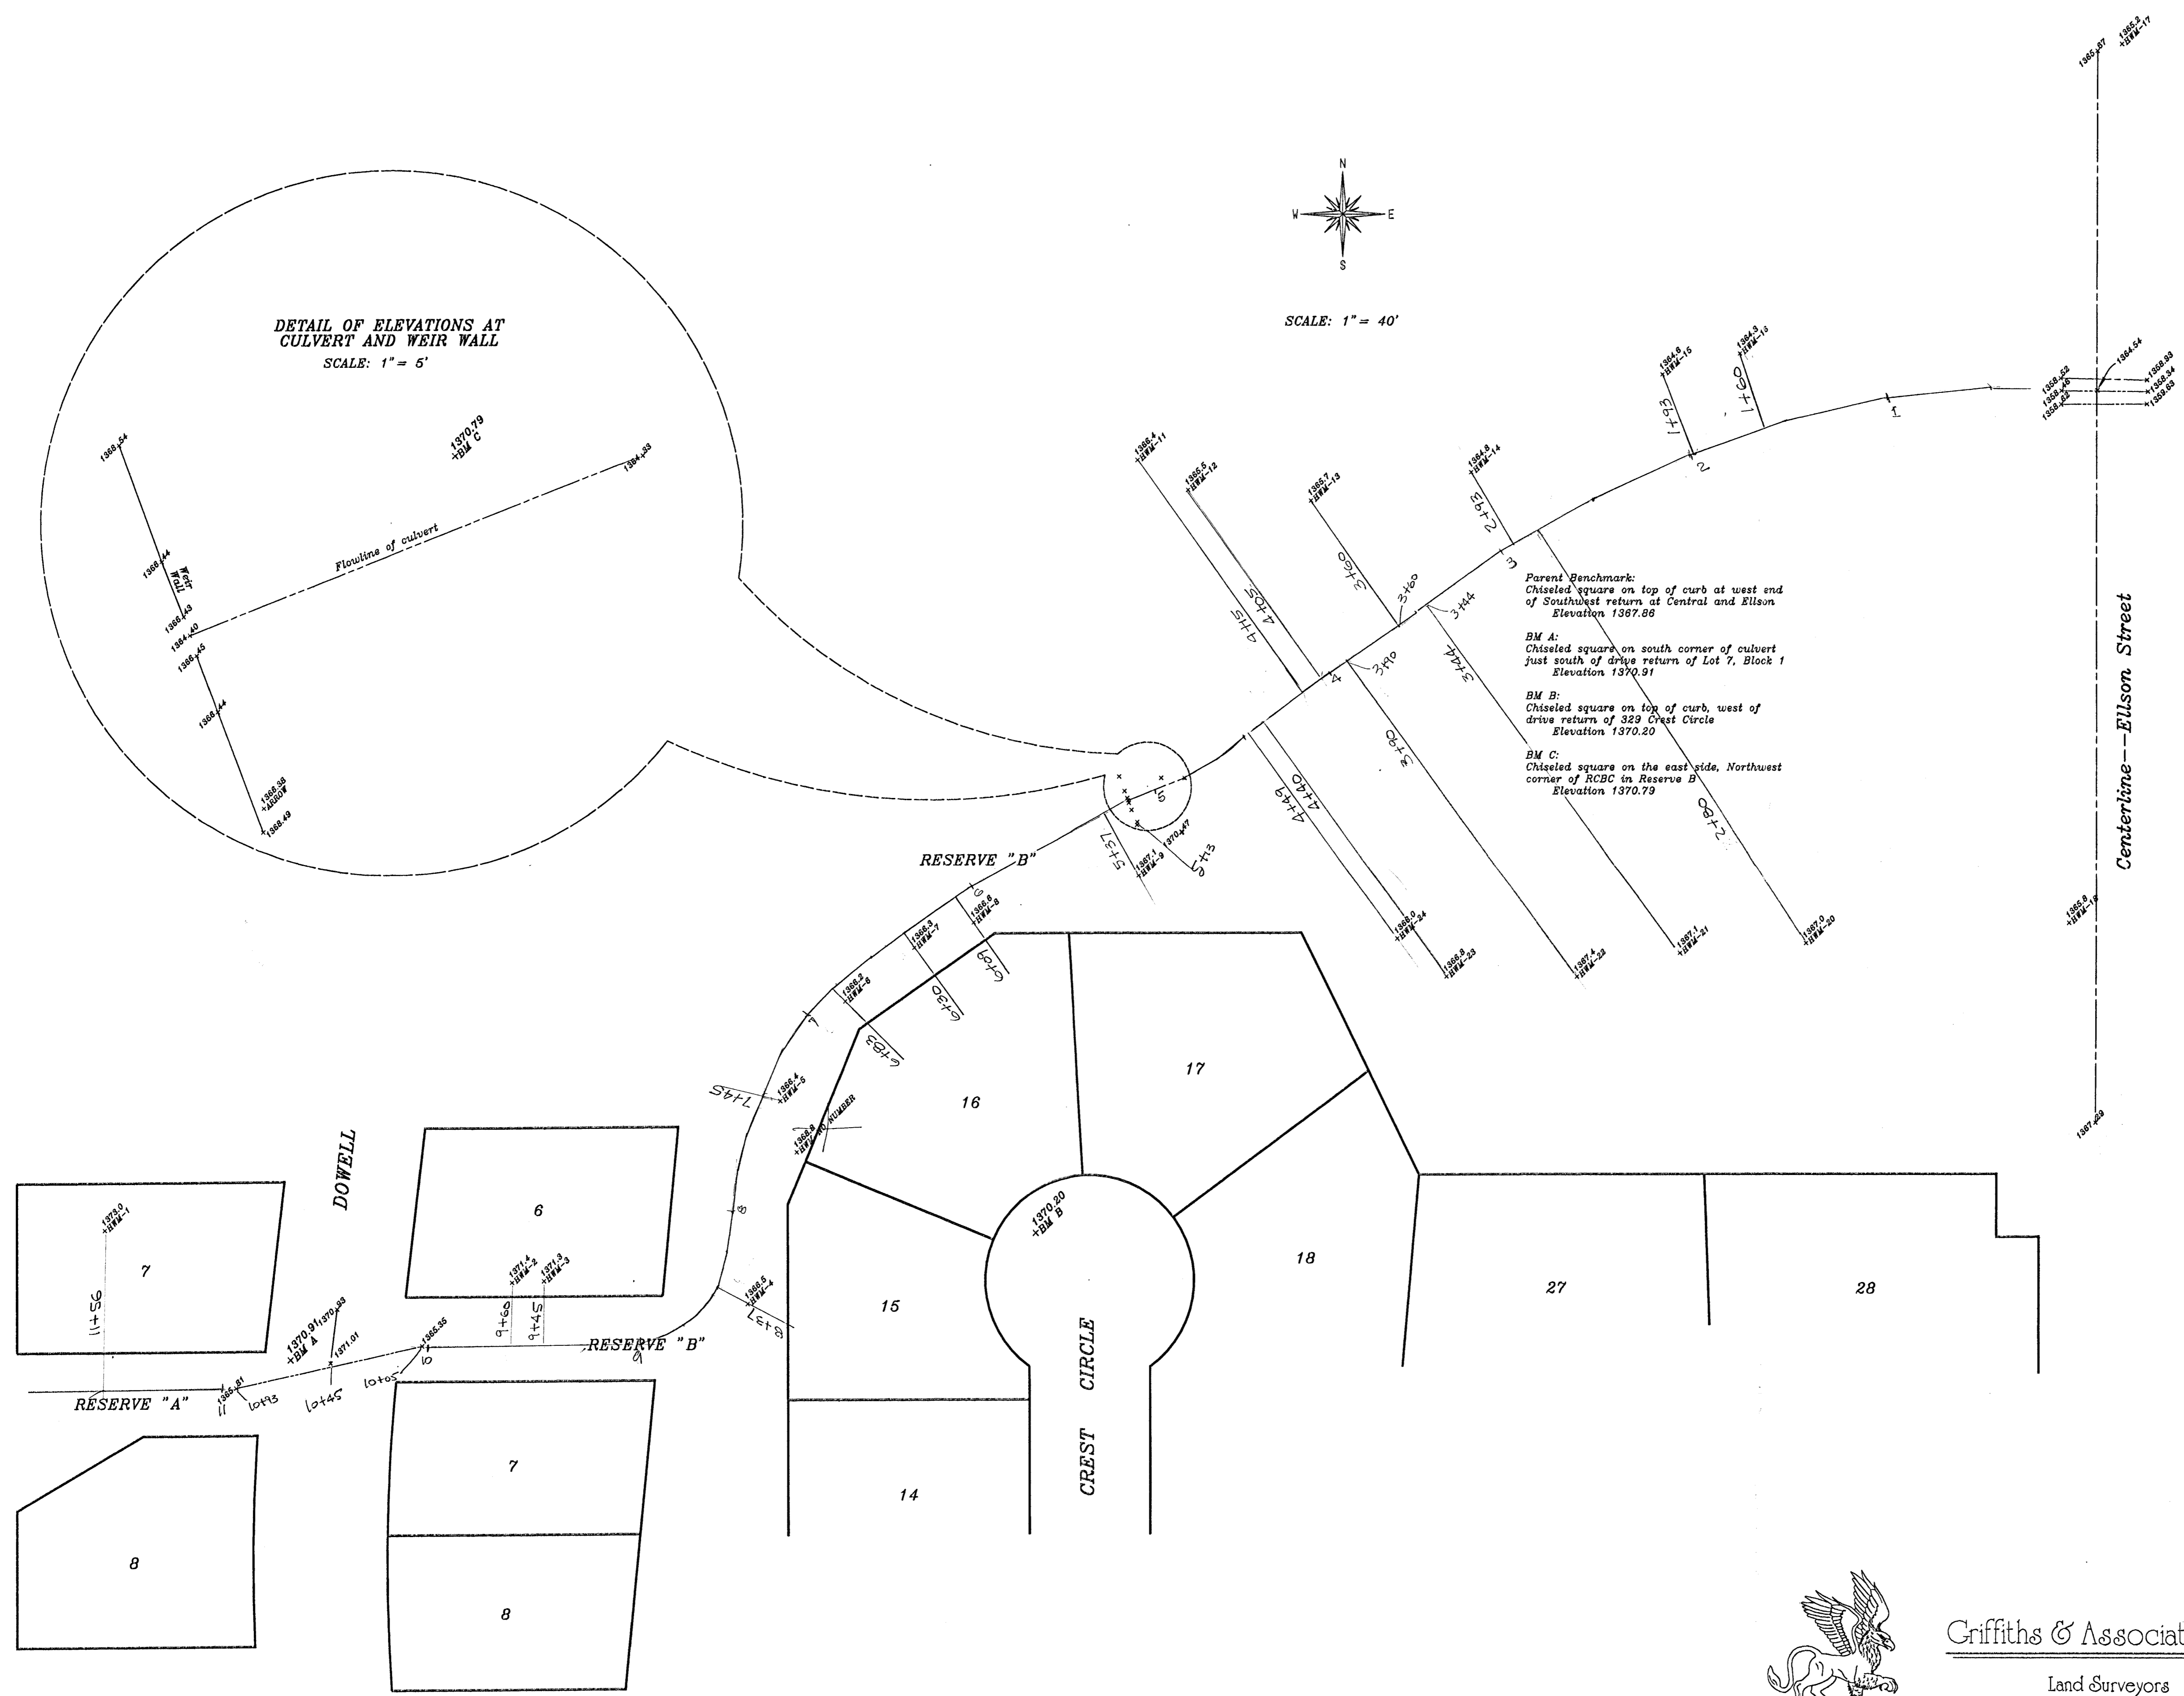

Griffiths & Associates, Inc.
Land Surveyors

1333 N. Broadway, Ste. A
Wichita, KS 67214
(316) 267-2900
fax (316) 267-4431