


# Drainage Exhibit

## 13th Street North

## Maize Road

## Ponderosa Circle

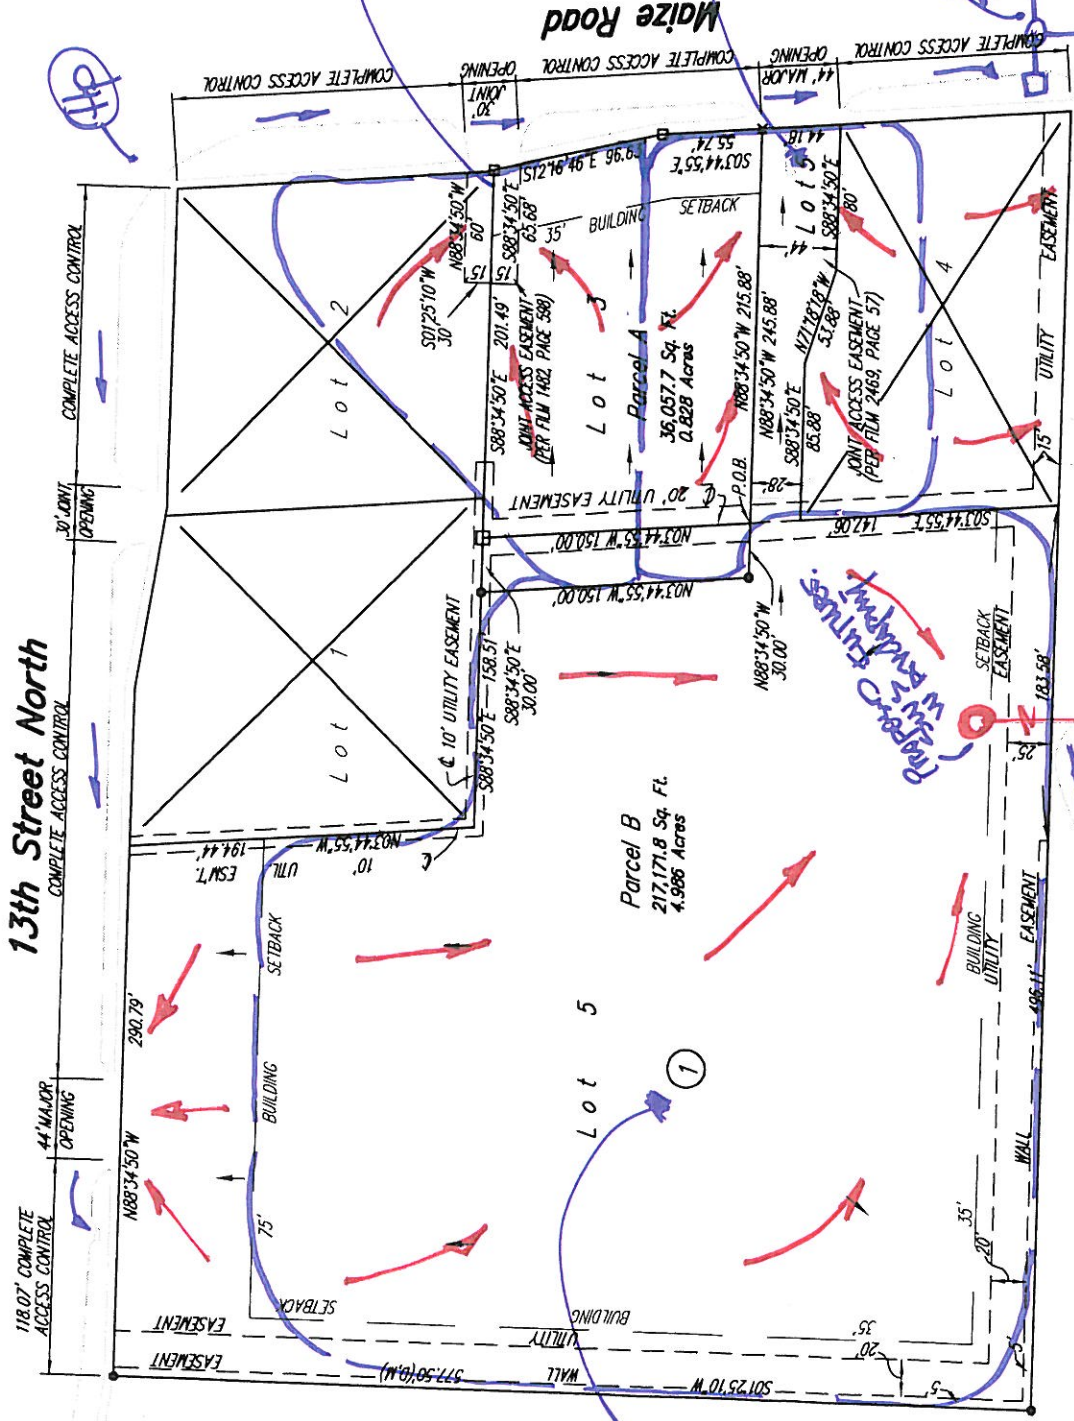

Project No. 07-08-PI194

**Baughman Company, P.A.**  
 315 Ellis St. Wichita, KS 67211 P 316-262-7271 F 316-262-0149  
**Baughman** ENGINEERING | SURVEYING | PLANNING | LANDSCAPE ARCHITECTURE

Drawing File: F:\SURVEY\LOT\BRANDT COMMERCIAL LOT 31.dwg | BRANDT-COM-LOT-3.dwg

Scale: 1" = 100'

Stormwater Sewer Line