NORTH STAR SECOND ADDITION
CITY OF WICHITA, SEDGWICK COUNTY, KANSAS

Part of the Southwest 1/4, Section 24, Township 27 South, Range 1 West of the 6th. P.M.

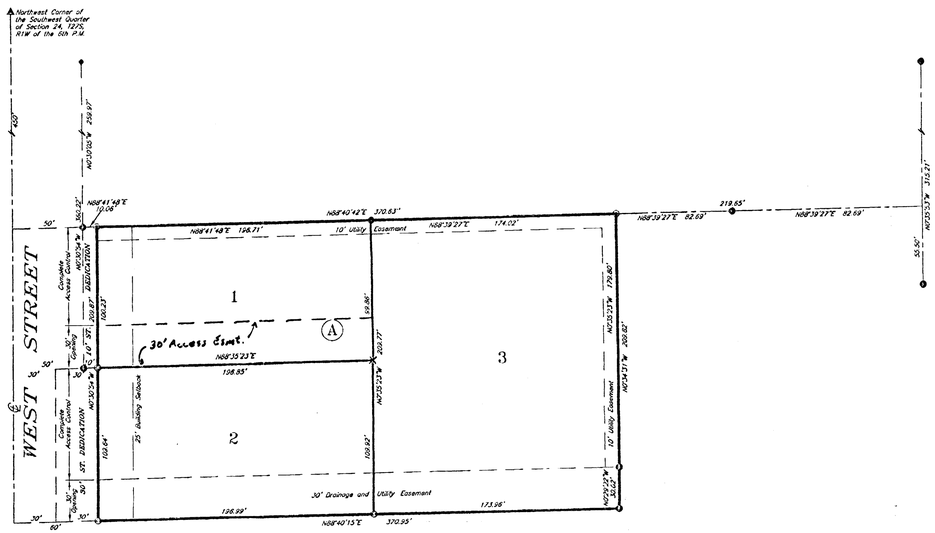
Northwest Corner of the Southwest Quarter of Section 24, T27S, R1W of the 6th P.M.
WEST STREET
1
2
3
A
30' Access Esmt.
10' Utility Easement
30' Drainage and Utility Easement
25' Building Setback
N88°41'48"E 110.05'
N88°40'42"E 370.83'
N88°41'48"E 198.71'
N88°39'27"E 174.02'
N88°39'27"E 82.69'
219.65'
N88°39'27"E 82.69'
N01°25'37"W 313.21'
55.50'
N88°35'23"E 138.85'
N01°25'37"W 109.86'
