




4-Corner Grading Plan CLEARIDGE ADDITION Wichita, Sedgwick County, Kansas

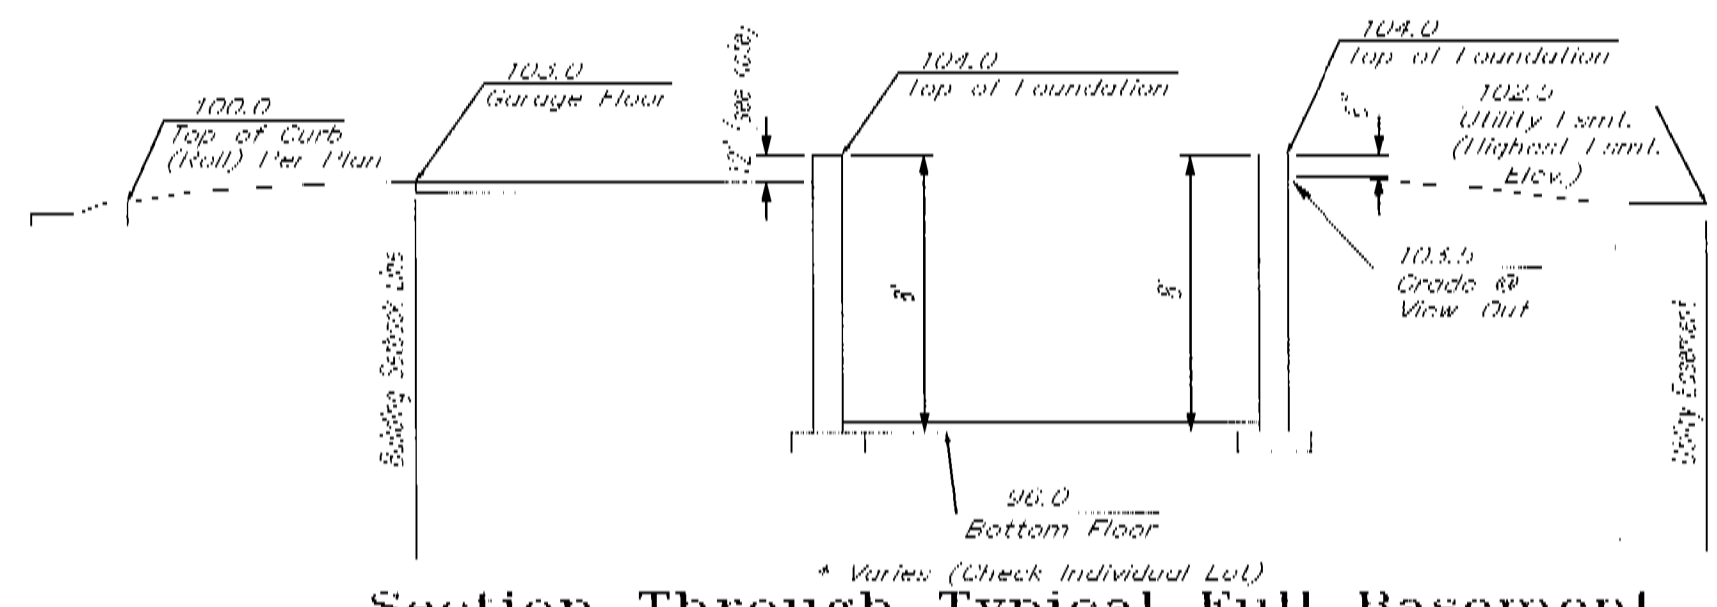

Section Through Typical Full Basement

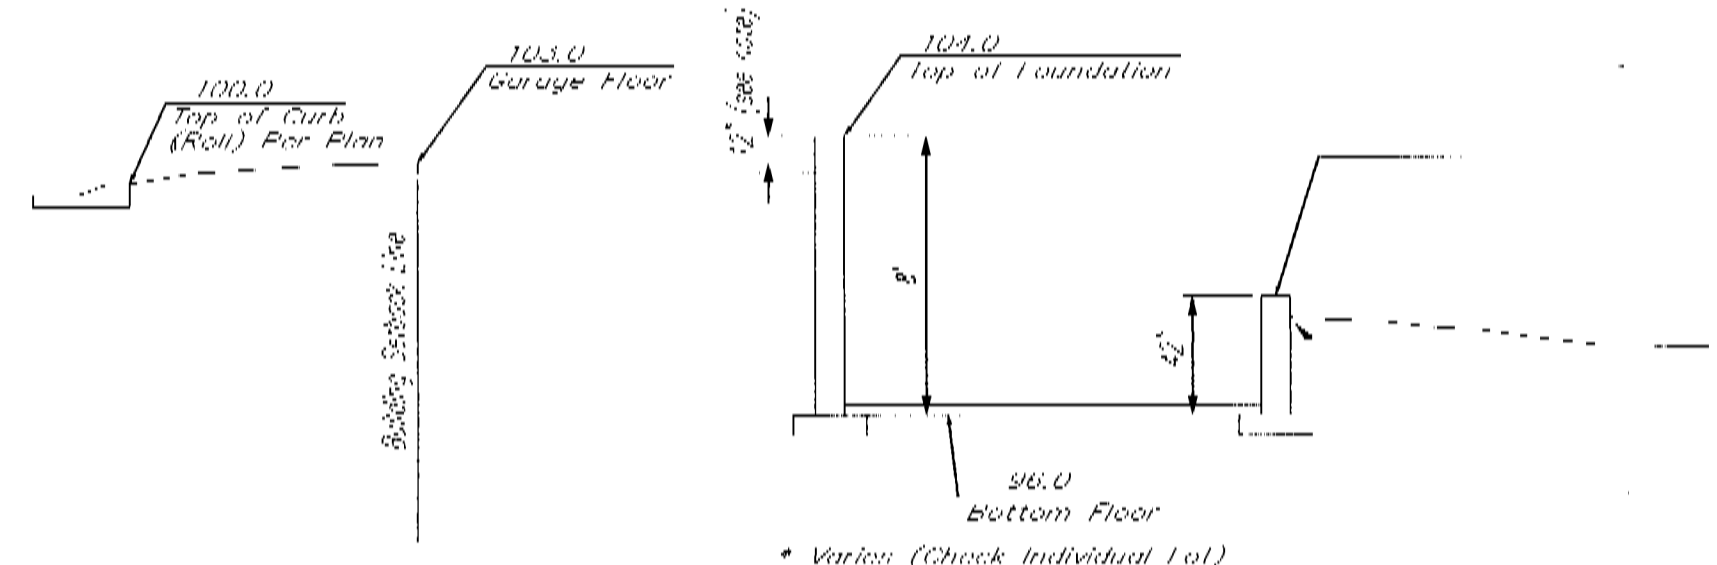



Section Through Typical View Out Lot

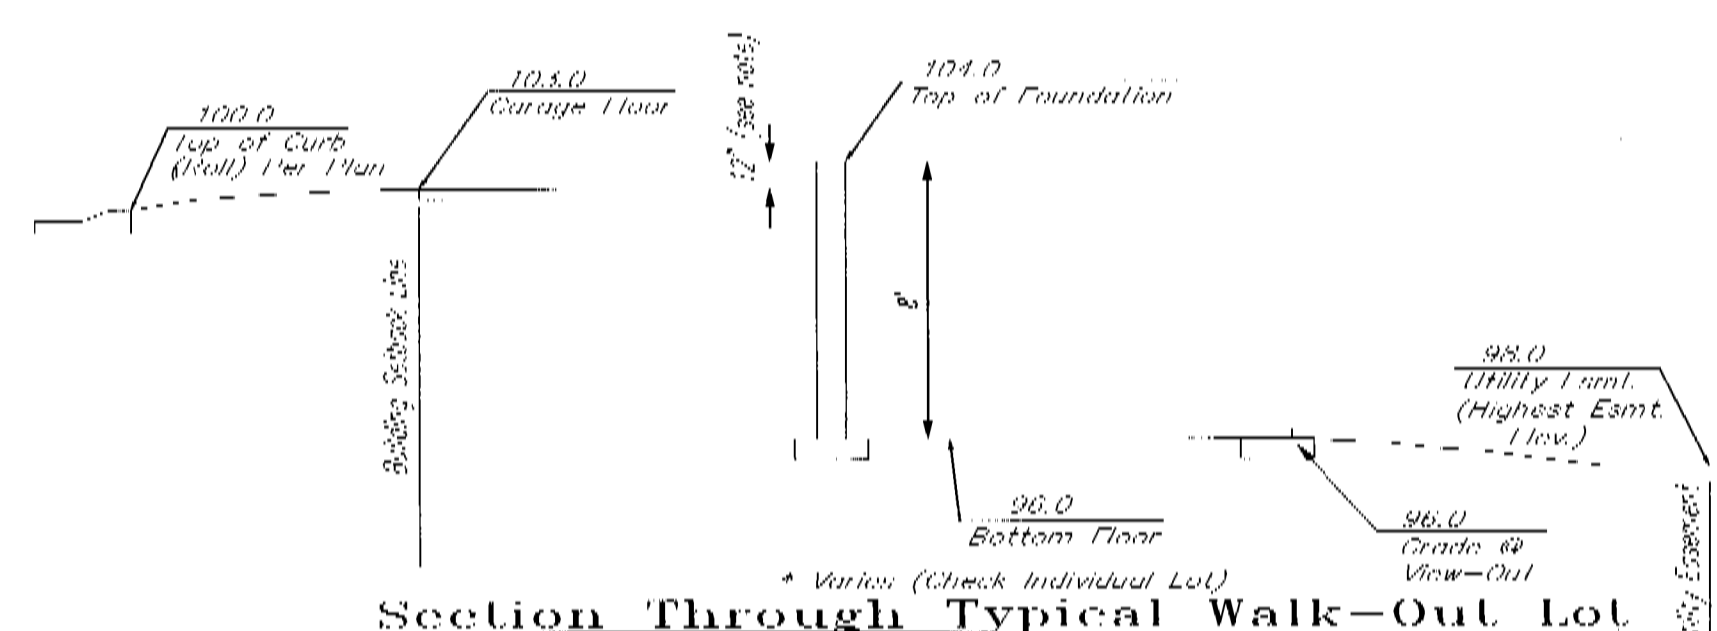

Section Through Typical Walk-Out Lot


Block	Lot No.	Height	Foundation
3	22, 24, 26, 28, 30, 32, 34	103.0	104.0
	36, 38, 40, 42, 44, 46, 48	103.0	104.0
	50, 52, 54, 56, 58, 60	103.0	104.0
4	1, 3, 5, 4		

4 Corner Grading Plan
CLEARIDGE ADDITION
 Wichita, Sedgwick County, Kansas

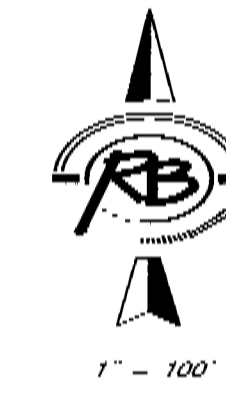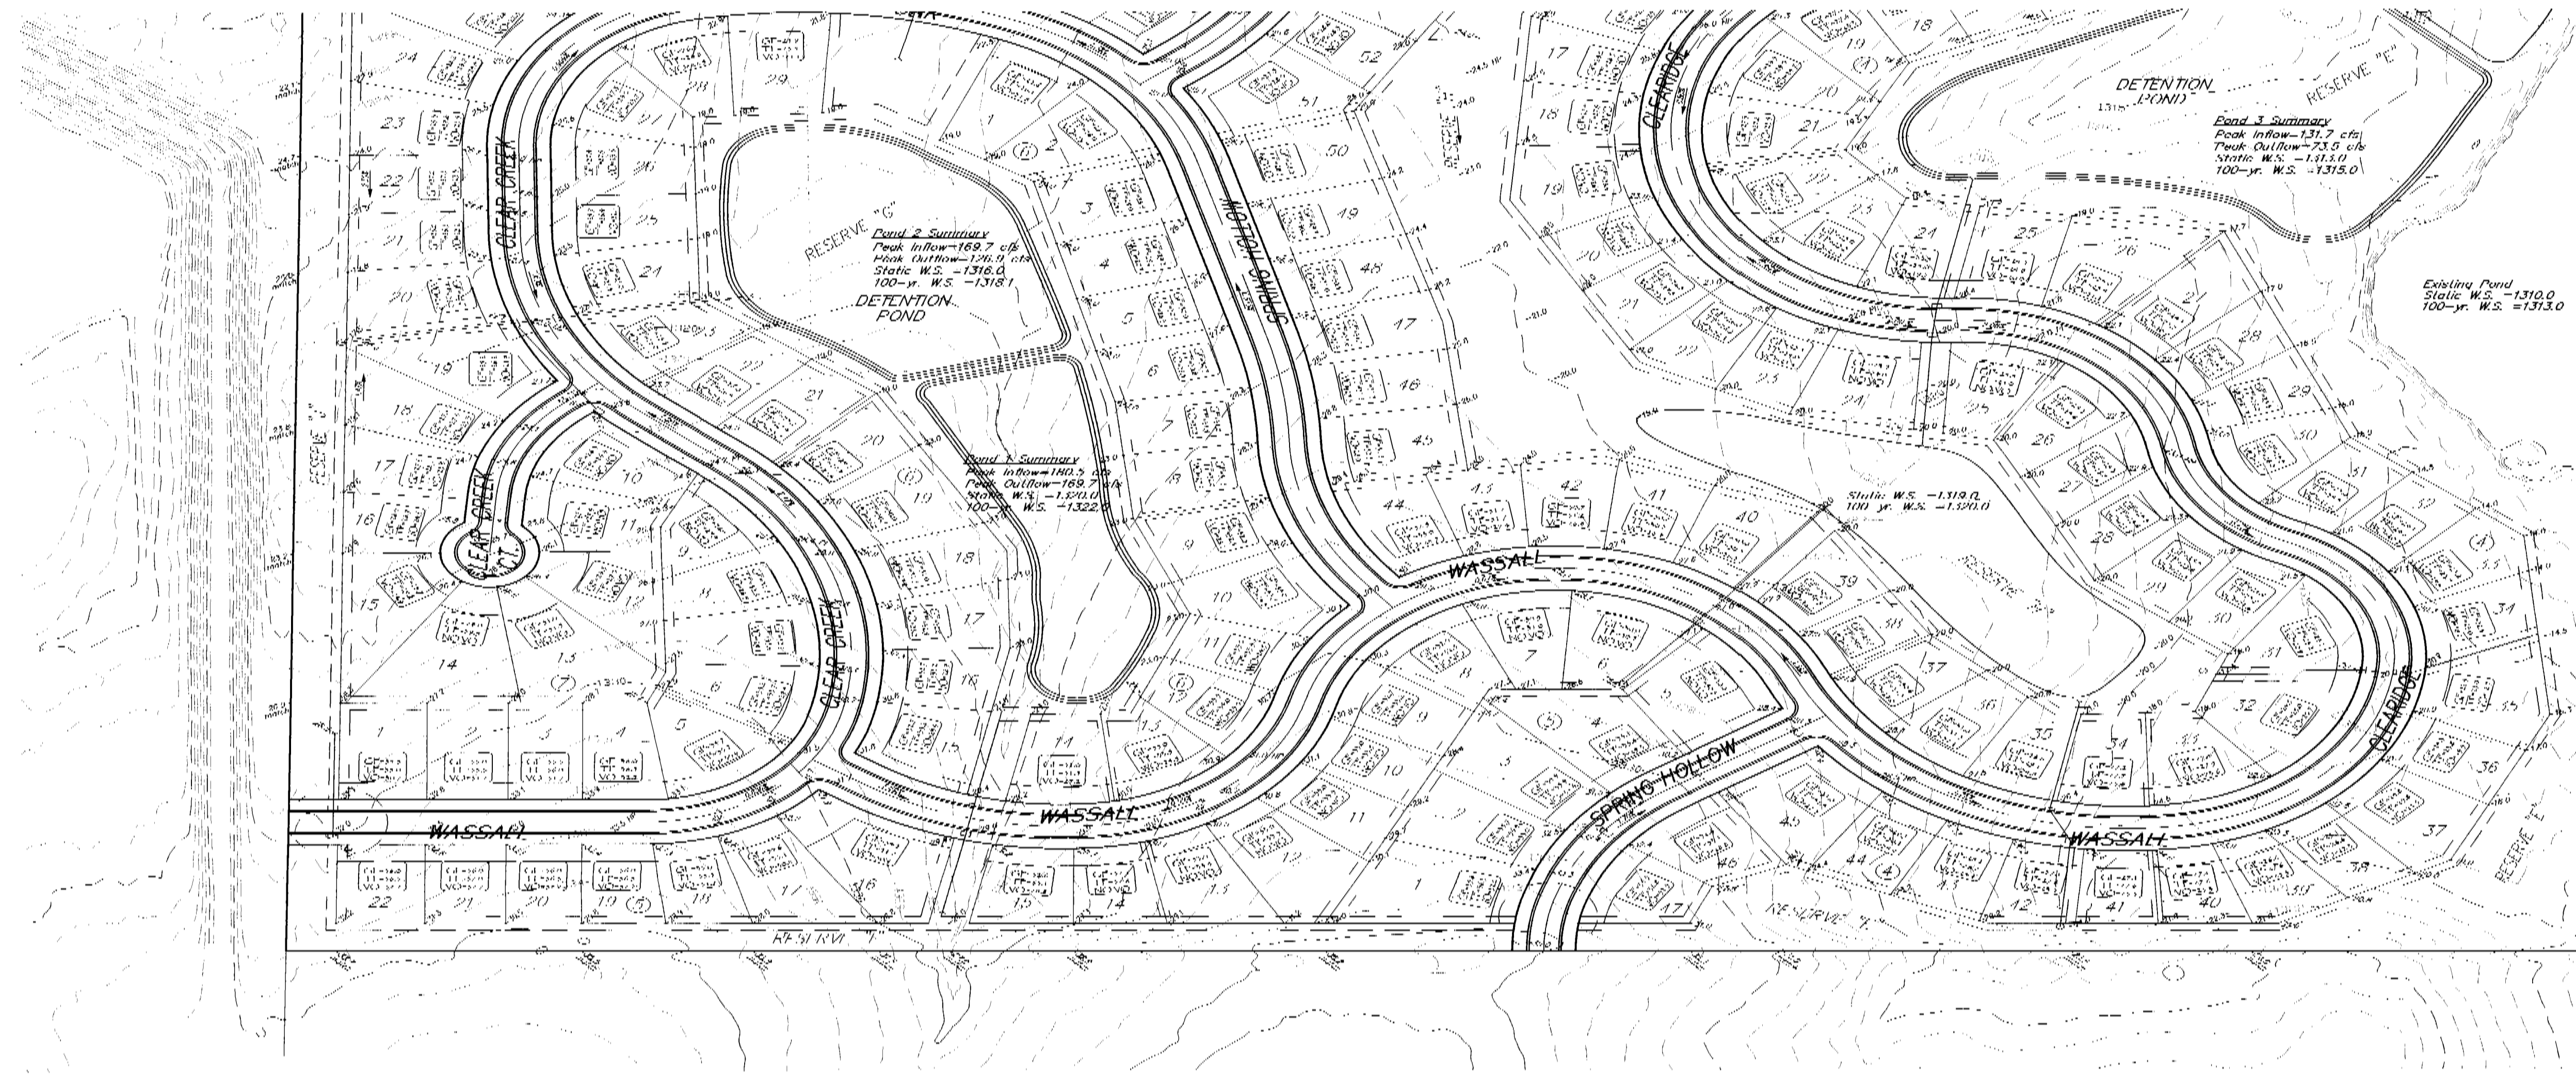














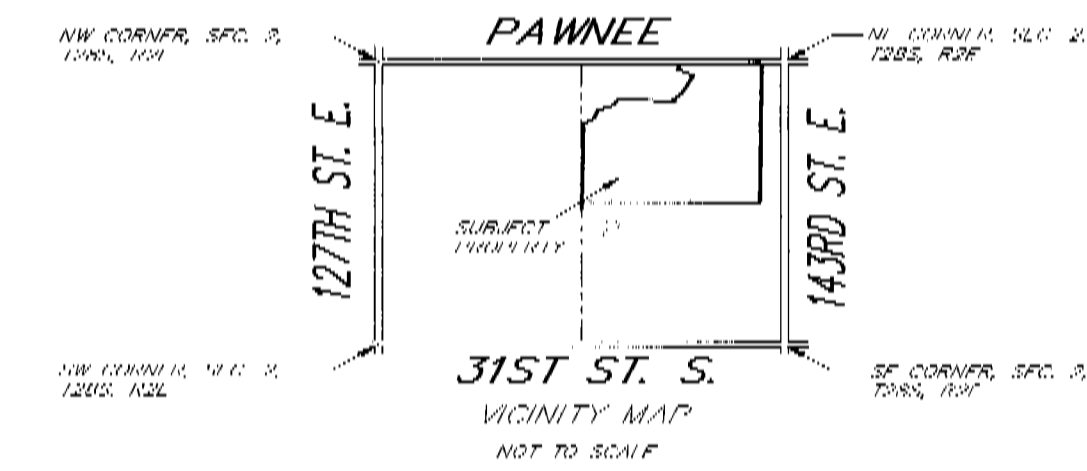


SHEET 2 OF 2

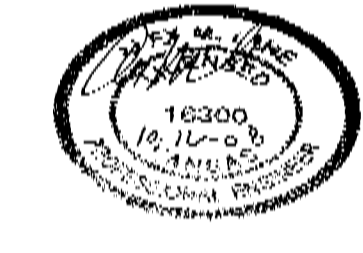


Ruggles & Bohm, P.A.
 Engineering, Surveying, Land Planning
 924 North Main
 Wichita, Kansas 67203
 www.rbkansas.com
 (316) 264-8008
 (316) 264-4621 fax
 E-mail: info@rbkansas.com


4 Corner Grading Plan CLEARIDGE ADDITION Wichita, Sedgwick County, Kansas

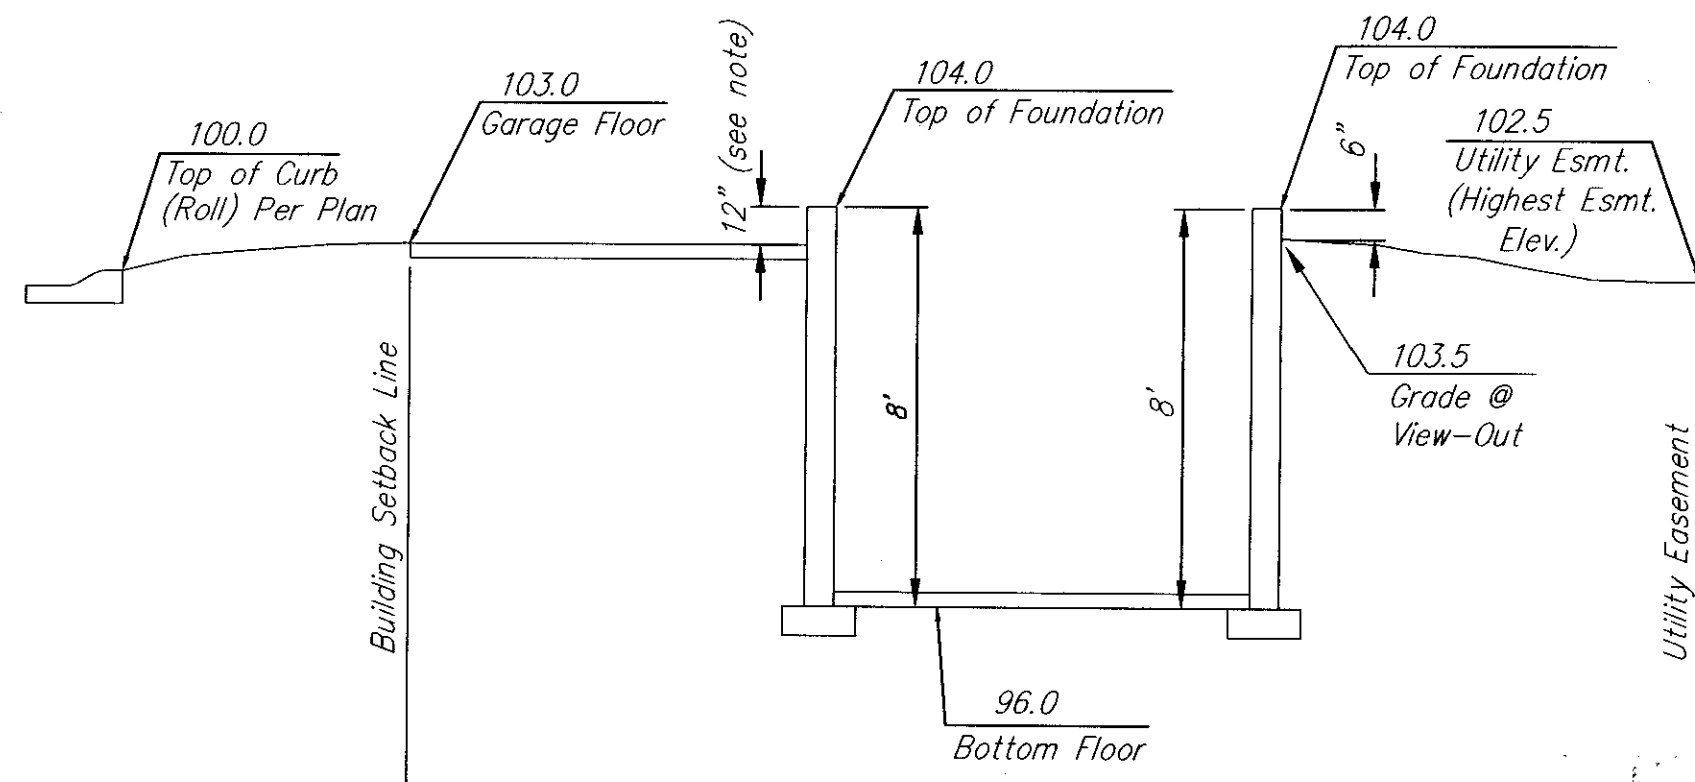

Section Through Typical Full Basement



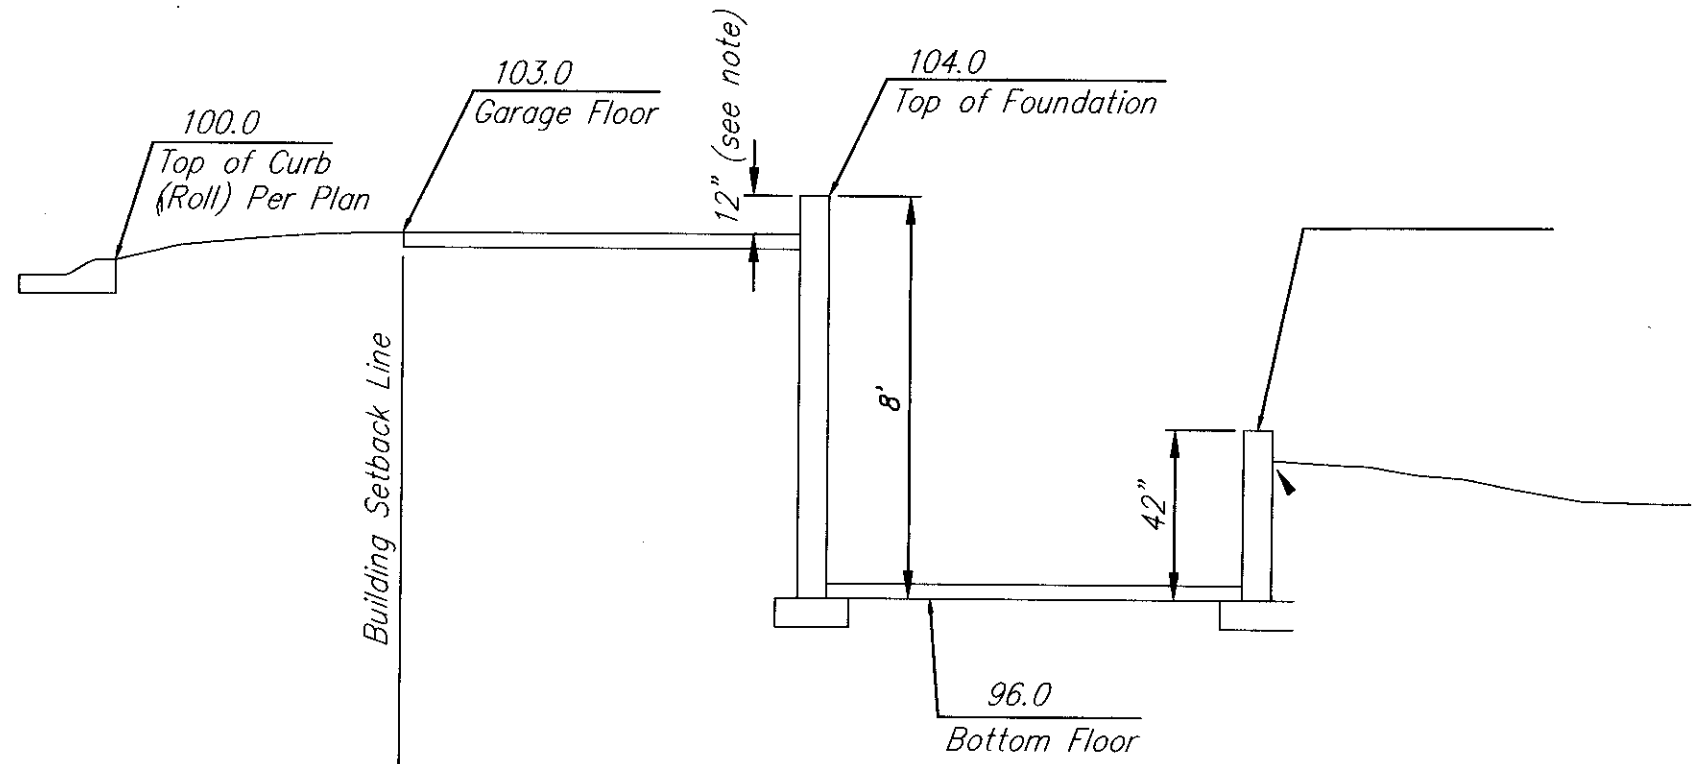


Section Through Typical View-Out Lot


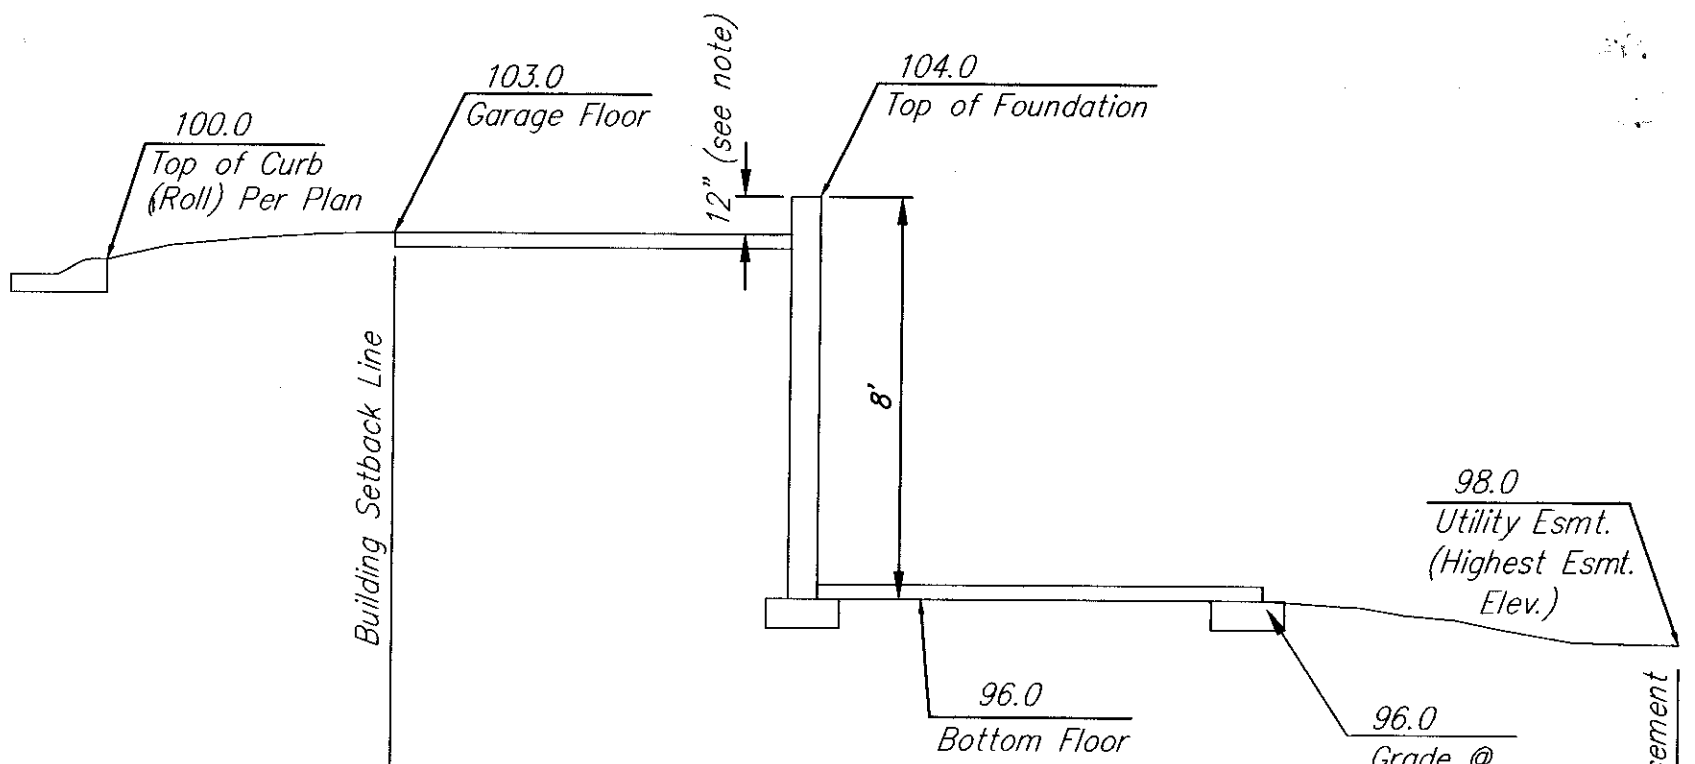


Section Through Typical Walk-Out Lot



BLOCK	LOT NO.	ELEVATION (NGVD29)
4	13, 14, 15, 16, 17, 18, 19, 20, 21, 22, 23, 24, 25, 26, 27, 28	1317.0
6	1, 2, 3, 4, 5, 21, 22, 23, 24, 25, 26, 27, 28, 29	1320.0
6	6, 7, 8, 9, 10, 11, 12, 13, 14, 15, 16, 17, 18, 19, 20	1324.0
7	28, 29, 30	1319.0
7	31	1317.0
7	32	1315.0
7	33, 34, 35, 36, 37, 28, 39, 40, 41, 42, 43, 44	1314.7
7	45, 46, 47, 48, 49, 50	1314.4
7	51, 52, 53	1314.2

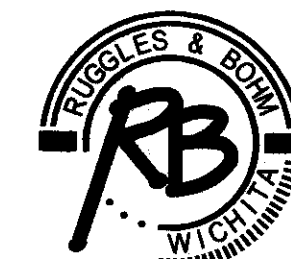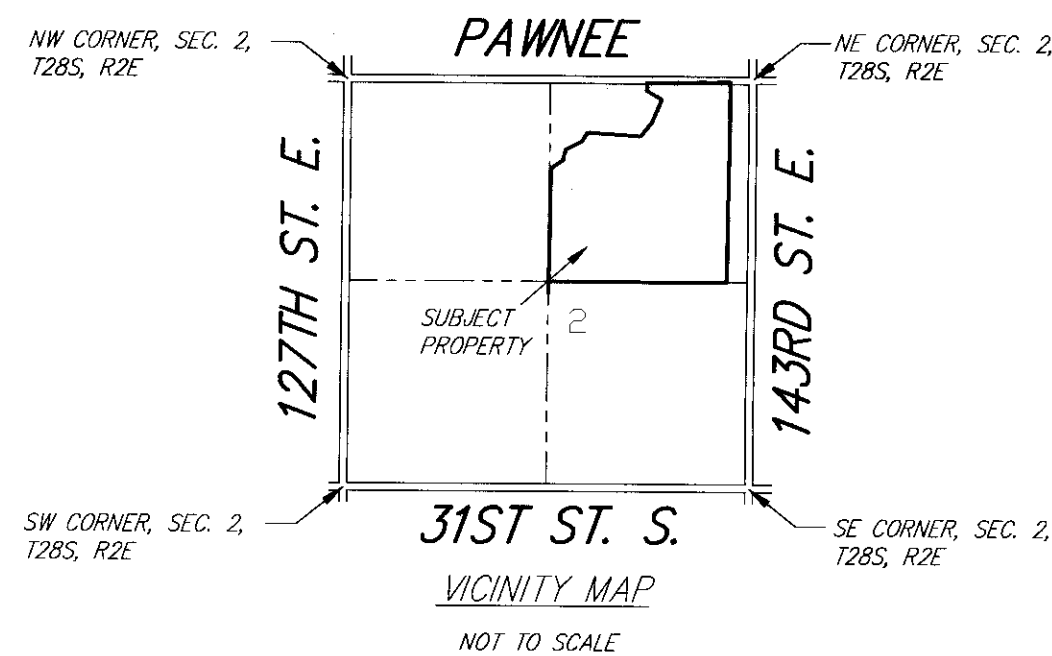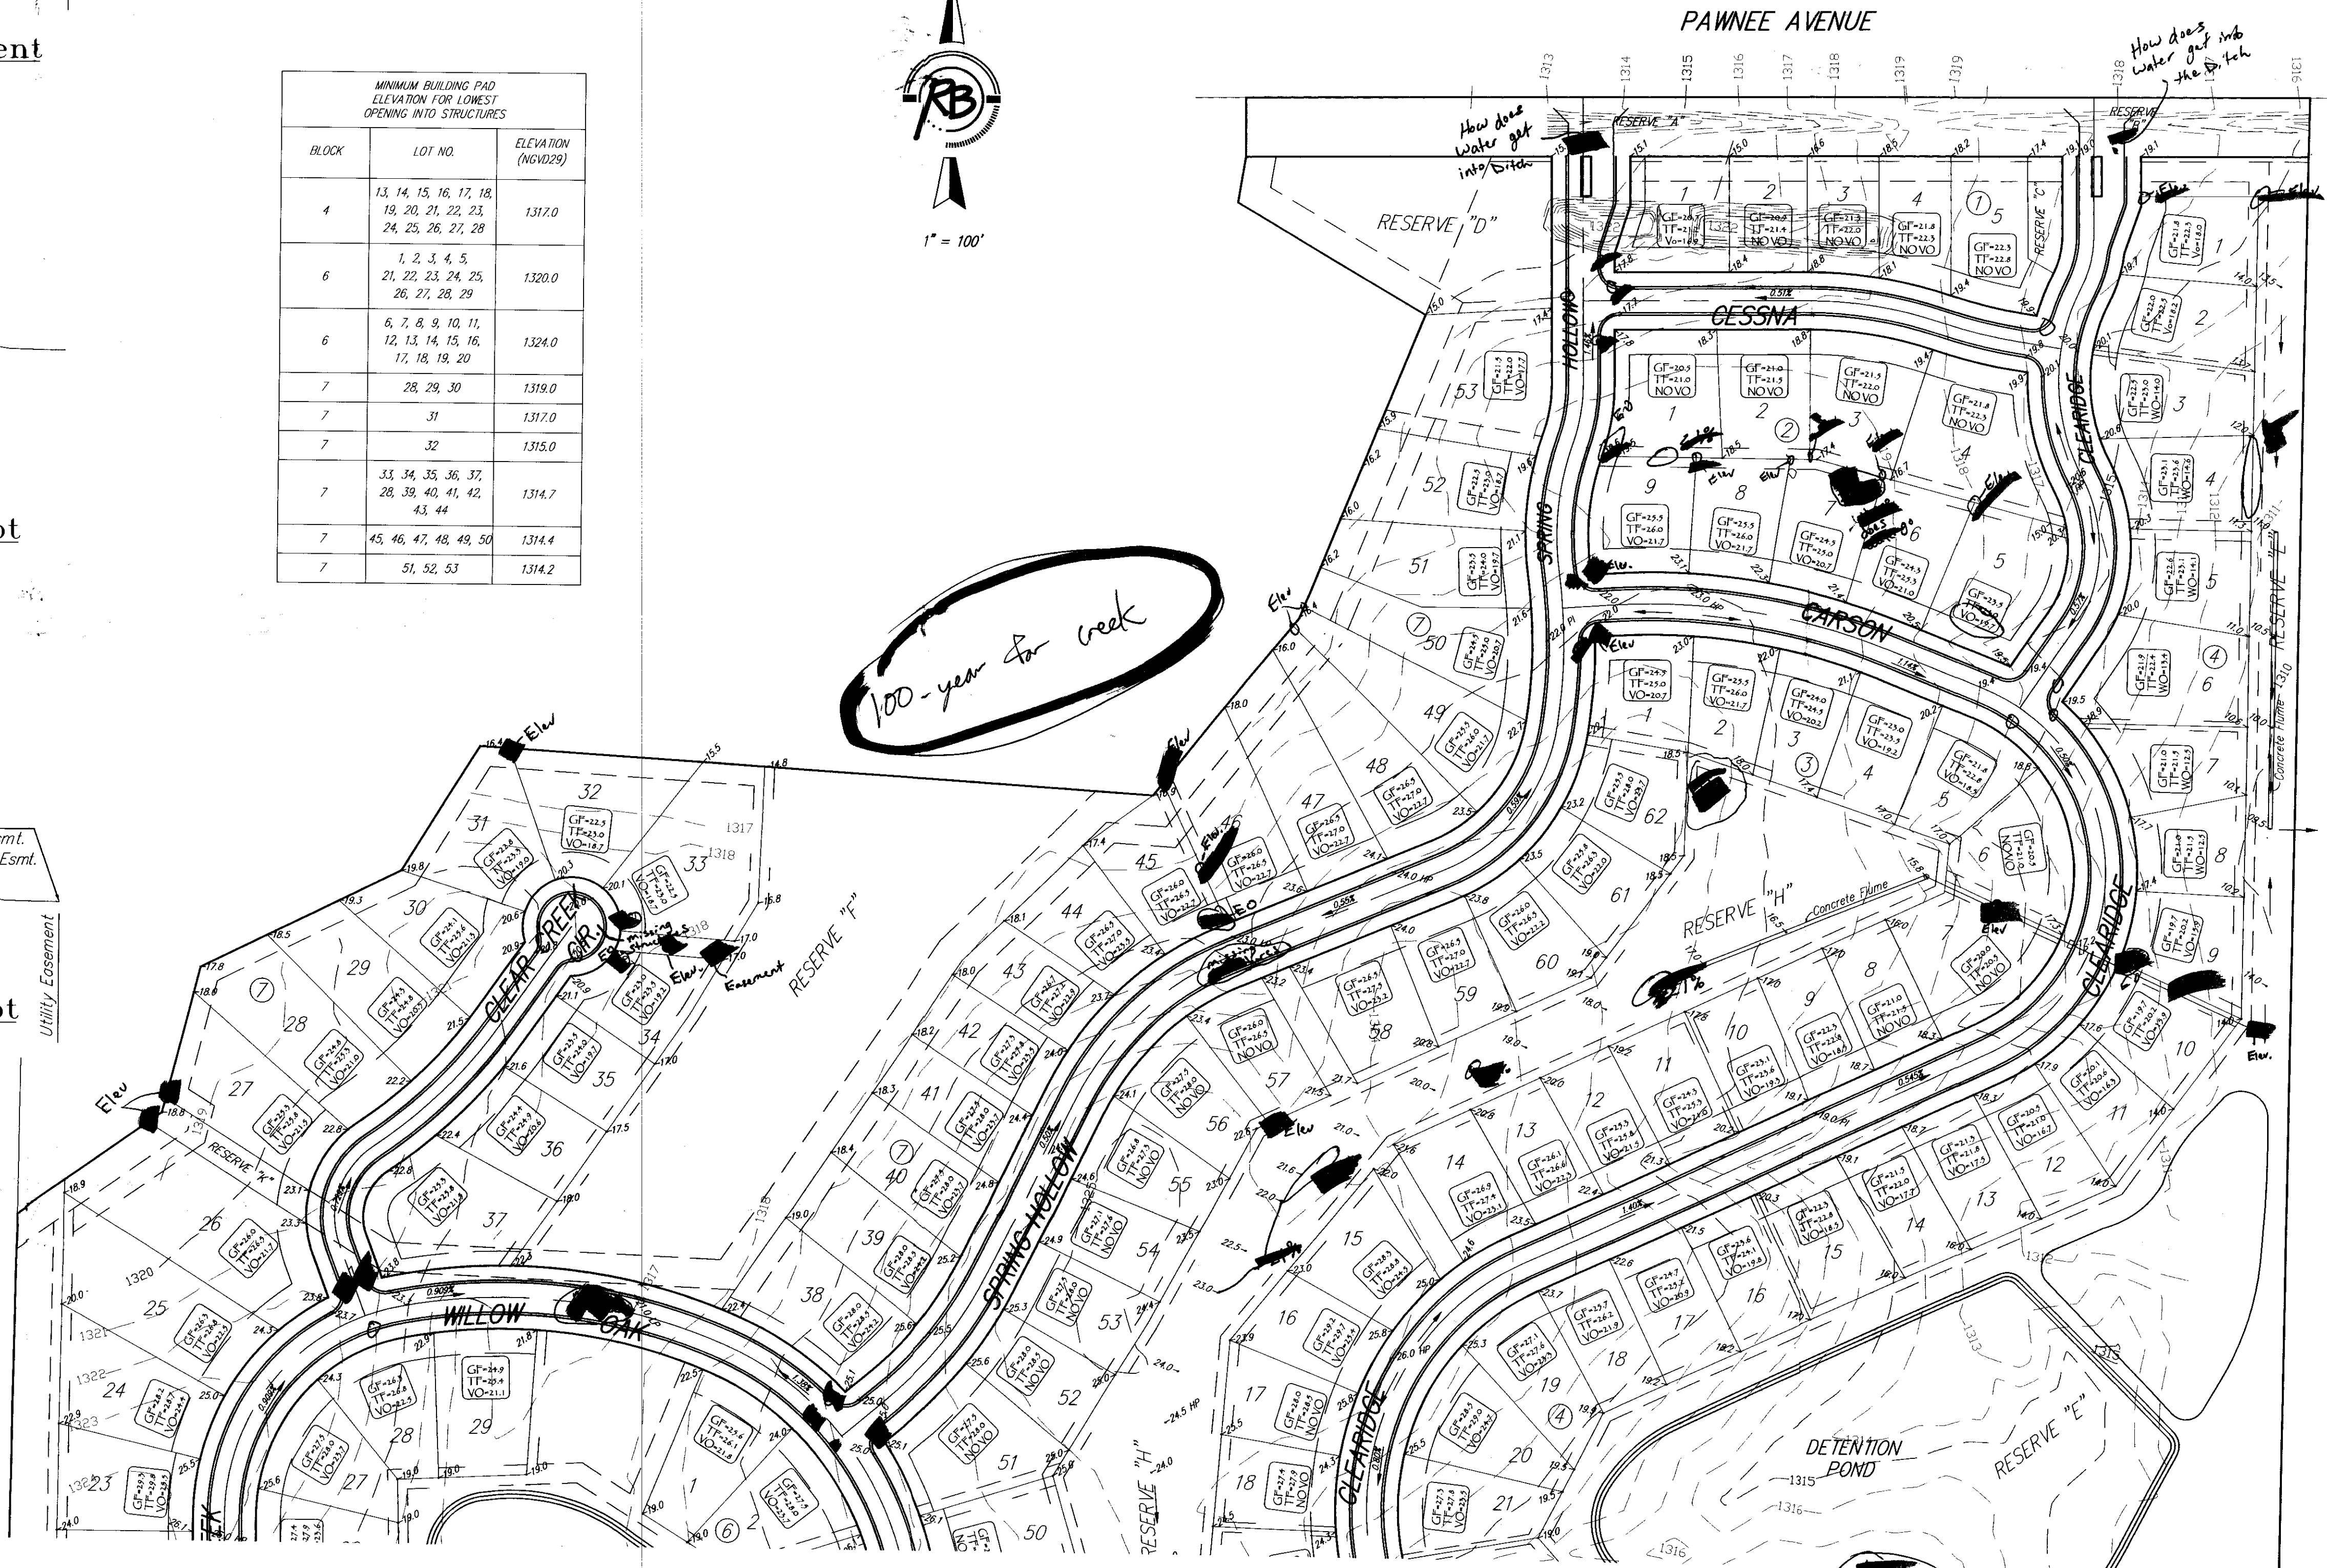


4 Corner Grading Plan CLEARIDGE ADDITION Wichita, Sedgwick County, Kansas

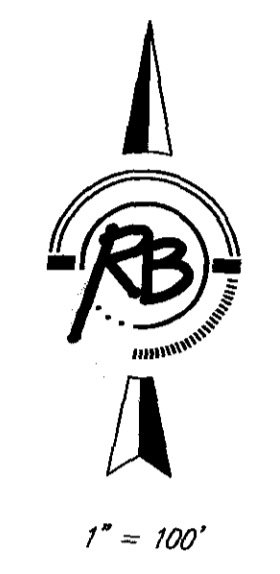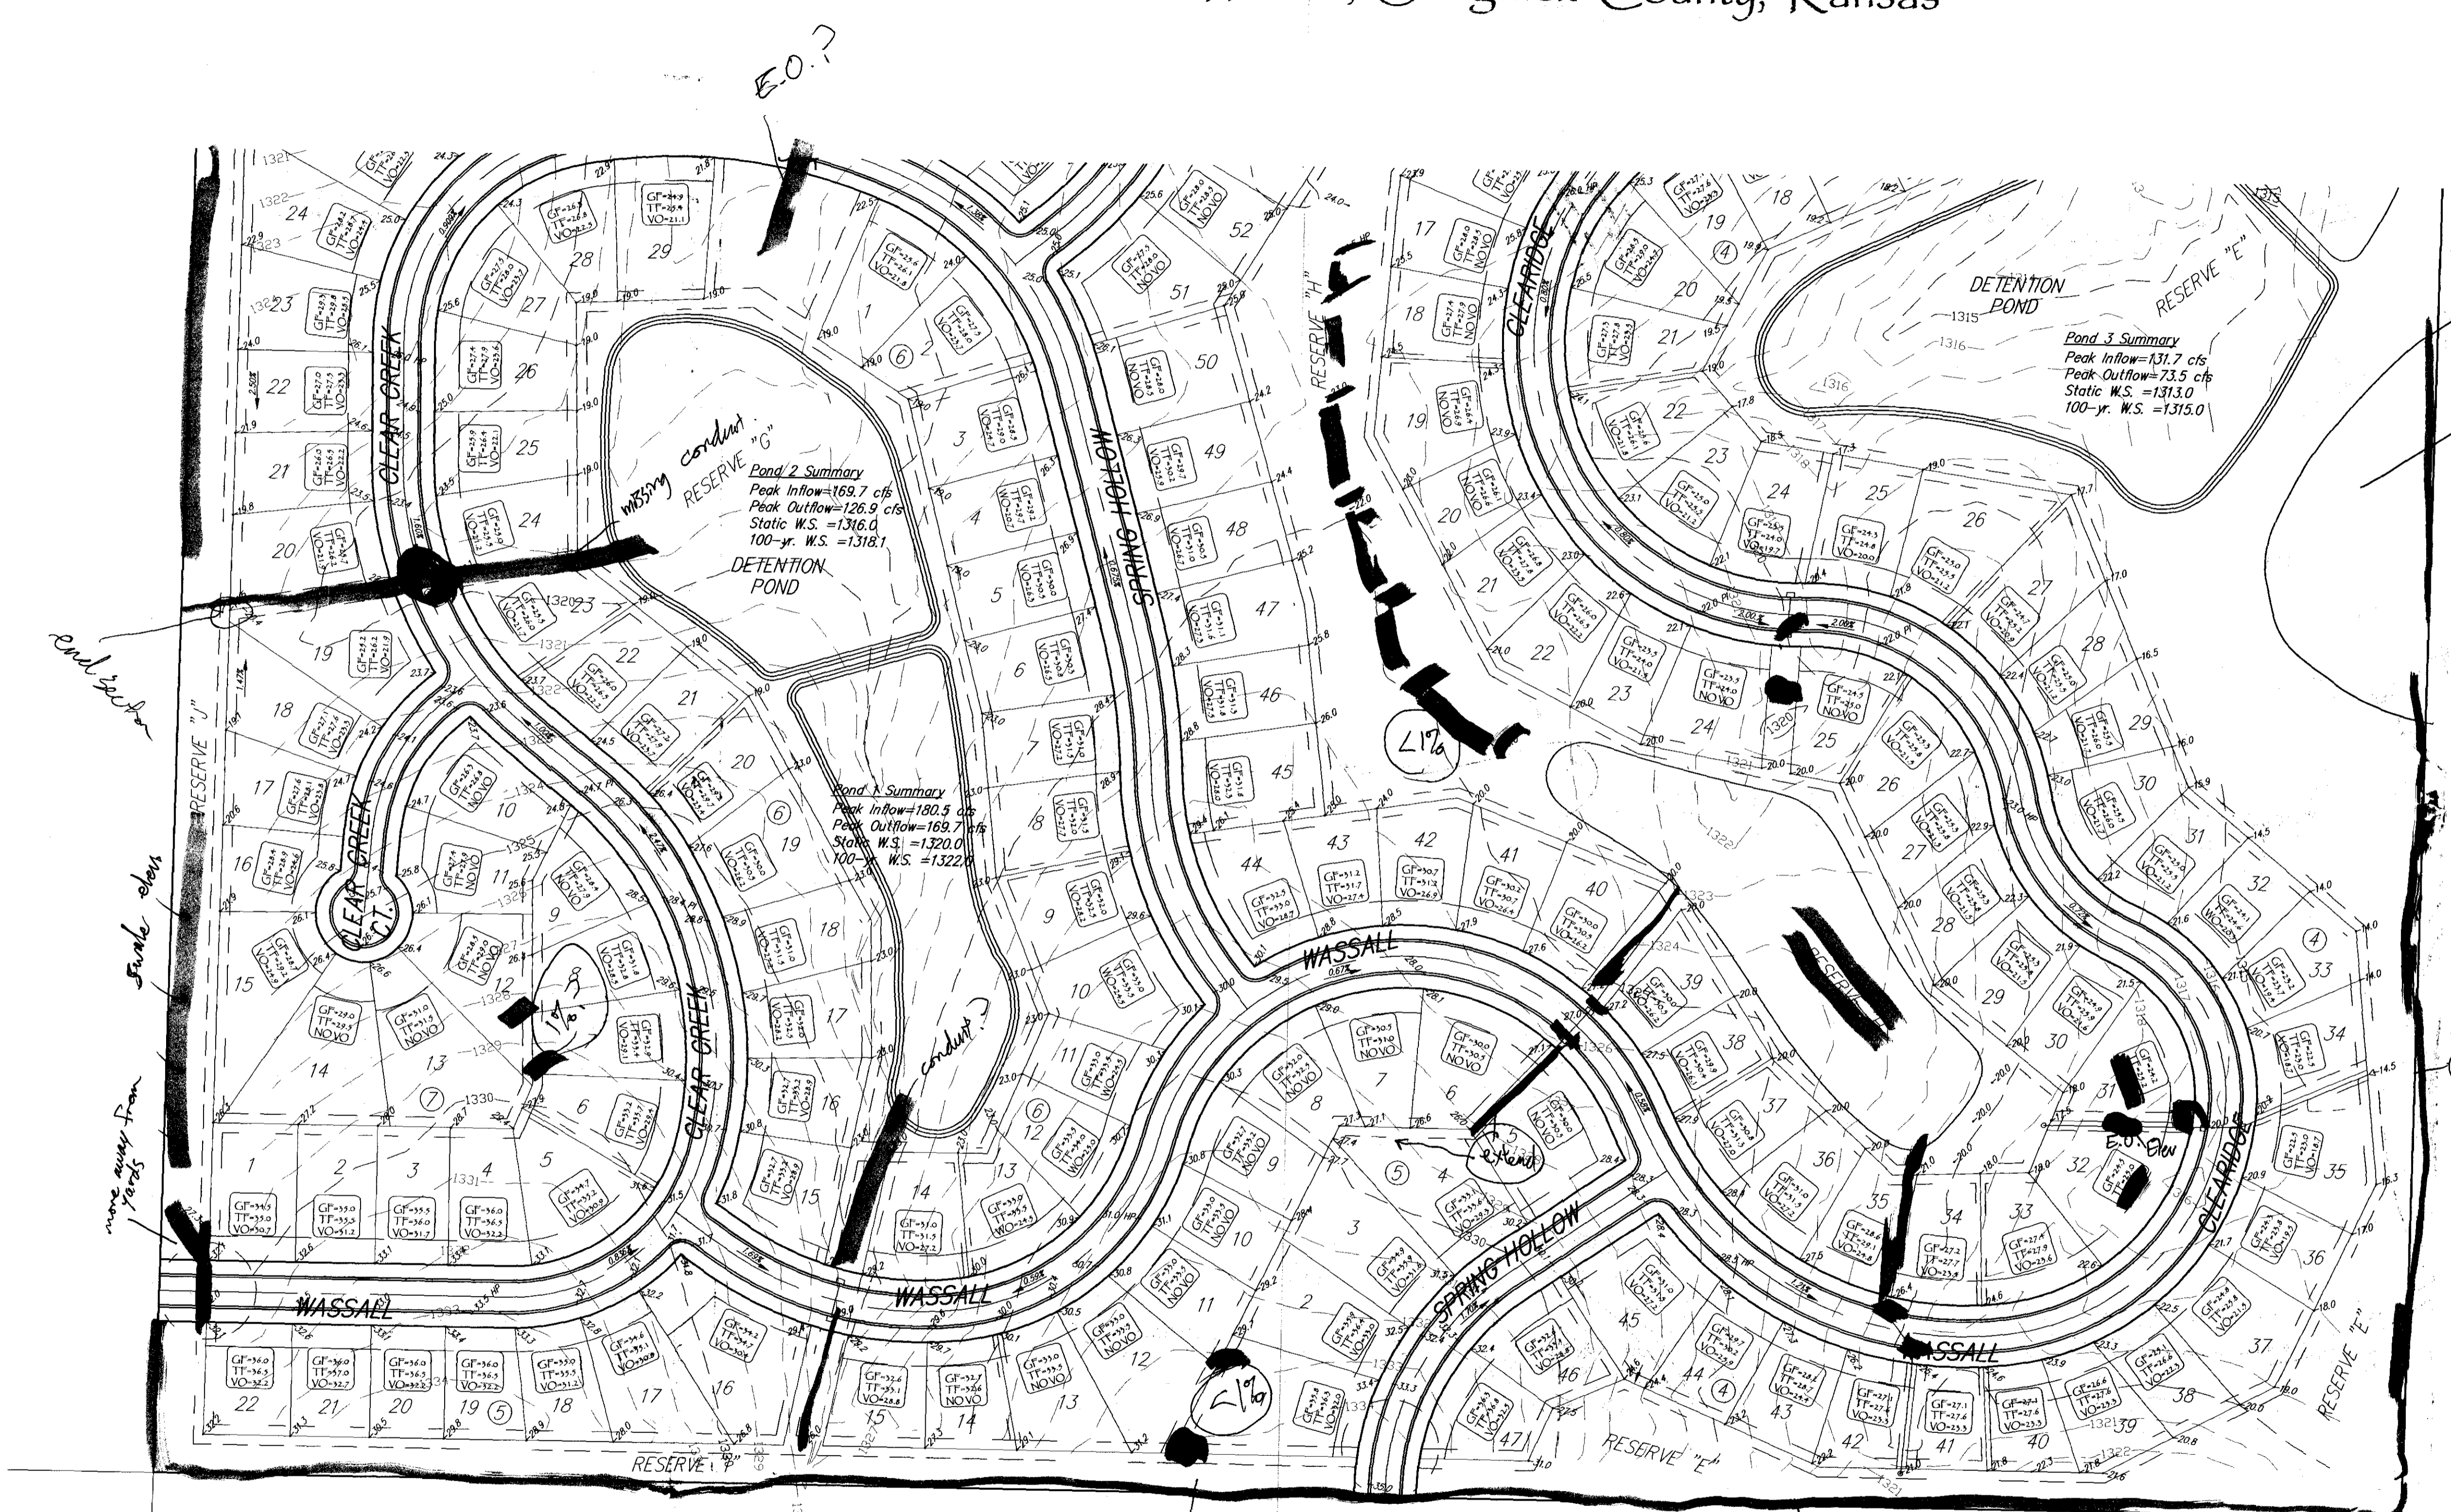


BLOCK	LOT NO.	ELEVATION (NGVD29)		
4	13, 14, 15, 16, 17, 18, 19, 20, 21, 22, 23, 24, 25, 26, 27, 28	1317.0		
	6	1, 2, 3, 4, 5, 21, 22, 23, 24, 25, 26, 27, 28, 29	1320.0	
		6	6, 7, 8, 9, 10, 11, 12, 13, 14, 15, 16, 17, 18, 19, 20	1324.0
			7	28, 29, 30
31				1317.0
7	32		1315.0	
	7	33, 34, 35, 36, 37, 28, 39, 40, 41, 42, 43, 44	1314.7	
7		45, 46, 47, 48, 49, 50	1314.4	
		51, 52, 53	1314.2	

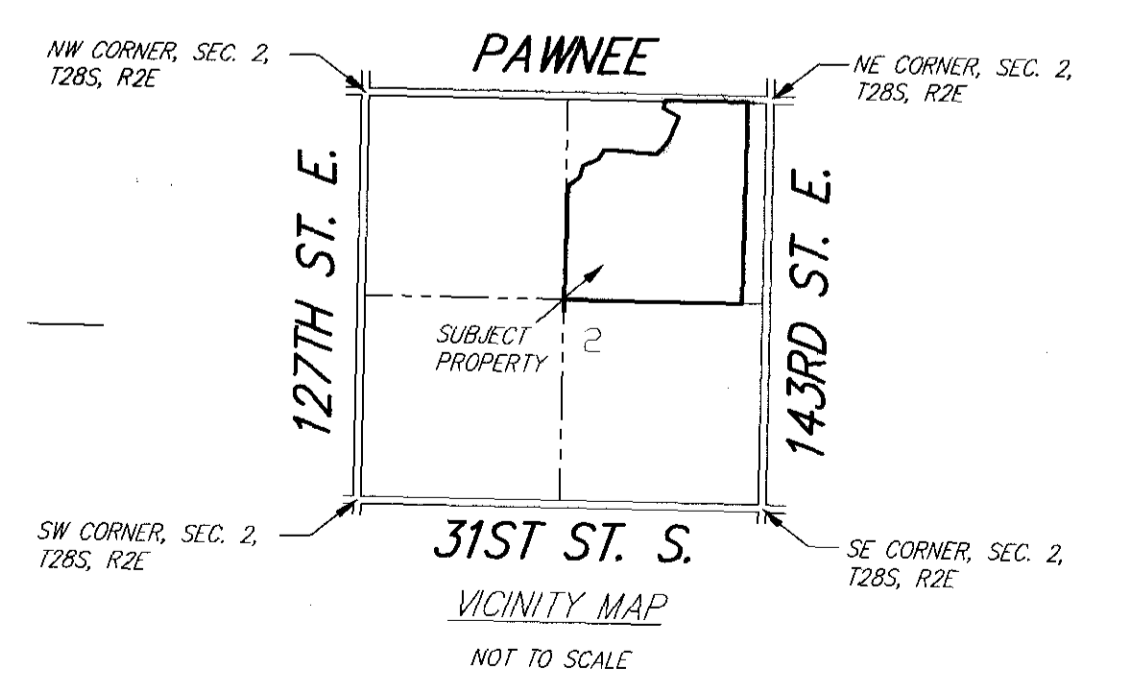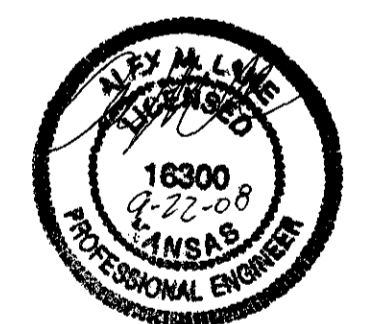


4 Corner Grading Plan CLEARIDGE ADDITION Wichita, Sedgwick County, Kansas

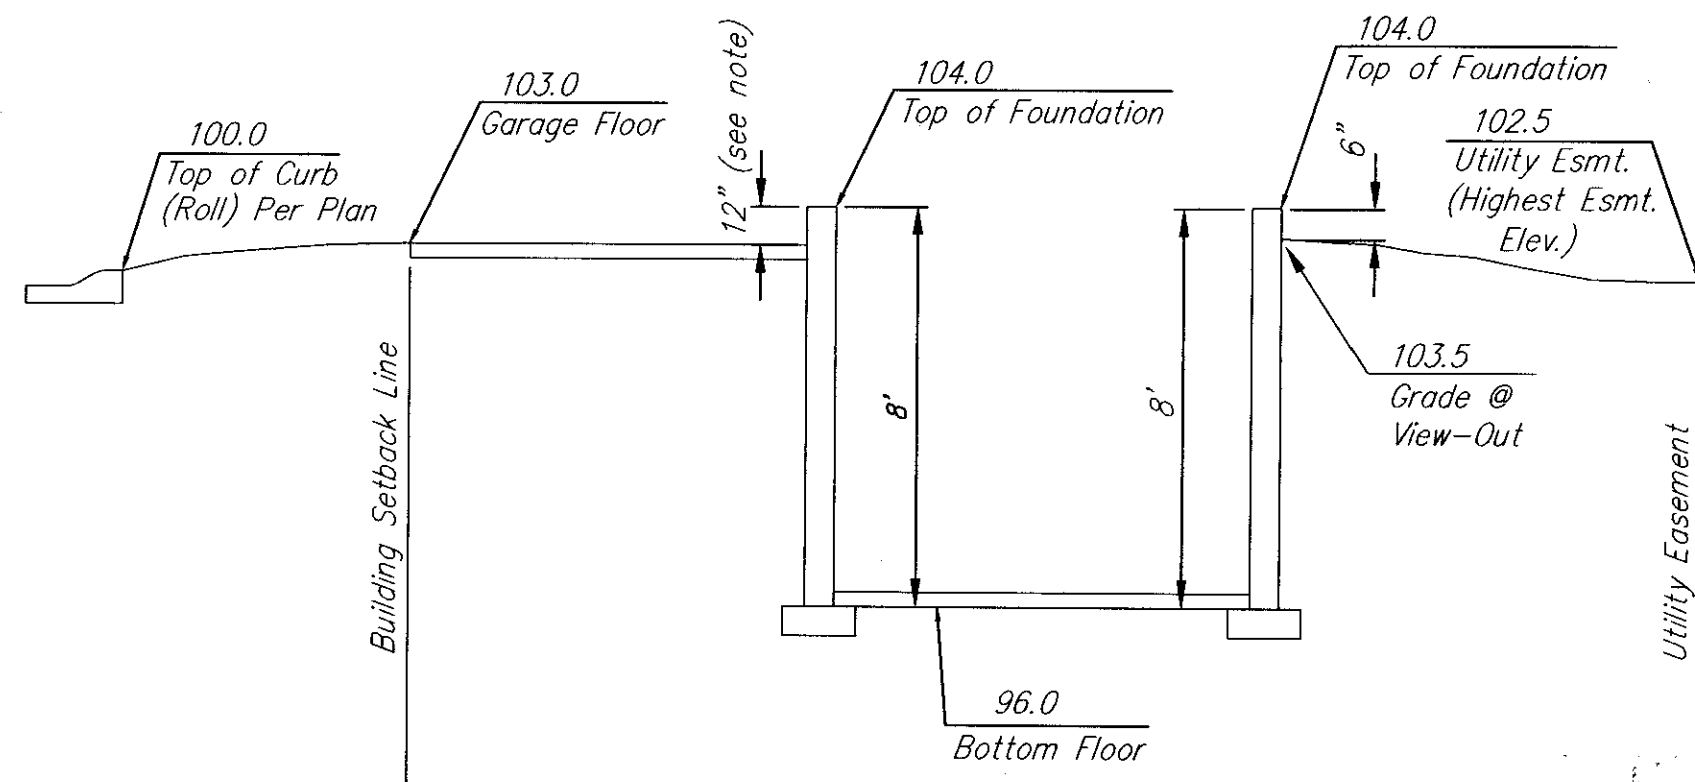

Section Through Typical Full Basement

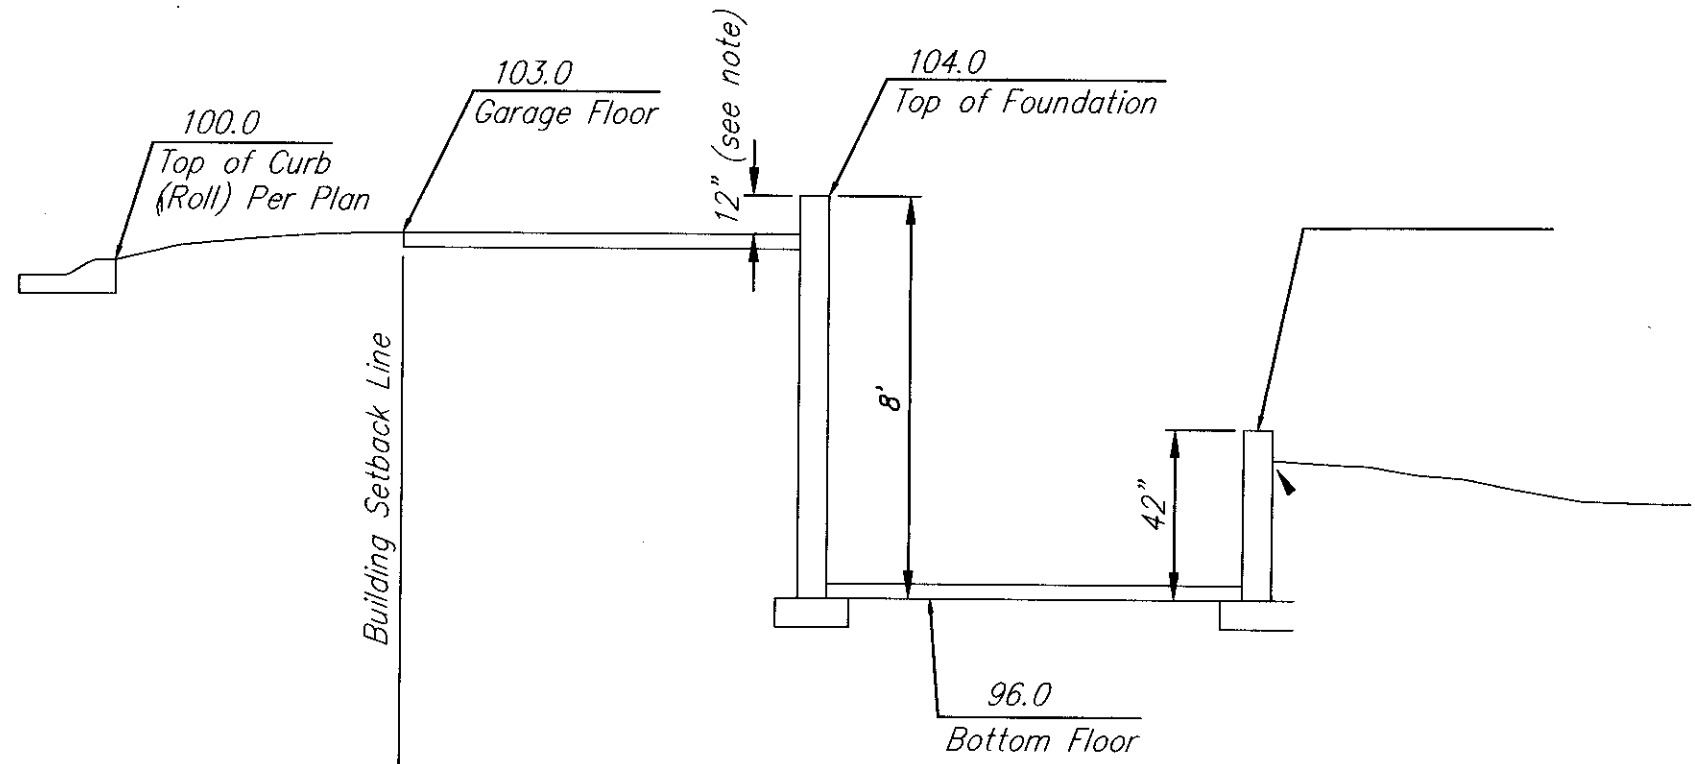

Section Through Typical View-Out Lot

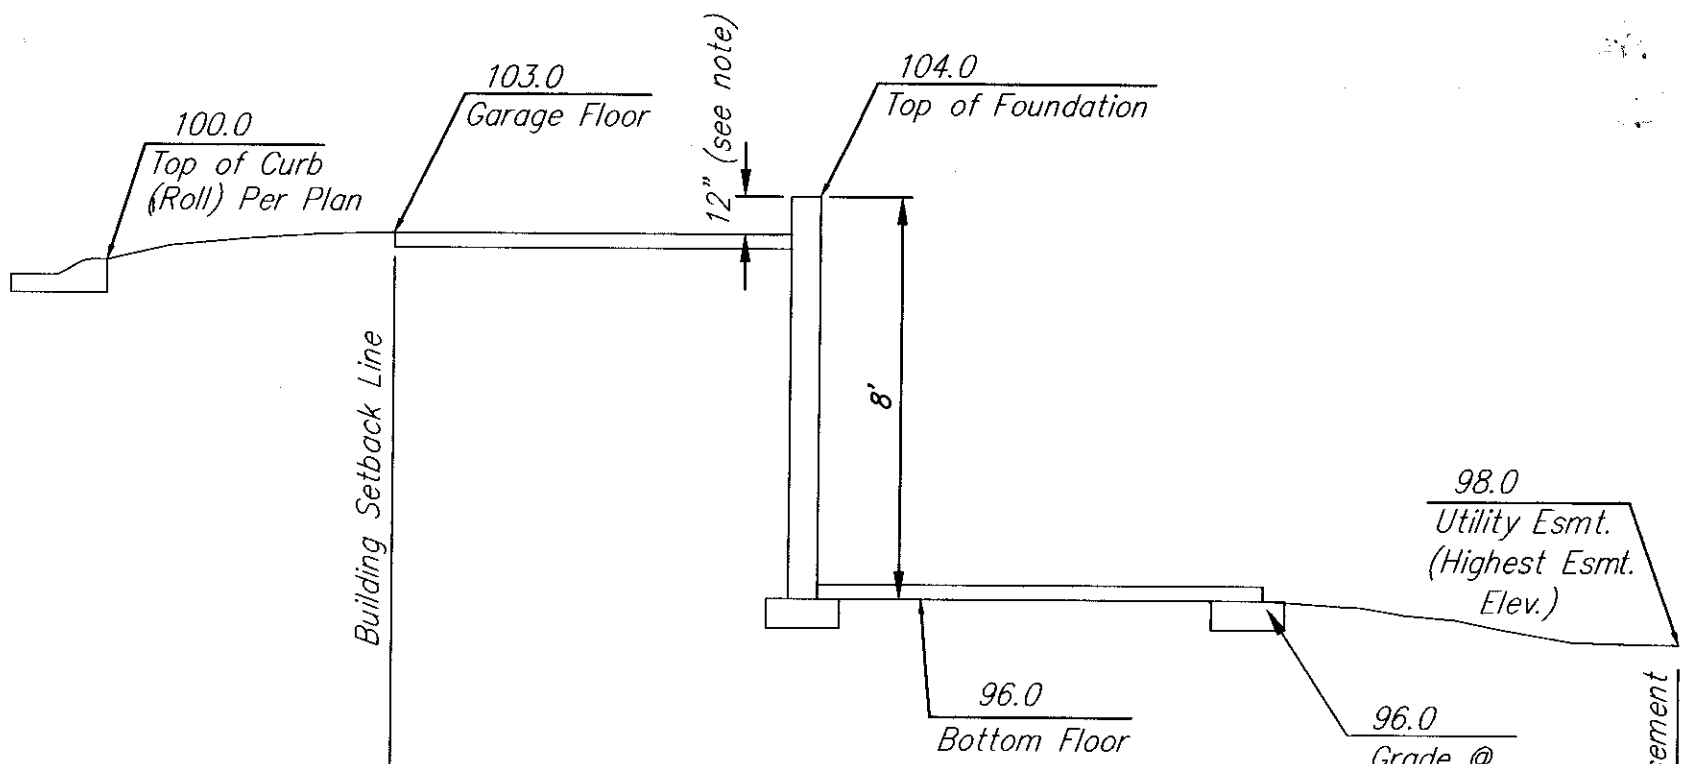

Section Through Typical Walk-Out Lot

BLOCK	LOT NO.	ELEVATION (NGVD29)
4	13, 14, 15, 16, 17, 18, 19, 20, 21, 22, 23, 24, 25, 26, 27, 28	1317.0
6	1, 2, 3, 4, 5, 21, 22, 23, 24, 25, 26, 27, 28, 29	1320.0
6	6, 7, 8, 9, 10, 11, 12, 13, 14, 15, 16, 17, 18, 19, 20	1324.0
7	28, 29, 30	1319.0
7	31	1317.0
7	32	1315.0
7	33, 34, 35, 36, 37, 28, 39, 40, 41, 42, 43, 44	1314.7
7	45, 46, 47, 48, 49, 50	1314.4
7	51, 52, 53	1314.2

