BENCHMARK

Site Benchmark
Northeast Property Corner Iron.
Elev. = 1326.15

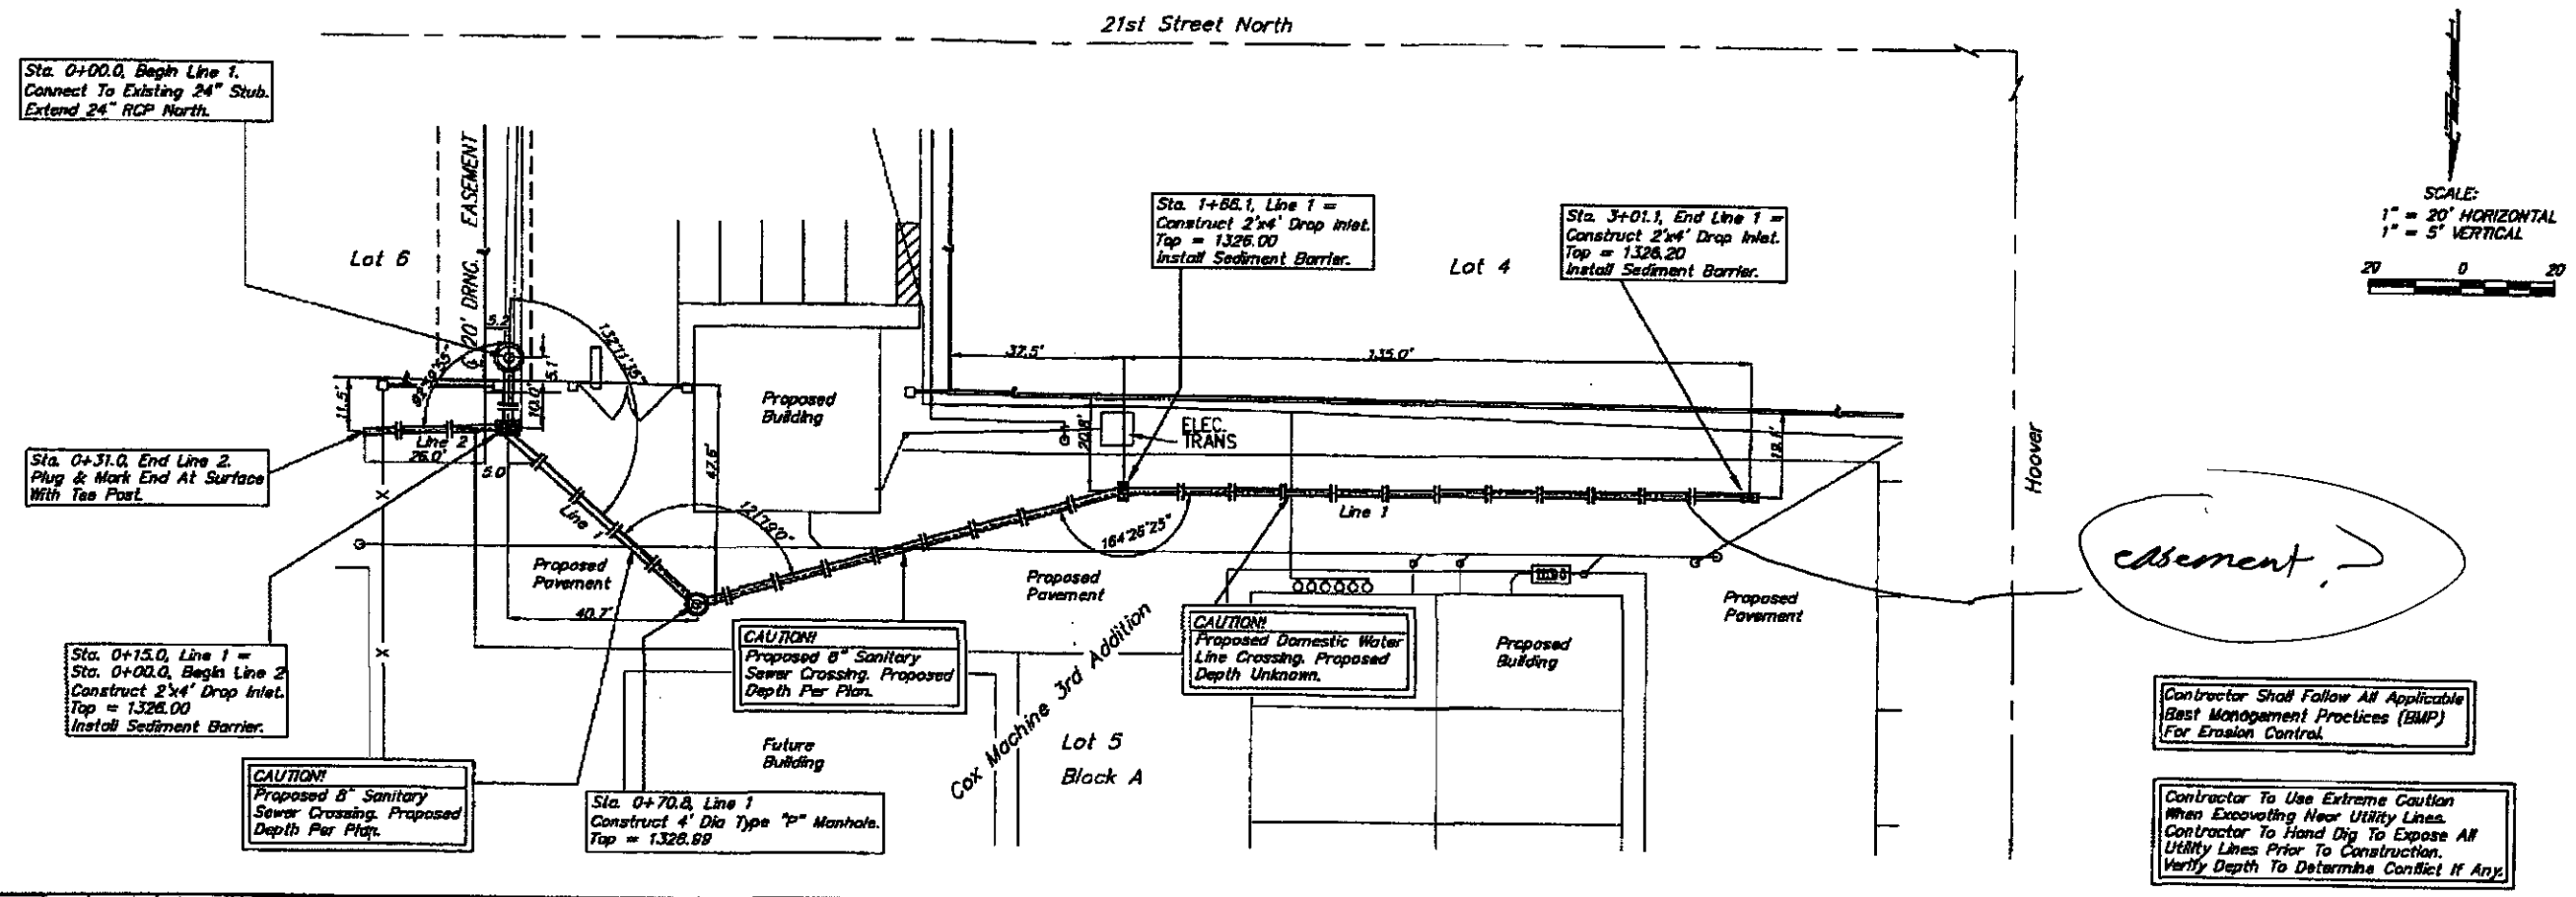

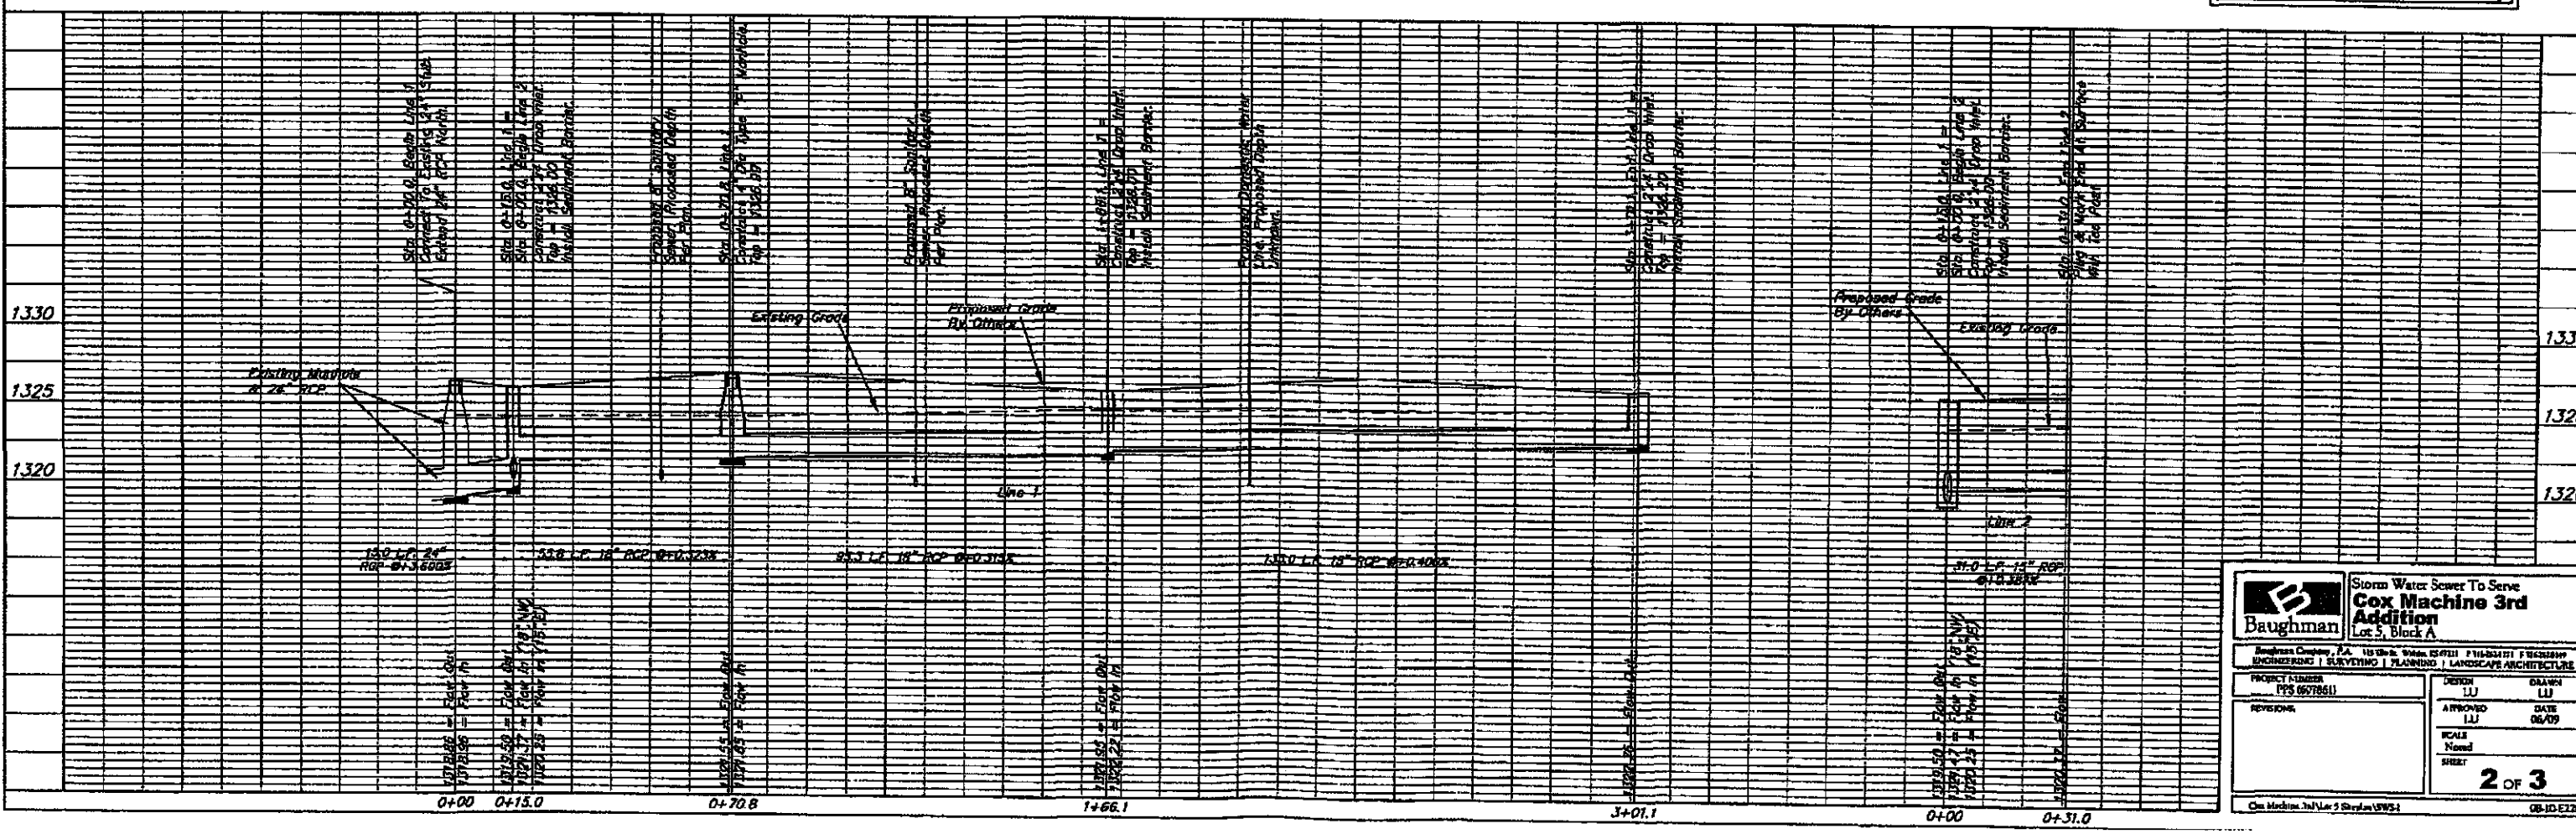

Baughman

Storm Water Sewer To Serve
Cox Machine 3rd Addition
Lot 5, Block A

Baughman Company, P.A. 115 North Wilson 65-97211 P 918-834-1171 F 918-834-8899
ENGINEERING | SURVEYING | PLANNING | LANDSCAPE ARCHITECTURE

PROJECT NUMBER: PTS 0607661	DESIGN: LJJ / DRAWN: LJJ
REVISIONS:	APPROVED: LJJ / DATE: 06/09
	SCALE: Noted
	SHEET 2 OF 3

Cox Machine 3rd\Lot 5 Storm\SWS-1 08-10-E220