

TERRADYNE WEST


an Addition to Wichita, Sedgwick County, Kansas

Length	Radius	Chord	Delta

Line	Length	Bearing

Low Opening	Elevation

1321 013 of 024P

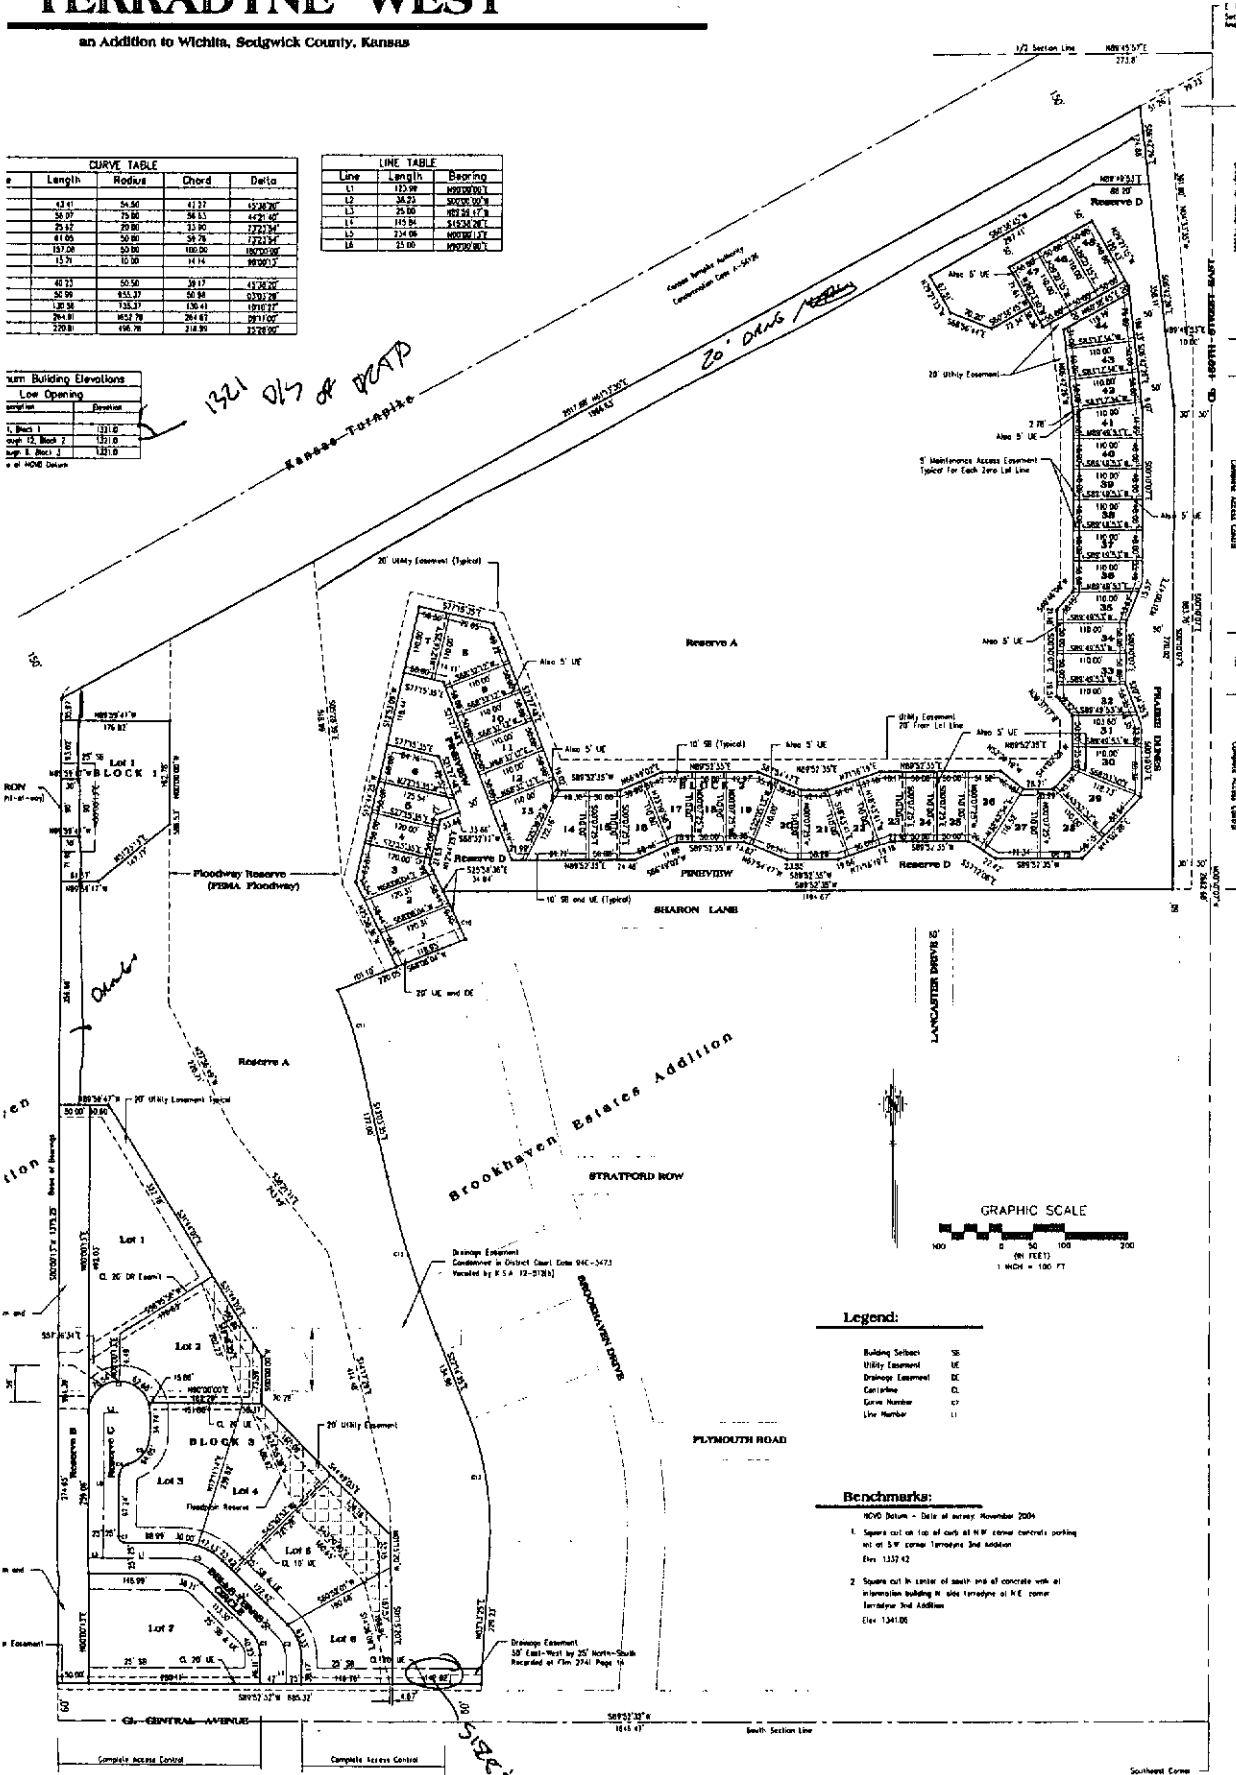

- Legend:**
- Building Setback SE
 - Utility Easement UE
 - Drainage Easement DE

- Benchmarks:**
- 1. Square cut on top of curb at N.W. corner controls parking lot at S.W. corner Terrace 2nd Addition Elev 1331.42
 - 2. Square cut in center of south end of concrete walk at intersection building to site terradyne at N.E. corner Terradyne 2nd Addition Elev 1341.00