


IT APPEARS THE POND AND OUTFALL HAS CHANGED FROM THE APPROVED DRAINAGE PLAN, PLEASE RE-SUBMIT CALCULATIONS.

- NOTES:
- Any excess excavation shall be stockpiled on-site at an area indicated by the Engineer/Owner or shall be redistributed over site where Owner wants more fill placed. Cost shall be included in cost for site grading.
  - All of Reserve "A" and entire ditch draining into pond shall be seeded and mulched as follows: (Permanent Seeding)  
 SEED -- Kansas Premium Fescue Blend, 8#/1000 Sq. Ft.  
 FERTILIZER -- 12-24-12 Ratio at 350 Lbs./Ac.  
 MULCH -- 2 Tons Prairie Hay / Acre  
 All other disturbed areas are to be seeded and mulched as follows: (Temporary seeding)  
 SEED -- Rye grass (PLS)--5#/1000 Sq. Ft. and  
 Kansas Premium Fescue Blend, 5#/1000 Sq. Ft.  
 MULCH -- 2 Tons Prairie Hay / Acre
  - Pond and ditch seeding shall be placed by 'Hydro Seeding' to ensure a good stand and minimize erosion.
  - Baughman Company will provide staking information at the time of construction.
  - Contractor to strip top 3" of soil within Res. "A" before mass grading and stockpile. Top soil stockpile to be redistributed over Reserve "A" and pond.
  - Compaction of 90% shall be obtained in all areas.

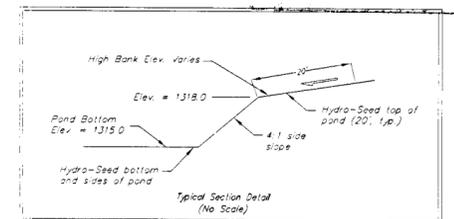

**PRELIMINARY PLAN**  
 DATE July 14, 2005

EROSION CONTROL MEASURE	UNITS	QUANTITY
SILT FENCE (Pond)	L.F.	1,990
SILT FENCE (Site perimeter)	L.F.	27.0
RRRAP	S.Y.	27.0
DROP INLET BARRIER	E.A.	--
CURB INLET BARRIER	E.A.	--
Construction Entrance	E.A.	1

QUANTITIES ARE FOR INFORMATION ONLY.  
 CONTRACTOR SHALL VERIFY QUANTITIES PER SPECIFIC ENGINEERING PLAN SHEET.

EARTH WORK TOTALS

	C.Y. Excavation	C.Y. Fill
Mass Grading	7,002	4,164
Pond Construction (Quantities in Mass Grading)		
Total	7,002	4,164

Earthwork quantities do not include correction factors and are for reference only. All cost associated with mass grading shall be included in the bid item "Mass Grading".

**Baughman** Grading Plan  
 Site Improvements

Wichita Concrete Pipe

REVISIONS:

NO.	DATE	BY	CHKD.
1			

SCALE: 1" = 50'

SHEET: 2 OF 7