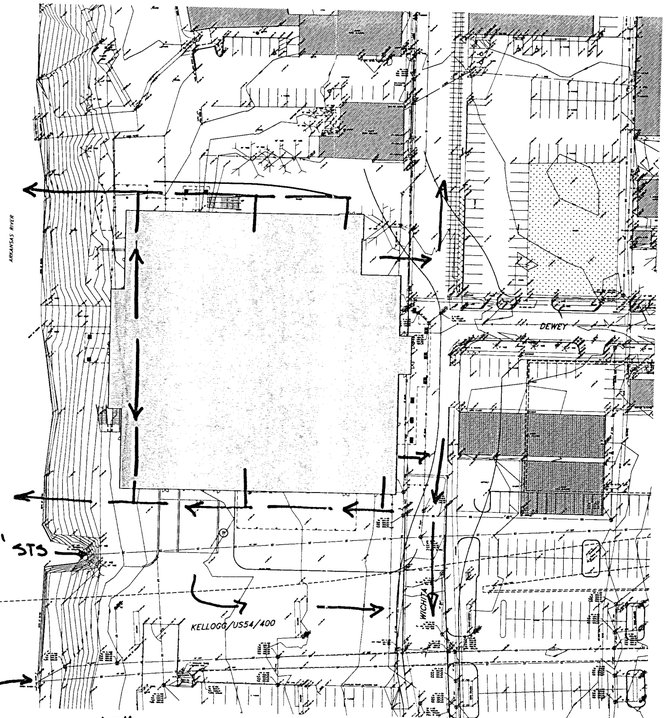

GRAPHIC SCALE

1 IN. = 50 ft.

Survey Legend

GossenLivingston
Architecture
432 South Emporia
Wichita, KS 67202
Tel (316) 263-1367
Fax (316) 263-3248
Email info@glai.com

Johnson & Associates, Inc.
100 E. California Ave. - Third Floor
Oklahoma City, OK 73104
405-232-8772 Fax 405-232-8775
Certificate of Authorization #1158 EXP DATE 12-31-2004
- ENGINEERS - SURVEYORS - PLANNERS -

© 2004 Gossen Livingston Associates, Inc.
The design and all information herein is the exclusive property of Gossen Livingston Associates, Inc. and is not to be used in part or in whole without the express written consent of Gossen Livingston Associates, Inc. Drawings, specifications, data, designs and computer generated media remain the original and exclusive form of.
Gossen Livingston Associates, Inc.

WICHITA WATERWALK

GANDER MOUNTAIN

Rev	Date	Description

DRAINAGE MAP

Job No.
Date 11-15-04
Scale
Drawn
Checked

C002