



### LEGEND

	- CONIFEROUS TREE		- UNDERGROUND ELEC.
	- DECIDUOUS TREE		- OVERHEAD ELECTRIC
	- SIGN		- FIBER OPTIC CABLE
	- POWER POLE		- SPOT ELEVATIONS
	- ELECTRIC BOX		- FUTURE STORMWATER SPOT ELEVATIONS
	- LIGHT POLE	<b>WO</b>	- WALKOUT
	- FIRE HYDRANT	<b>VO</b>	- VIEWOUT
	- WATER VALVE	<b>NOVO</b>	- NO VIEWOUT
	- WATER METER	<b>WO*</b>	- WALKOUT WHICH MAY REQUIRE THICKER FOOTING AND/OR ENGINEERED FILL UNDER FOOTINGS
	- SECTION CORNER	<b>PAD=14XX.X</b>	- PROP. HOUSE ELEV.
	- BENCHMARK	<b>PAD=14XX.X</b>	- EXIST. PLOT PLAN
	- EASEMENT	<b>TF=14XX.X</b>	
	- BUILDING SETBACK	<b>VO=14XX.X</b>	
	- FENCE		
	- STORM SEWER PIPE		
	- WATER LINE		
	- SANITARY SEWER LINE		
	- GAS LINE		
	- GAS PIPELINE		
	- TELEPHONE LINE		

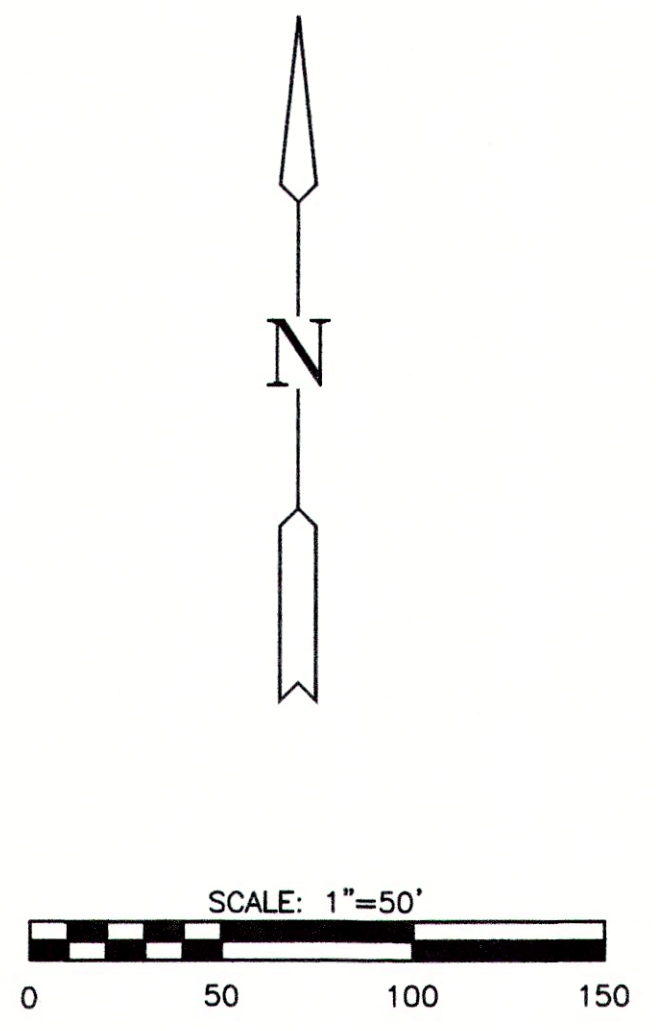

**MKEC**  
ENGINEERING  
CONSULTANTS, INC.  
411 N. WEBB ROAD  
WICHITA, KS. 67206  
316 - 684 - 9600

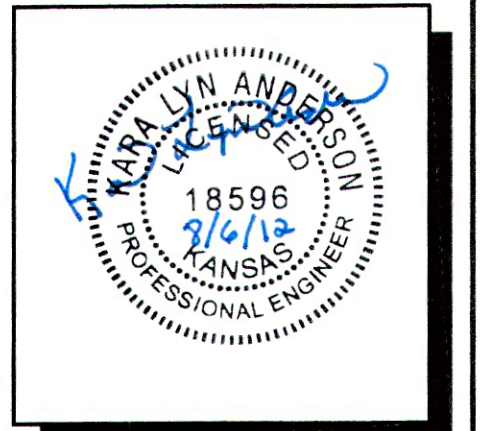

**MOORINGS 10TH ADDITION**  
MOORINGS 10TH ADDITION  
WICHITA, KANSAS  
**LOT GRADING PLAN**

DATE	AUGUST 2008
REVISED	FUTURE SWS 7/23/12
	SPOT ELEV 8/1/12
	SPOT ELEV 8/6/12

DESIGN BY	KLA
DRAWN BY	CMJ
CHECKED BY	GJA

SHEET NUMBER  
**4 of 4**

J:\Civil\06608.dwg\GRADE\06608\_lgpd50.dwg