


FILE LOCATION: \\d:\proj\12-7-09\UT_60326R\DWG\UT0326R_Bas-P1(08.D)13.dwg USER: hameg Date: 12/23/2011 5:00 PM PLOT: 7/24/2012 9:13 AM

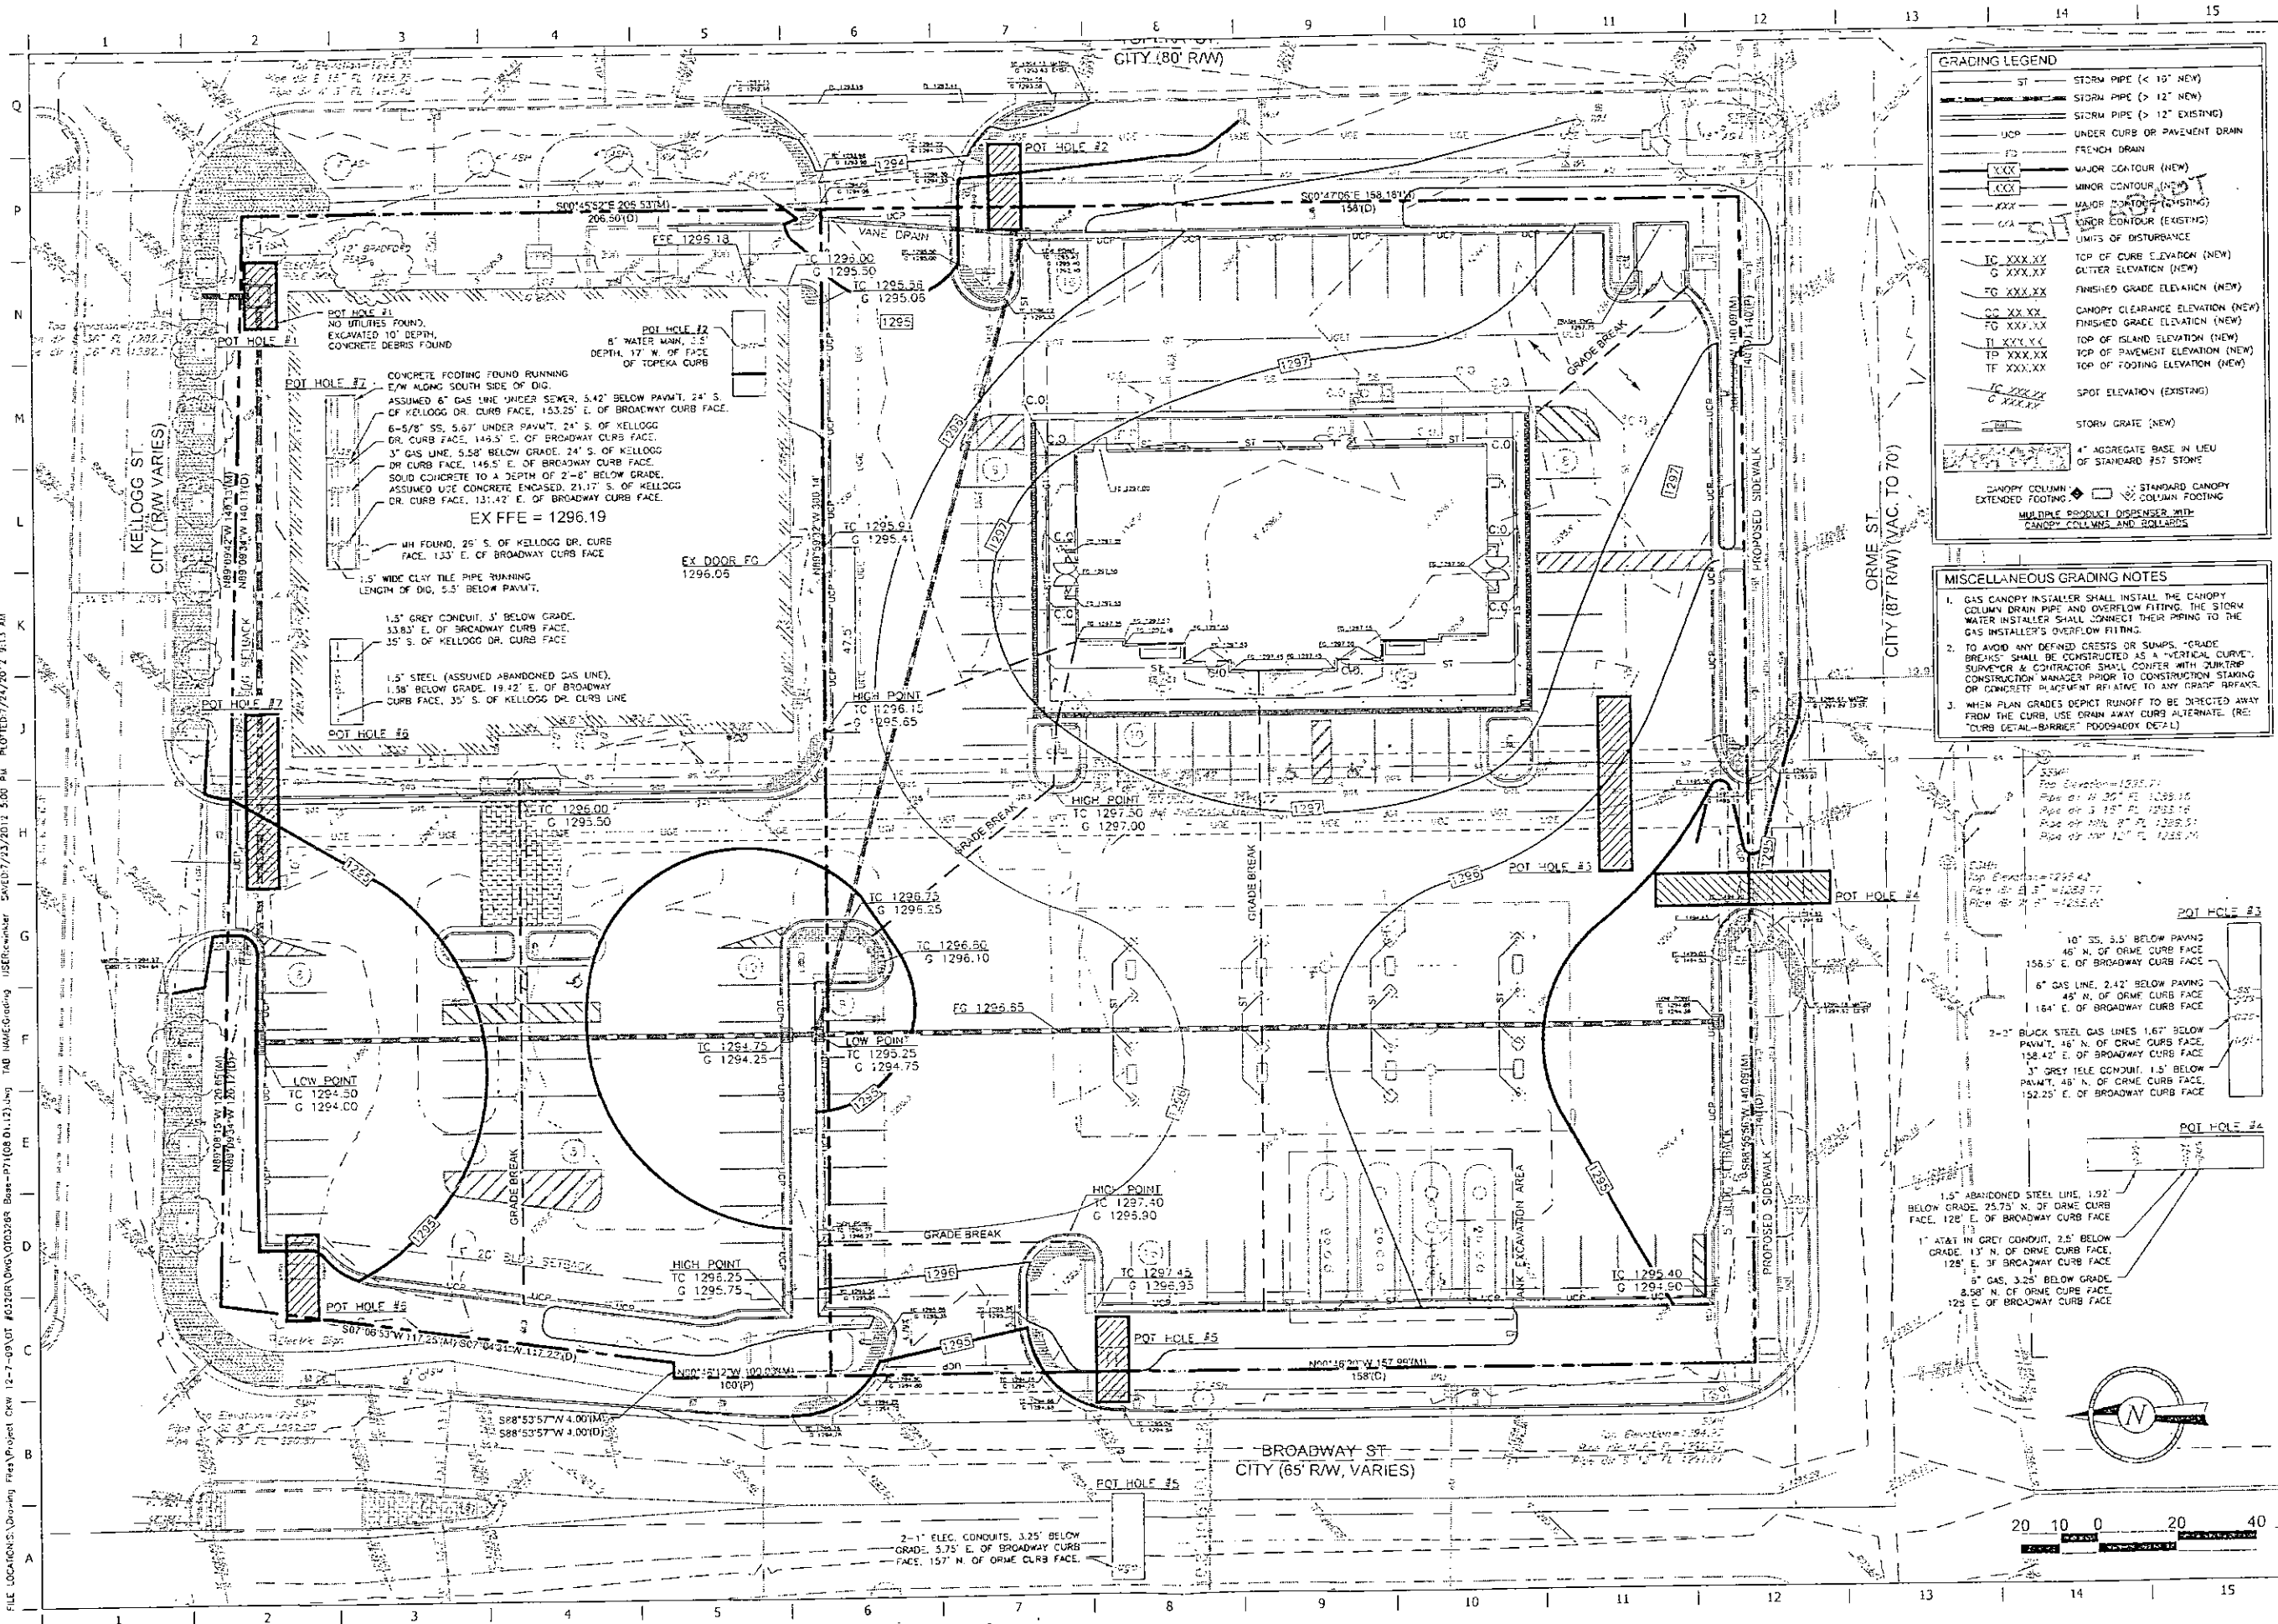

GRADING LEGEND

- ST STORM PIPE (< 12" NEW)
- STORM PIPE (> 12" NEW)
- STORM PIPE (> 12" EXISTING)
- UCP UNDER CURB OR PAVEMENT DRAIN
- F2 FRENCH DRAIN
- LIMITS OF DISTURBANCE
- TOP OF CURB ELEVATION (NEW)
- GUTTER ELEVATION (NEW)
- FINISHED GRADE ELEVATION (NEW)
- CANOPY CLEARANCE ELEVATION (NEW)
- FINISHED GRADE ELEVATION (NEW)
- TOP OF ISLAND ELEVATION (NEW)
- TOP OF PAVEMENT ELEVATION (NEW)
- TOP OF FOOTING ELEVATION (NEW)
- SPOT ELEVATION (EXISTING)
- STORM GRATE (NEW)
- 4" AGGREGATE BASE IN LIEU OF STANDARD #57 STONE
- CANOPY COLUMN EXTENDED FOOTING
- STANDARD CANOPY COLUMN FOOTING
- MULTIPLE PRODUCT DISPENSER WITH CANOPY COLUMN AND RAILINGS

- MISCELLANEOUS GRADING NOTES**
- GAS CANOPY INSTALLER SHALL INSTALL THE CANOPY COLUMN DRAIN PIPE AND OVERFLOW FITTING. THE STORM WATER INSTALLER SHALL CONNECT THEIR PIPING TO THE GAS INSTALLER'S OVERFLOW FITTING.
 - TO AVOID ANY DEFINED CRESTS OR SINKS, "GRADE BREAKS" SHALL BE CONSTRUCTED AS A "VERTICAL CURVE". SURVEYOR & CONTRACTOR SHALL CONFER WITH JURISDICTION CONSTRUCTION MANAGER PRIOR TO CONSTRUCTION STAKING OR CONCRETE PLACEMENT RELATIVE TO ANY GRADE BREAKS.
 - WHEN PLAN GRADES DEPICT RUNOFF TO BE DEFLECTED AWAY FROM THE CURB, USE DRAIN AWAY CURB ALTERNATE. (SEE "CURB DETAIL-BARRIER" P003000.DWG)

POT HOLE #1
NO UTILITIES FOUND, EXCAVATED 10' DEPTH, CONCRETE DEBRIS FOUND

POT HOLE #2








QuikTrip No. 0326R
BROADWAY & ORME
WICHITA, KANSAS



PROTOTYPE: P-7 (05/01/2)
DIVISION:
VERSION: 001
DESIGNED BY:
DRAWN BY:
REVIEWED BY:

REV	DATE	DESCRIPTION	ORIGINAL ISSUE DATE

SHEET TITLE:
GRADING PLAN

SHEET NUMBER:
C110

