
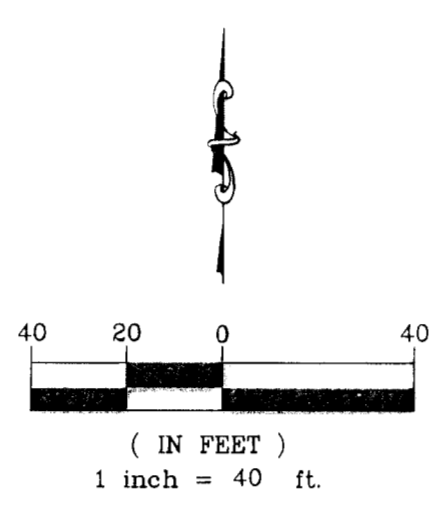


FINAL TRACING REC'D 8-28-12

# U-Save Tire Addition Sedgwick County, Kansas

Part of the SW 1/4, Section 14, Township 28 South, Range 1 East of the 6th. P.M.

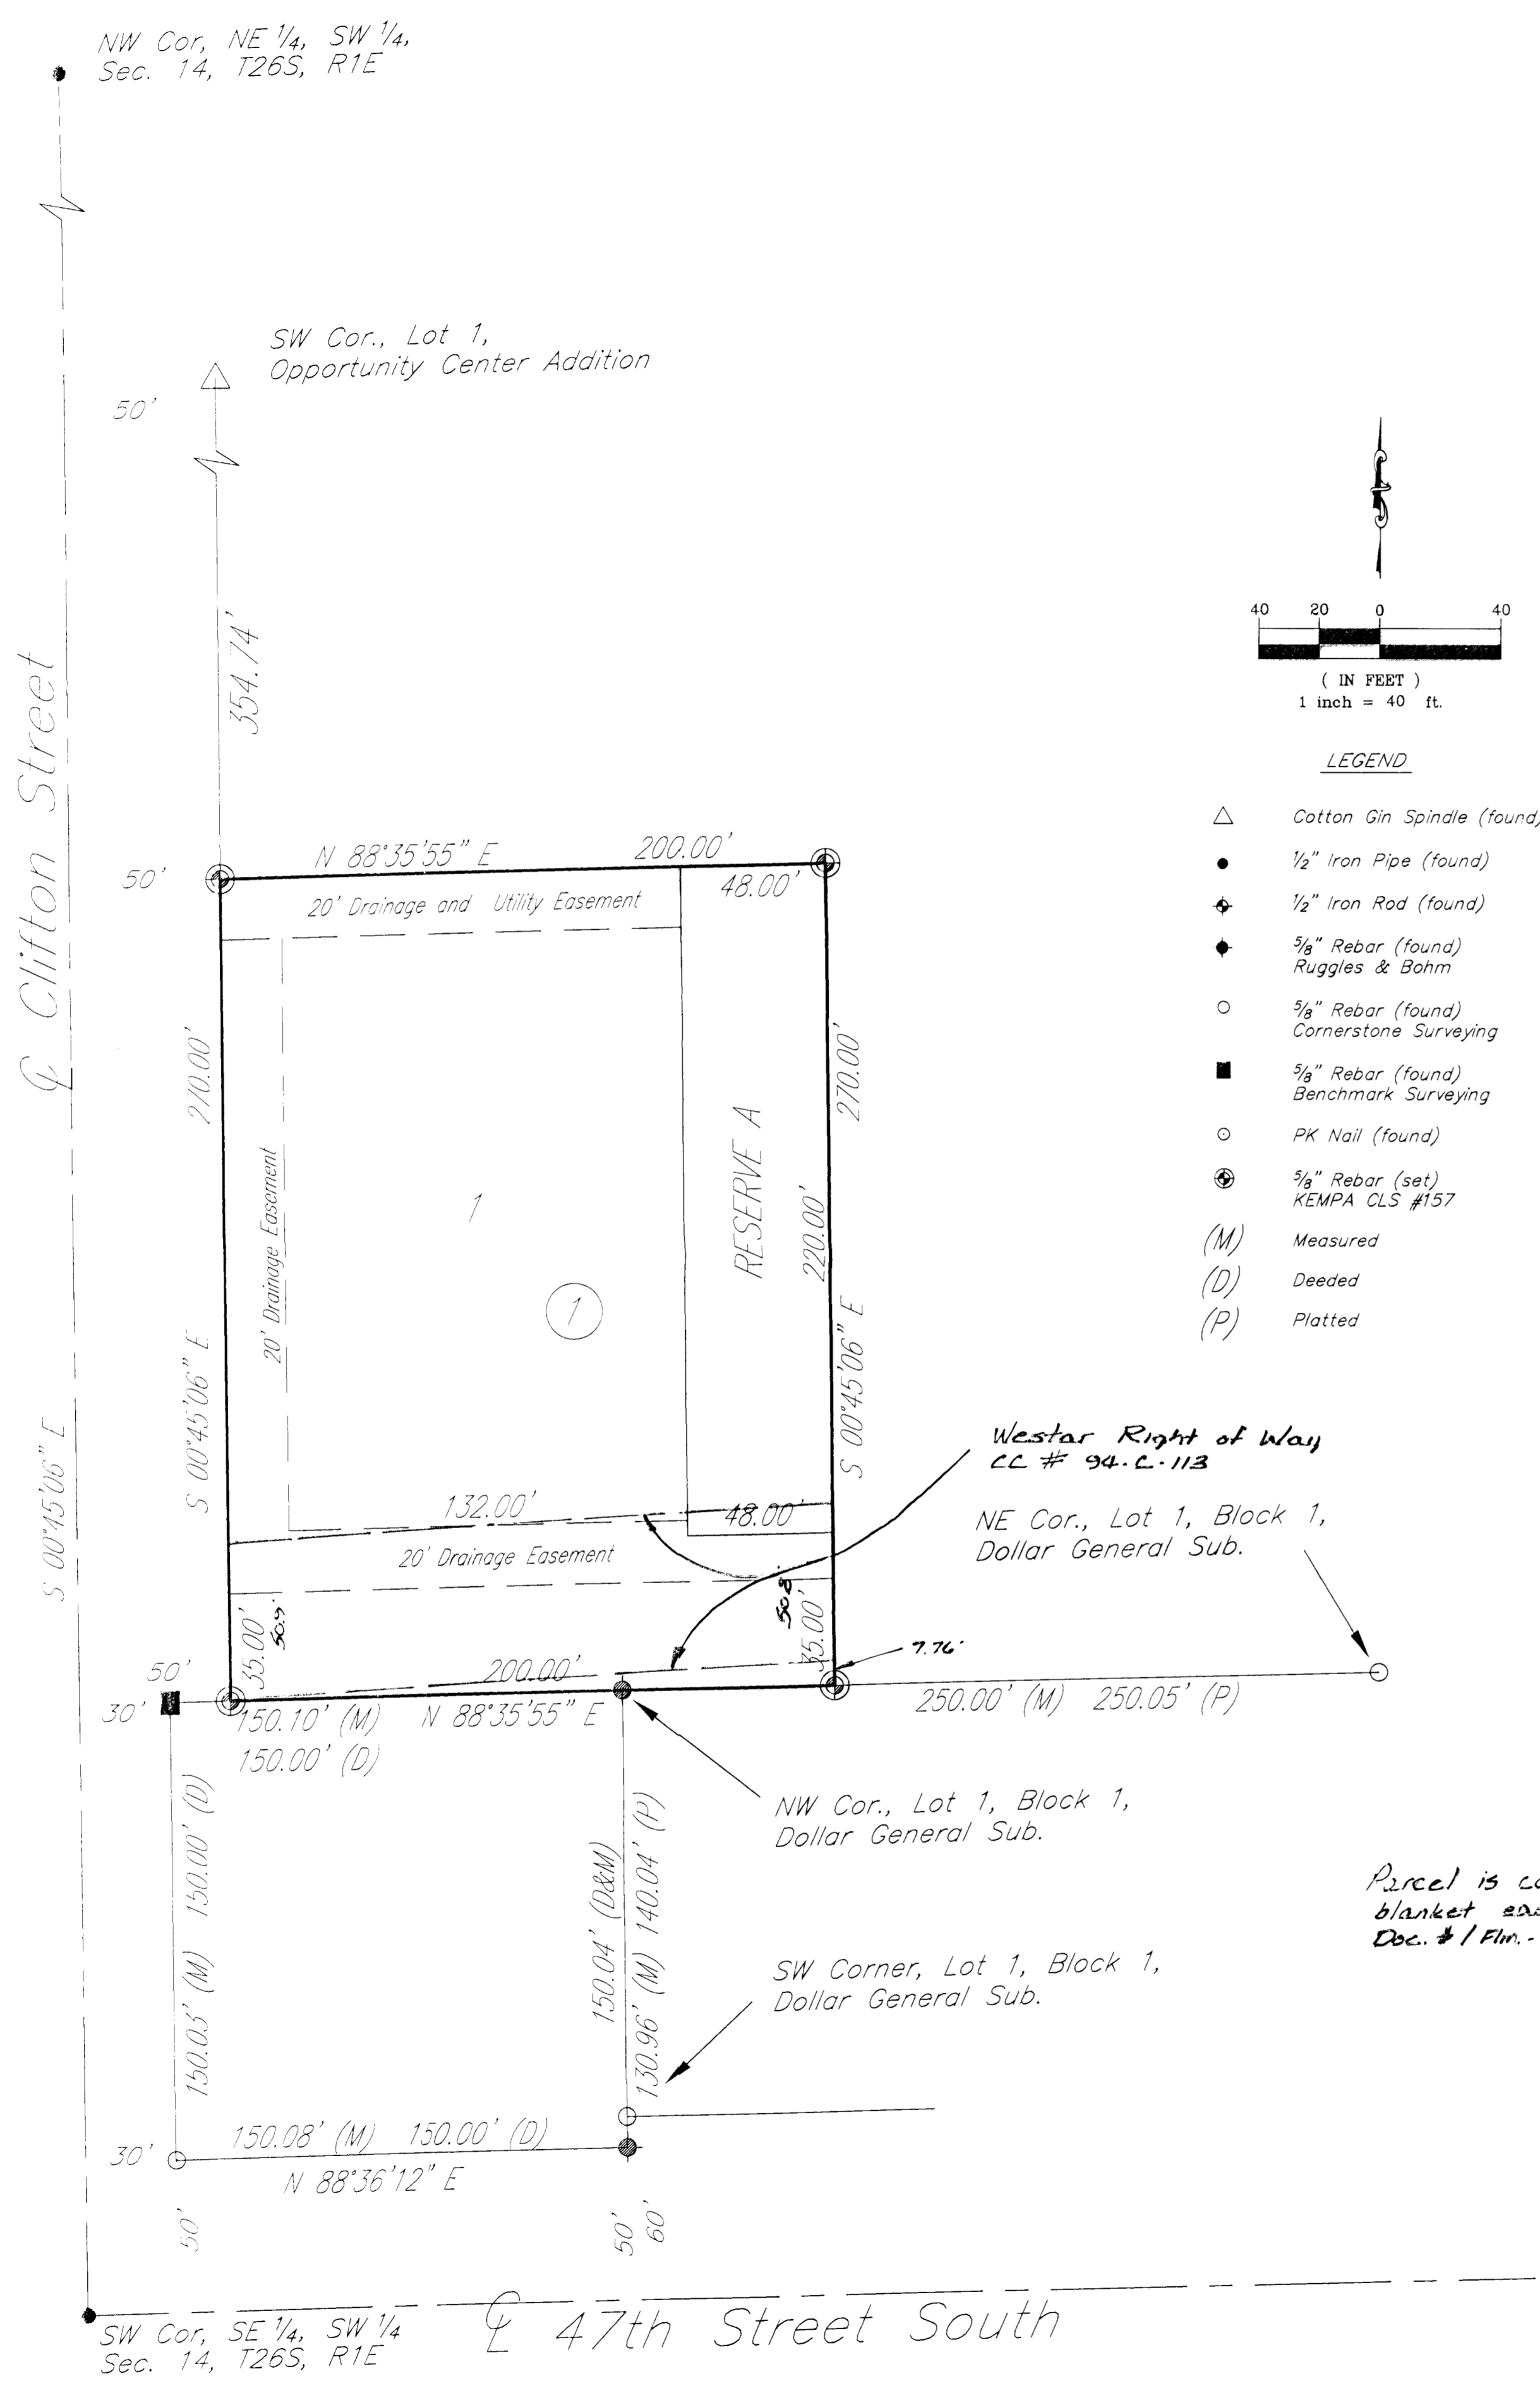

- LEGEND**
- △ Cotton Gin Spindle (found)
  - 1/2" Iron Pipe (found)
  - ◆ 1/2" Iron Rod (found)
  - (M) Measured
  - (D) Deeded
  - (P) Platted


State of Kansas }  
County of Sedgwick } SS

I, Bradley C. Ward, a licensed land surveyor of the State of Kansas, do hereby certify that the following described tract of land was surveyed on the 17th day of November, 2011 and the accompanying final plat prepared and that all the monuments shown herein actually exist and their positions are correctly shown to the best of my knowledge and belief.

**LEGAL DESCRIPTION**

The South 270 feet of the West 200 feet of the following described parcel:  
That part of the Southeast Quarter of the Southwest Quarter of Section 14, Township 28 South, Range 1 East of the Sixth Principal Meridian, Sedgwick County, Kansas, lying West of the Atchison, Topeka, and Santa Fe Railway Company right-of-way; EXCEPT the West 180 feet of the South 200 feet thereof; AND EXCEPT the North 1125.22 feet of the West 50 feet thereof for highway; AND EXCEPT the South 50 feet thereof for road; AND EXCEPT that part platted as Opportunity Center Addition, Sedgwick County, Kansas; AND EXCEPT that part platted as Dollar General Subdivision, an Addition to Sedgwick County, Kansas.

All easements and Rights of Way within said tract are hereby vacated by virtue of K.S.A. 17-1001.

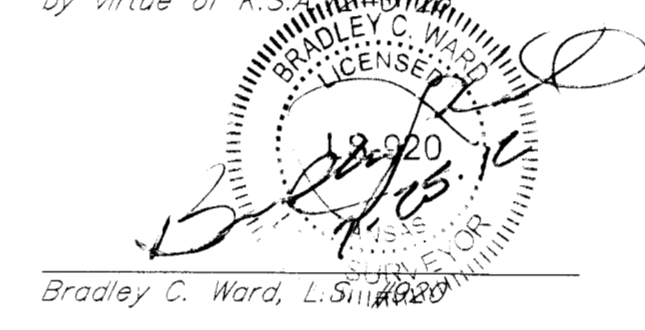

State of Kansas }  
County of Sedgwick } SS

Know all men by these presents, that we, the undersigned, have caused the land described in the surveyor's certificate to be platted into a Lot, Block and Reserve, to be known as U-Save Tire Addition, Sedgwick County, Kansas. Any easements are hereby granted as indicated for constructing, maintaining, operating, and repairing public utilities. Reserve A is platted for drainage, utilities, landscaping and irrigation. A drainage plan has been developed for the plot and all drainage easements, rights-of-way, or reserves shall remain at established grades or as modified with the approval of the applicable City or County Engineer, and unobstructed to allow for the conveyance of stormwater. And further that the land contained herein is held and shall be conveyed subject to any applicable restrictions, reservations and covenants now on file or hereafter filed in the Office of the Register of Deeds of Sedgwick County, Kansas.

Owners:  
Stanley Swope  
By: Stanley Swope Date: 8-1-12  
Maureen Swope  
By: Maureen Swope Date: 8-1-12

State of Kansas }  
County of Sedgwick } SS

This instrument was acknowledged before me on this 1st day of August, 2012, Stanley Swope, Owner.

Joanna Davis Swankland  
Notary Public  
My Commission Expires: 11-18-13

State of Kansas }  
County of Sedgwick } SS

This instrument was acknowledged before me on this 1st day of August, 2012, Maureen Swope, Owner.

Joanna Davis Swankland  
Notary Public  
My Commission Expires: 11-18-13

State of Kansas }  
County of Sedgwick } SS

This plat of U-Save Tire Addition, Sedgwick County, Kansas, has been submitted to and approved by the Wichita-Sedgwick County Metropolitan Area Planning Commission, Sedgwick County, Kansas. Dated this 23 day of DECEMBER, 2012. Wichita-Sedgwick County Metropolitan Area Planning Commission

Shawn Farney  
Shawn Farney, Chair  
John L. Schlegel, Secretary

State of Kansas }  
County of Sedgwick } SS

This plat approved and all dedications shown hereon accepted by the City Council of the City of Wichita, Kansas, this \_\_\_ day of \_\_\_, 2012.

At the Direction of the City Council  
Carl Brewer, Mayor  
Karen Sublett, City Clerk

This plat approved and all dedications shown hereon accepted by the Board of County Commissioners of Sedgwick County, Kansas, this \_\_\_ day of \_\_\_, 2012.

At the Direction of the Board of County Commissioners  
Tim R. Norton, Second District  
Kelly B. Arnold, County Clerk

Entered on transfer record this \_\_\_ day of \_\_\_, 2012.

Kelly B. Arnold, County Clerk


Approved as to form:  
Gary Rebenstorf, Director of Law

State of Kansas }  
County of Sedgwick } SS

This is to certify that this plat has been filed for record in the Office of the Register of Deeds this \_\_\_ day of \_\_\_, 2012, at \_\_\_ o'clock M, and is duly recorded.

Bill Meek, Register of Deeds  
Tonya Buckingham, Deputy

Reviewed in accordance with K.S.A. 58-2005 on this 31st day of August, 2012.

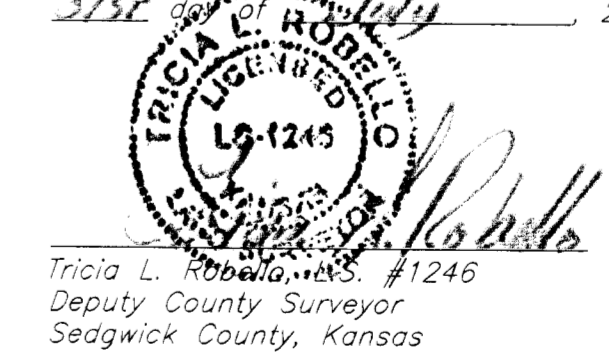

Deputy County Surveyor  
Sedgwick County, Kansas

Filename: 11094\U-SAVE TIRES FINAL PLAT.dwg prepared: 7-25-2012

