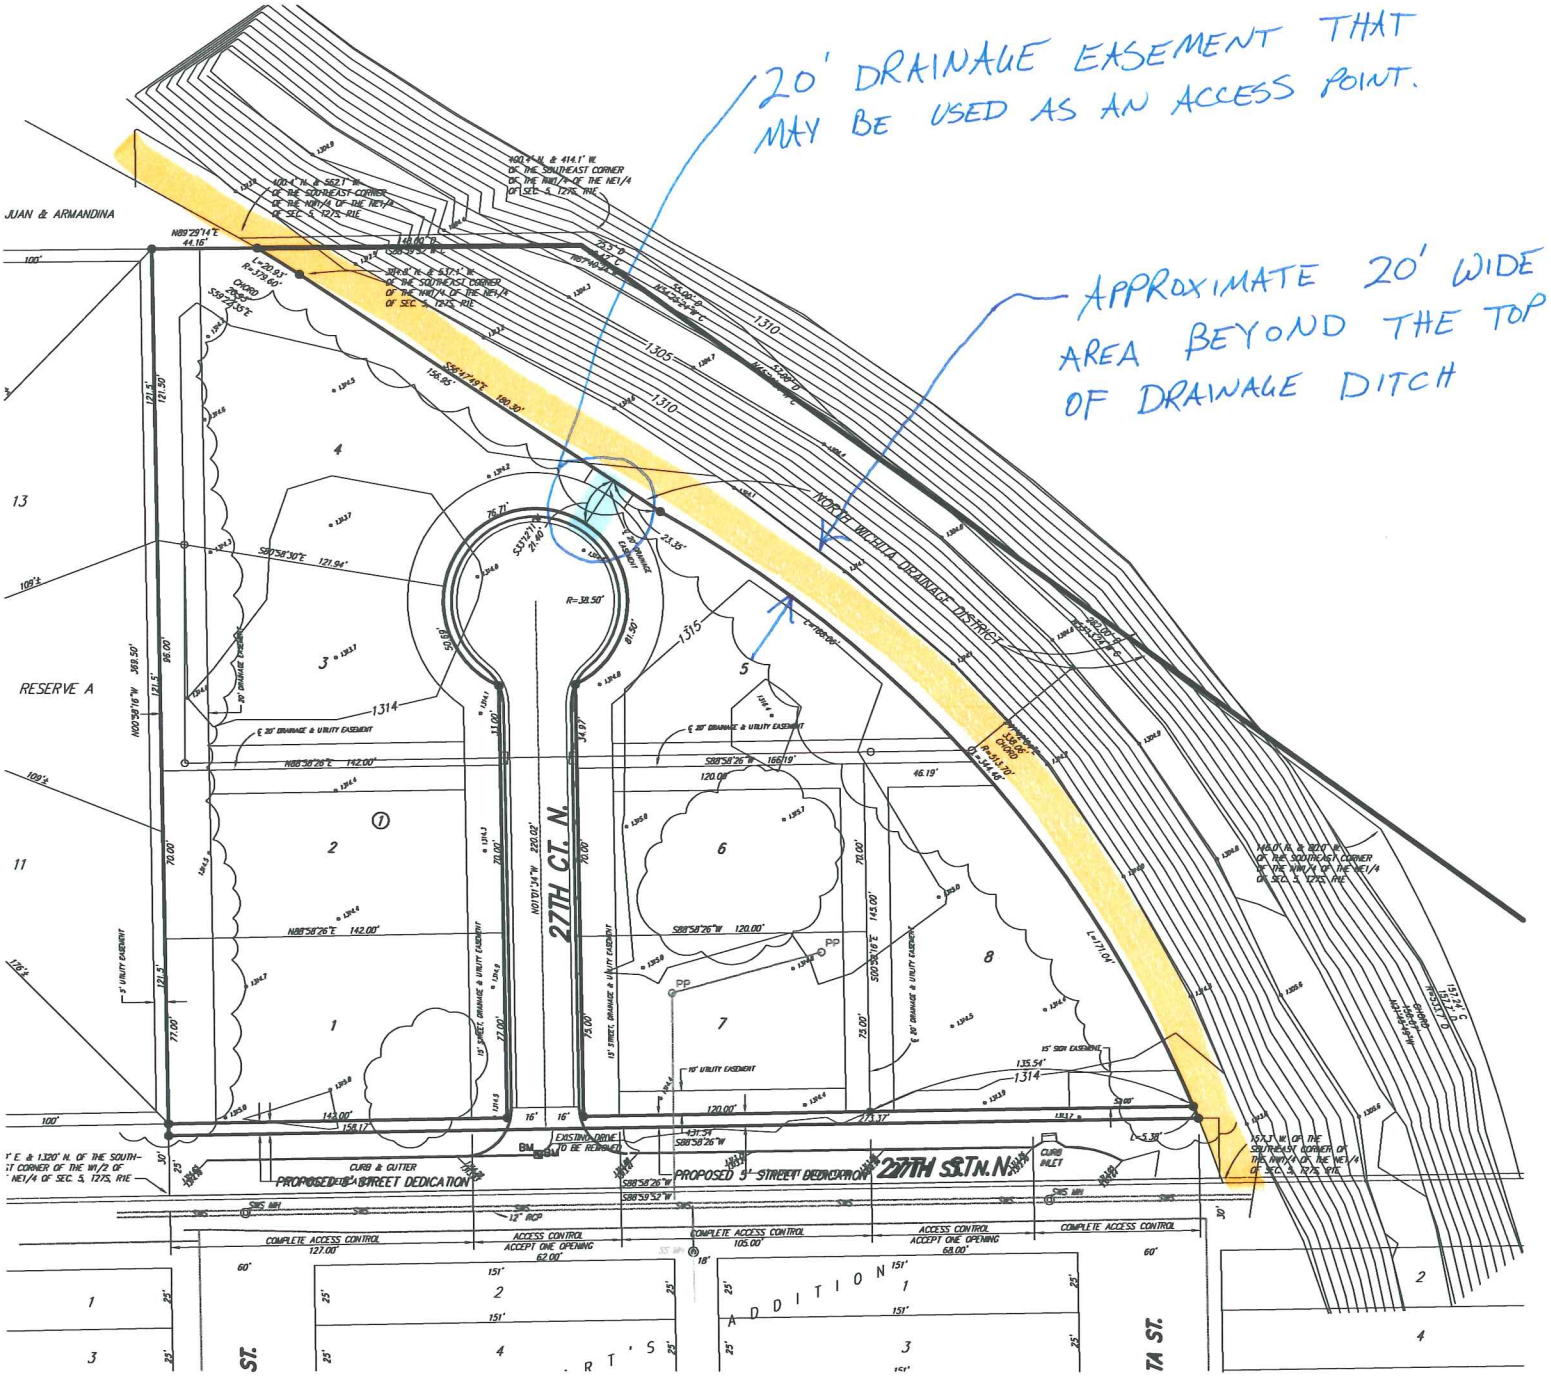HABITAT HILLS