

 


WILLOW CREEK EAST

Wichita, Sedgwick County, Kansas
4-Corner Lot Grading

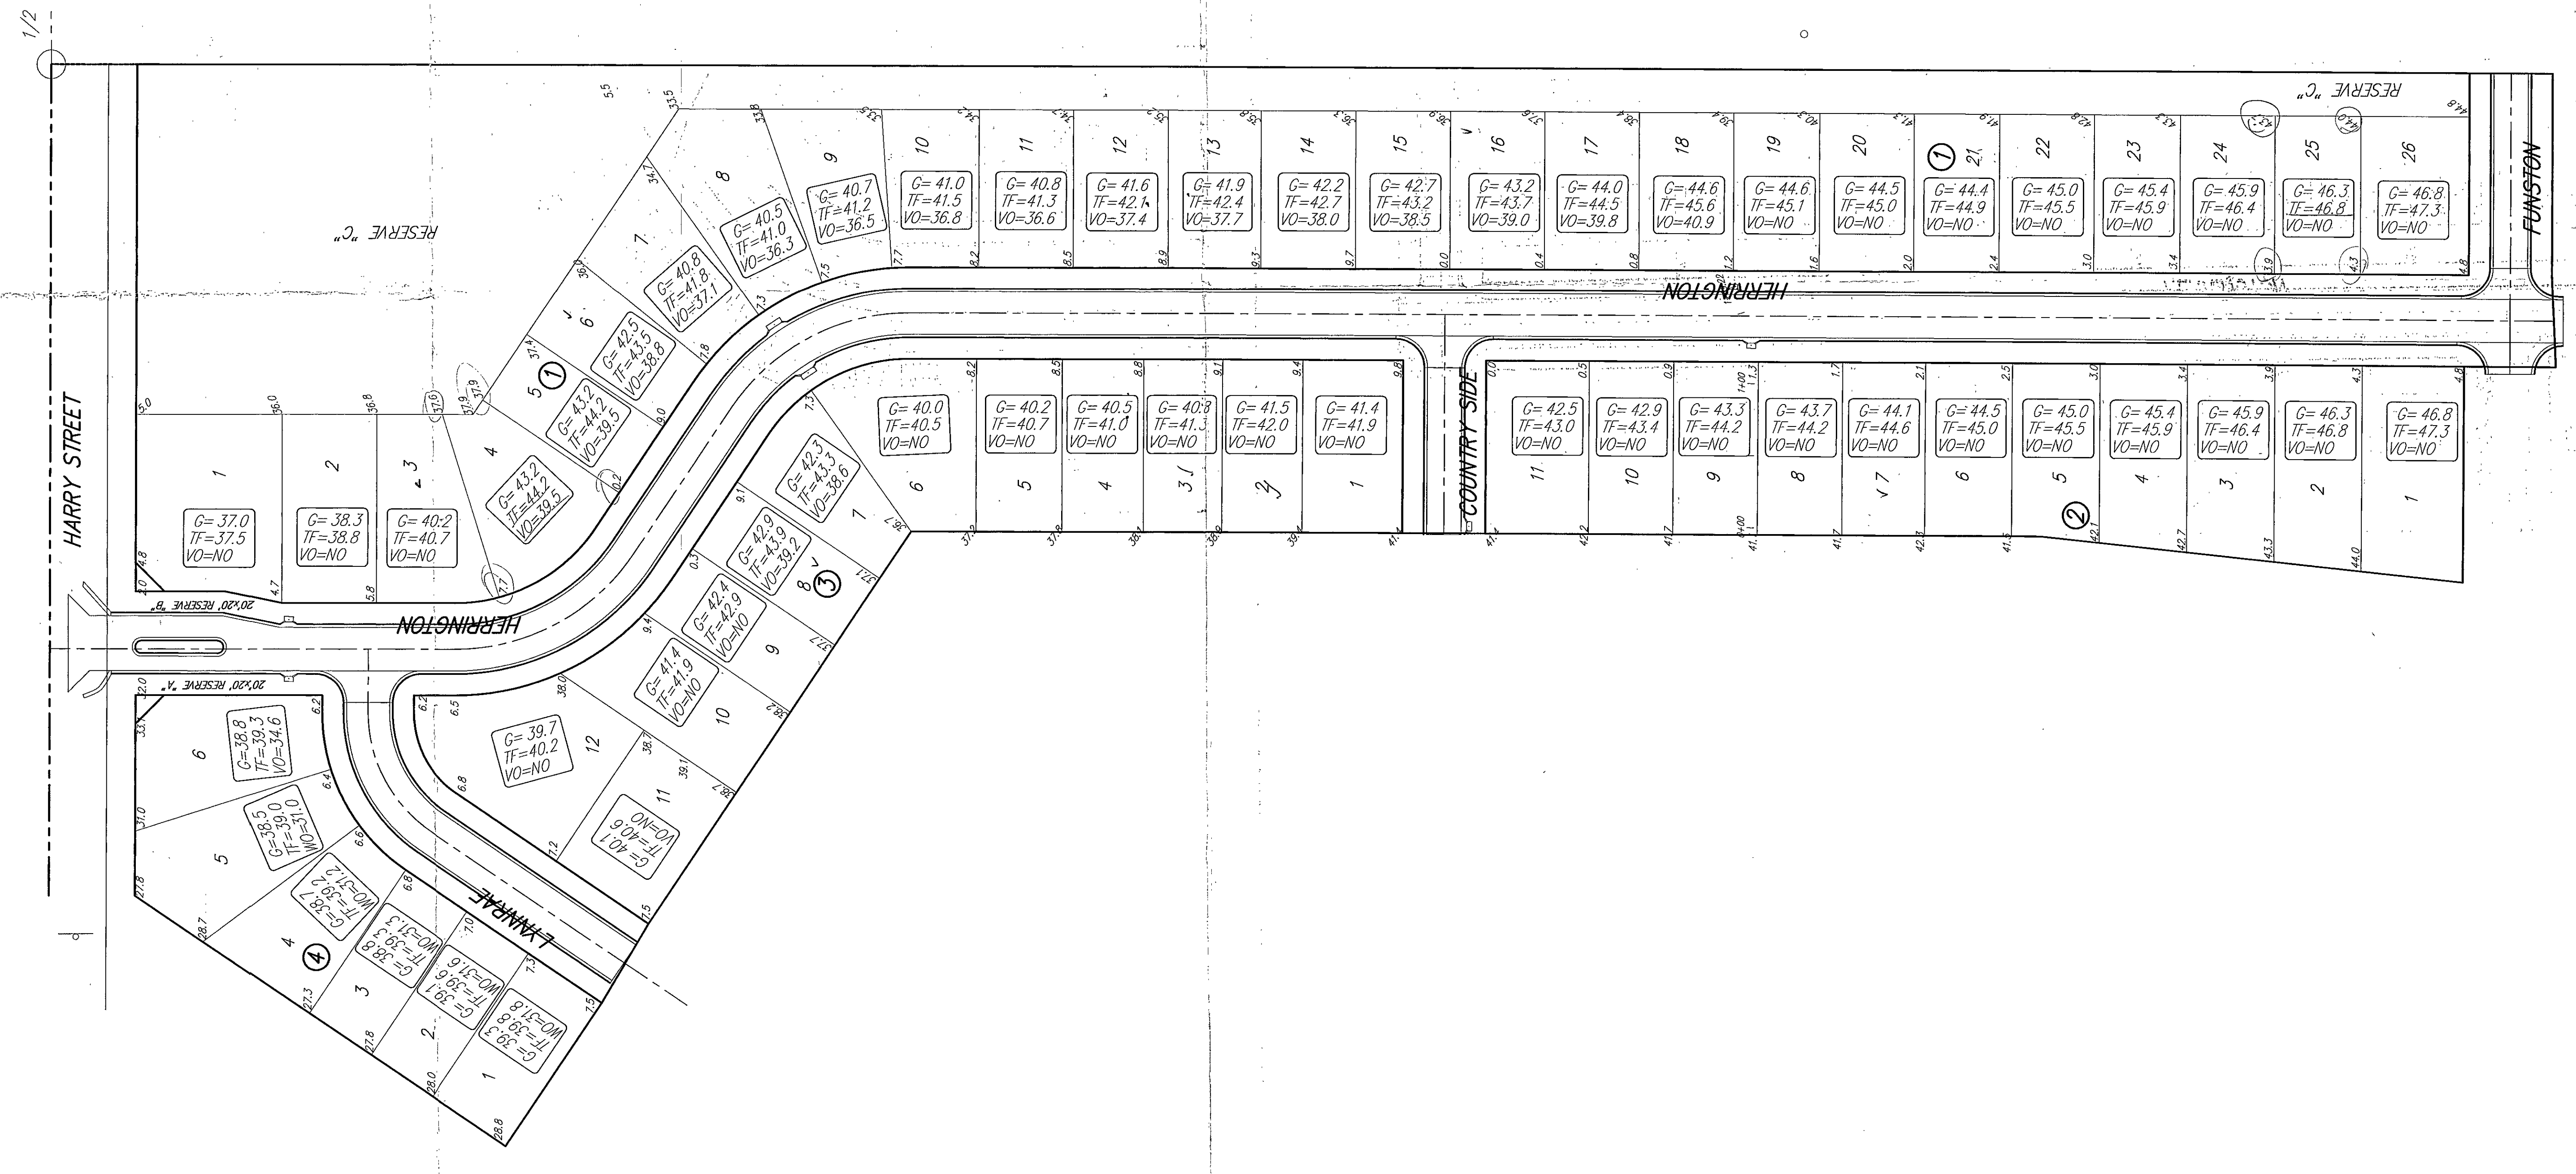

NO.	DATE	DESCRIPTION
1	1.2.1.4.5.6.7.8	100%
2	1.2.1.4.5.6	100%

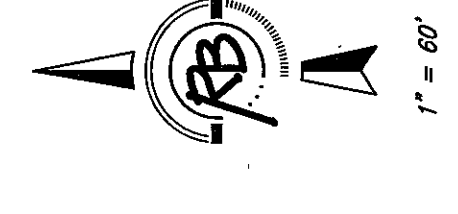