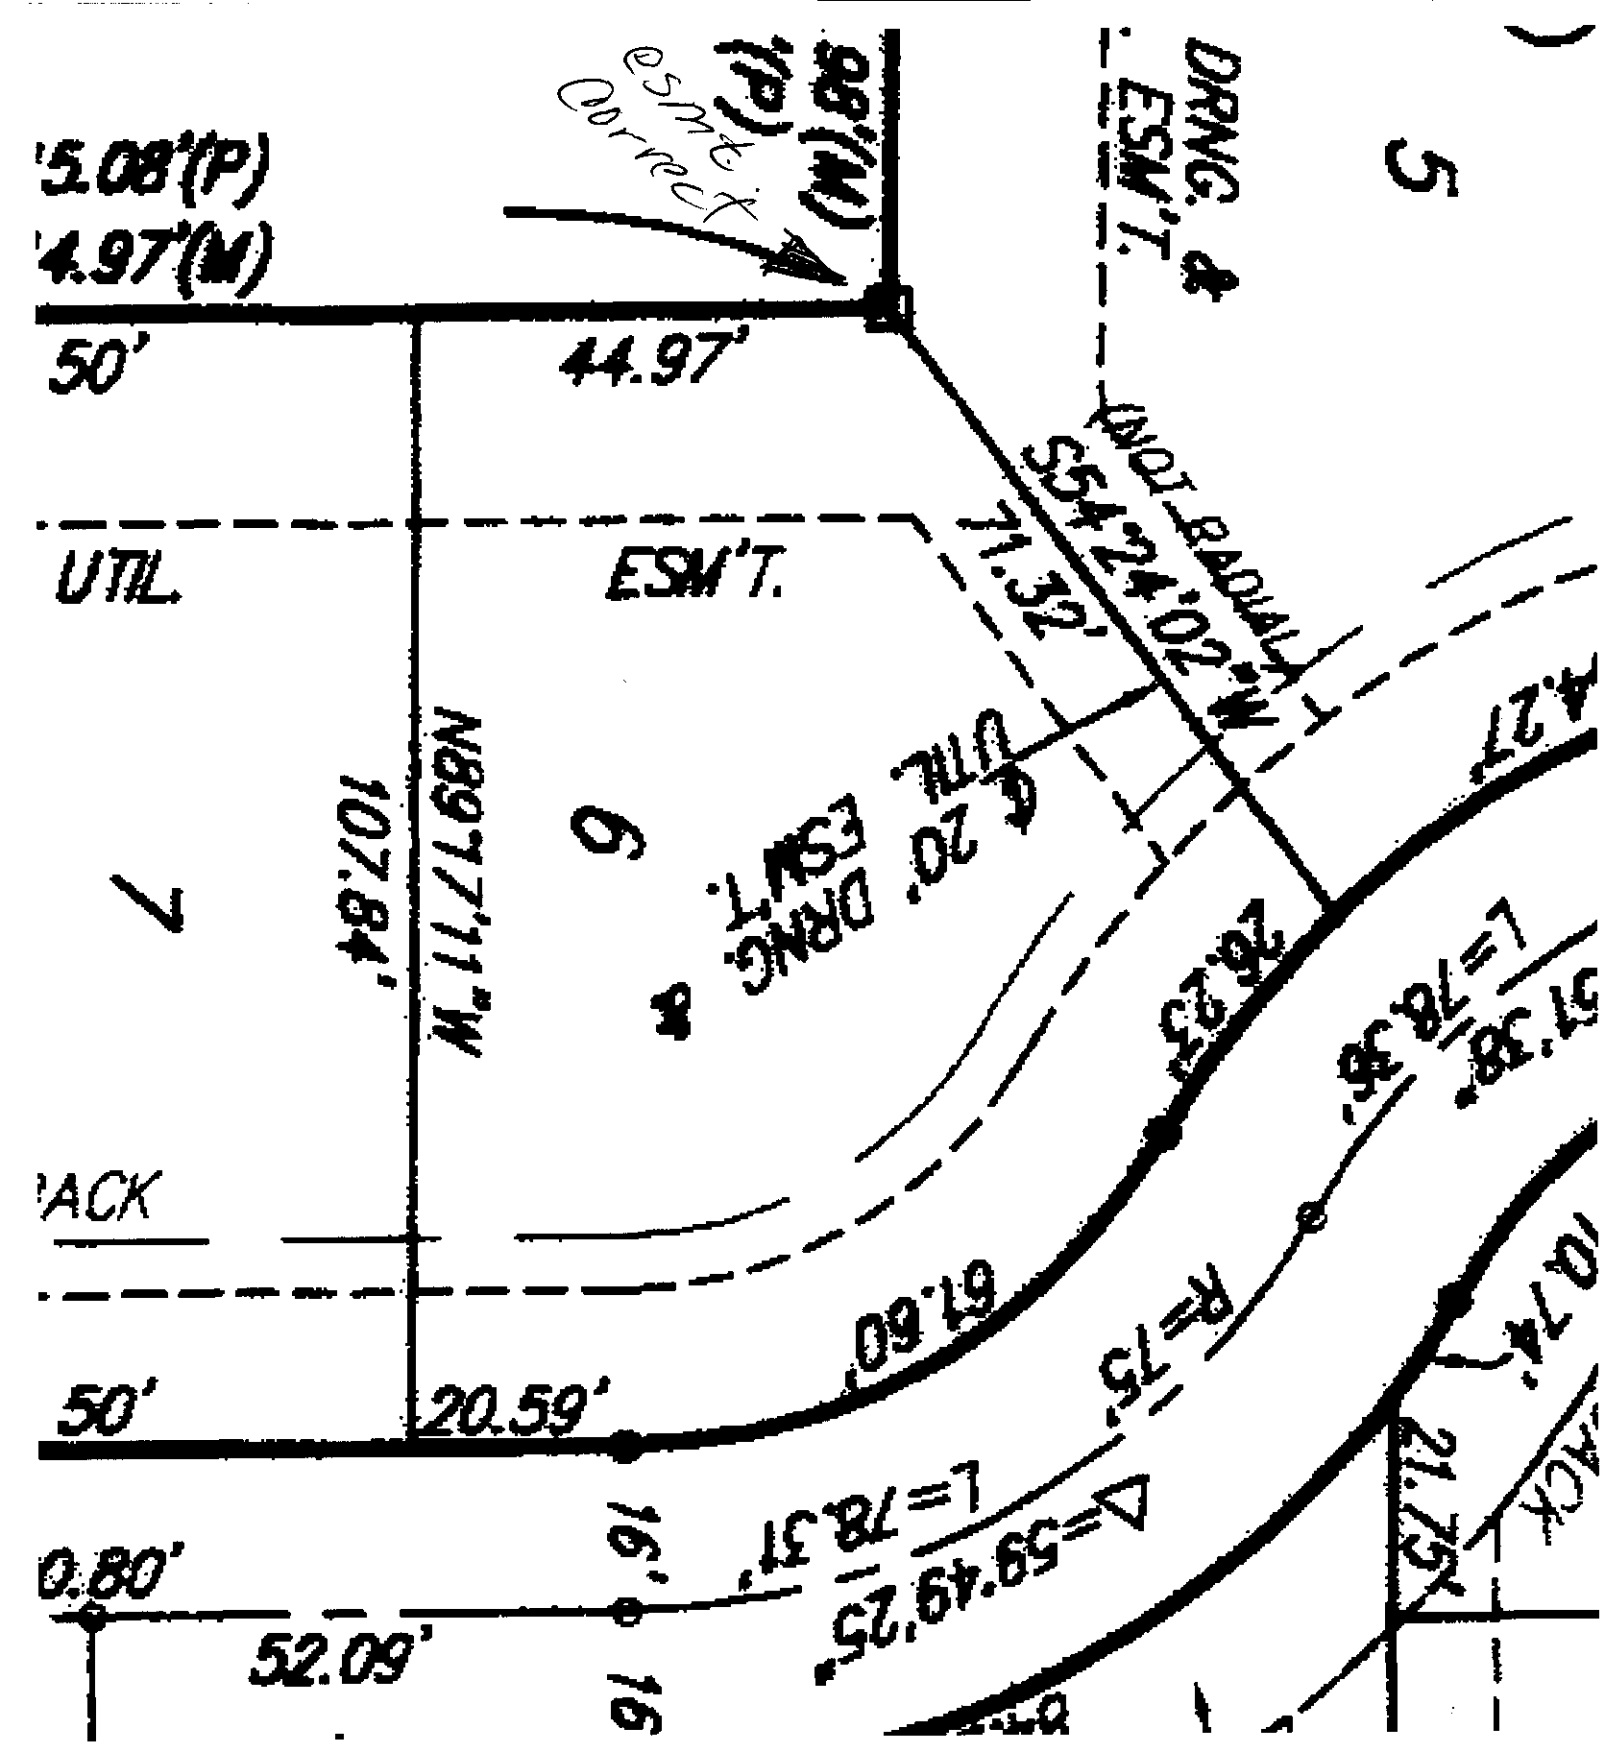
'5.08'(P)
'4.97'(M)
50'
44.97'
UTIL.
ESM'T.
N89°77'11"W
107.84'
7
6
5
20' DRNG. ESM'T.
UTIL.
71.32'
S54°24'02"W
NON RADIAL LINE
DRNG. ESM'T.
26.23'
L=78.36'
57.38'
R=15'
61.60'
'ACK
50'
20.59'
Δ=59°49'25"
L=78.37'
0.80'
52.09'
16'
16
10.74'
21.75'
4.27'
esmt. correct