


Sheet 03-14-2014 3:45:36 PM by BJS
 Plot Scale 1" = 40'-0" (1:480)
 Q:\2013\13438\002\REV1\13438-002-CSC- FOUR CORNER PLAN


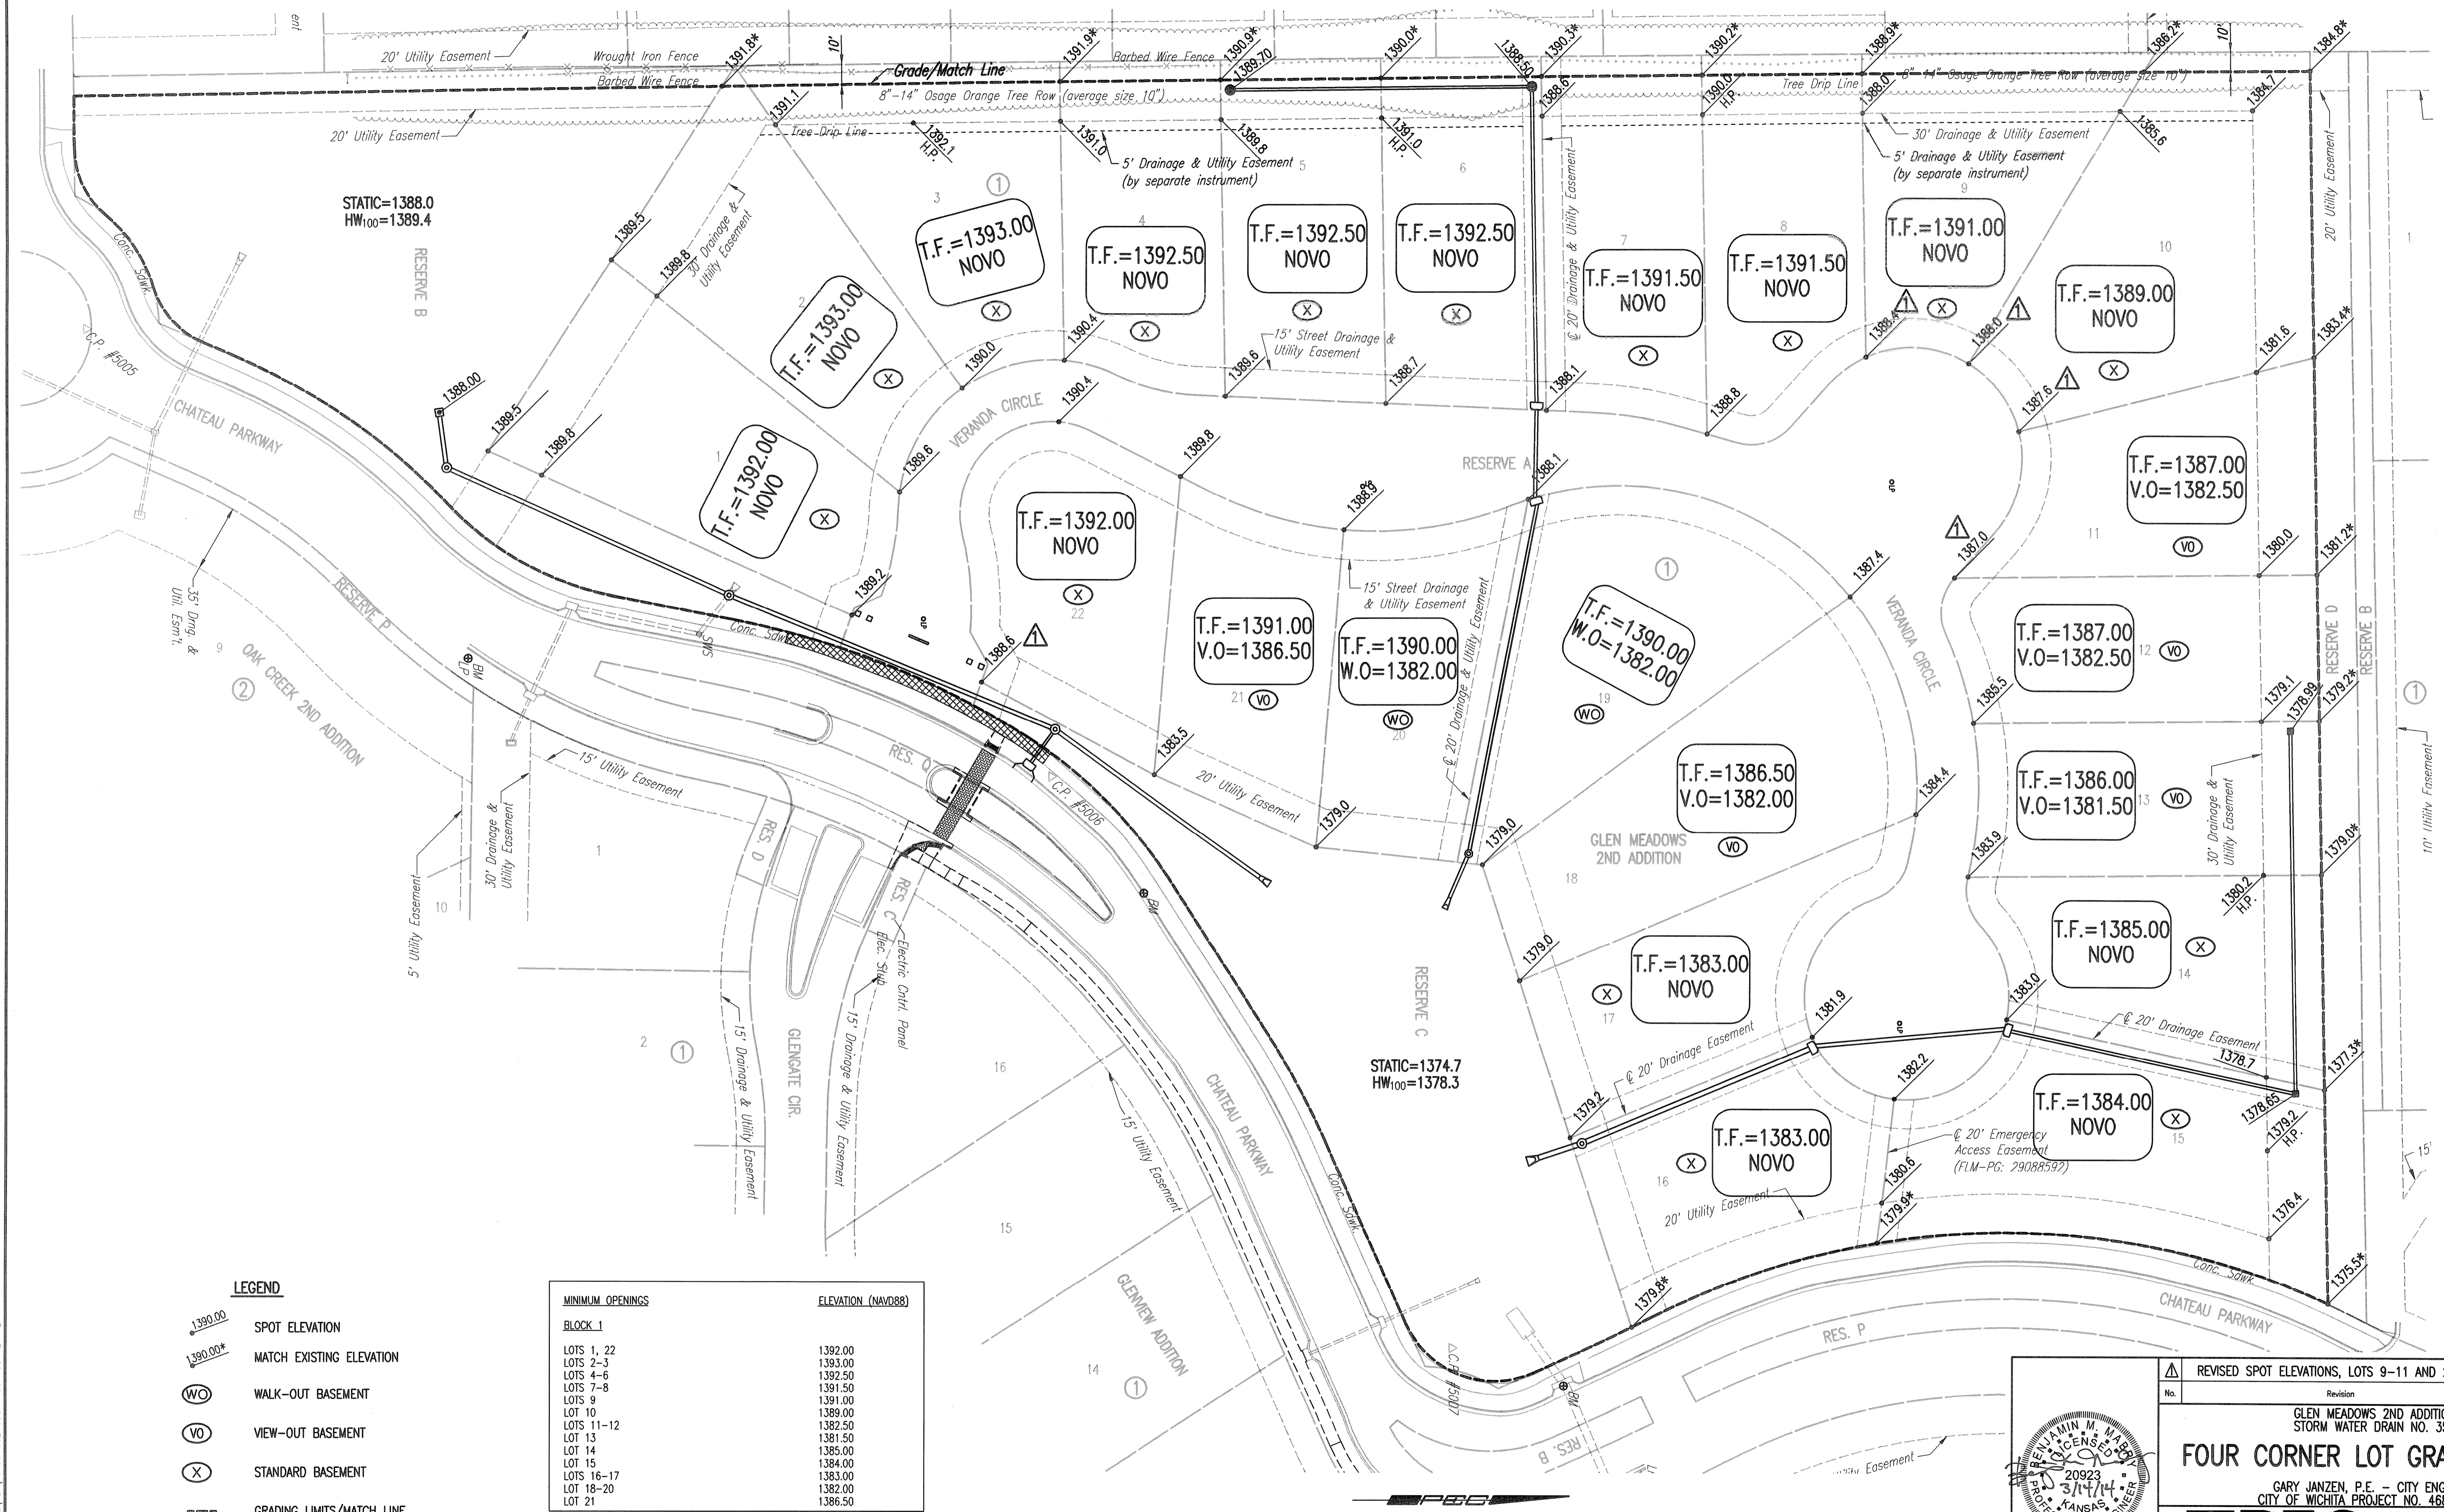


LEGEND

- 1390.00 SPOT ELEVATION
- 1390.00# MATCH EXISTING ELEVATION
- WO WALK-OUT BASEMENT
- VO VIEW-OUT BASEMENT
- X STANDARD BASEMENT
- GRADING LIMITS/MATCH LINE

MINIMUM OPENINGS	ELEVATION (NAVD88)
BLOCK 1	
LOTS 1, 22	1392.00
LOTS 2-3	1393.00
LOTS 4-6	1392.50
LOTS 7-8	1391.50
LOTS 9	1391.00
LOT 10	1389.00
LOTS 11-12	1382.50
LOT 13	1381.50
LOT 14	1385.00
LOT 15	1384.00
LOTS 16-17	1383.00
LOT 18-20	1382.00
LOT 21	1386.50

▲ (SPOT ELEVATIONS AT FRONT OF LOTS 9, 10, 11 AND AT SE CORNER OF LOT 22)

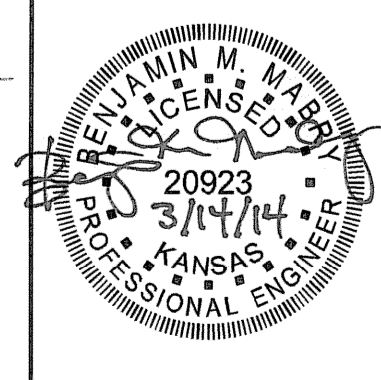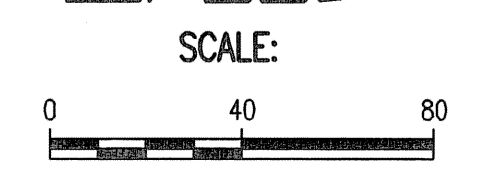

▲ REVISED SPOT ELEVATIONS, LOTS 9-11 AND 22		TBK 3-14-2014
No.	Revision	By Date
GLEN MEADOWS 2ND ADDITION STORM WATER DRAIN NO. 359		
FOUR CORNER LOT GRADING PLAN		
GARY JANZEN, P.E. - CITY ENGINEER CITY OF WICHITA PROJECT NO. 468-84634		
PROFESSIONAL ENGINEERING CONSULTANTS, P.A. 303 SOUTH TOPEKA WICHITA, KS 67202 316-262-2691 www.pec1.com		
Designed by	BMM	Job No. 35-13438-002
Drawn by	BJS	Date September 2013
		Sht. 05 of 28