



NO CHANGES  
IN IMPERVIOUS  
AREA. A EXISTING  
PARKING LOT

6619 E. WARDEN LN.  
WICHITA, KANSAS  
(316) 383-1258

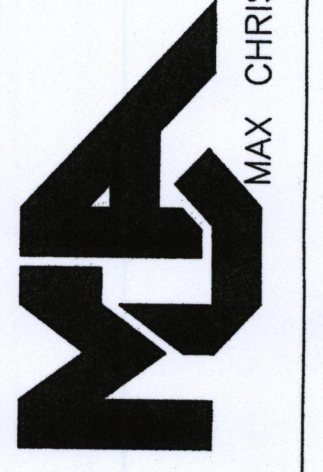

LOS COCOS MEXICAN  
RESTAURANT REMODEL  
1335 N. TYLER RD.  
WICHITA, KANSAS

4-7-14

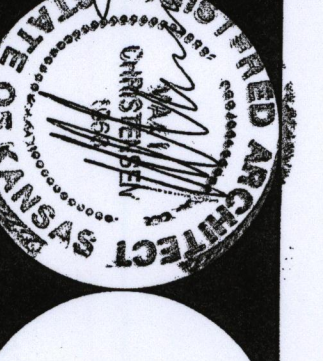

DATE: 4-7-14  
REVISIONS:

SHEET NUMBER:  
SA-1