


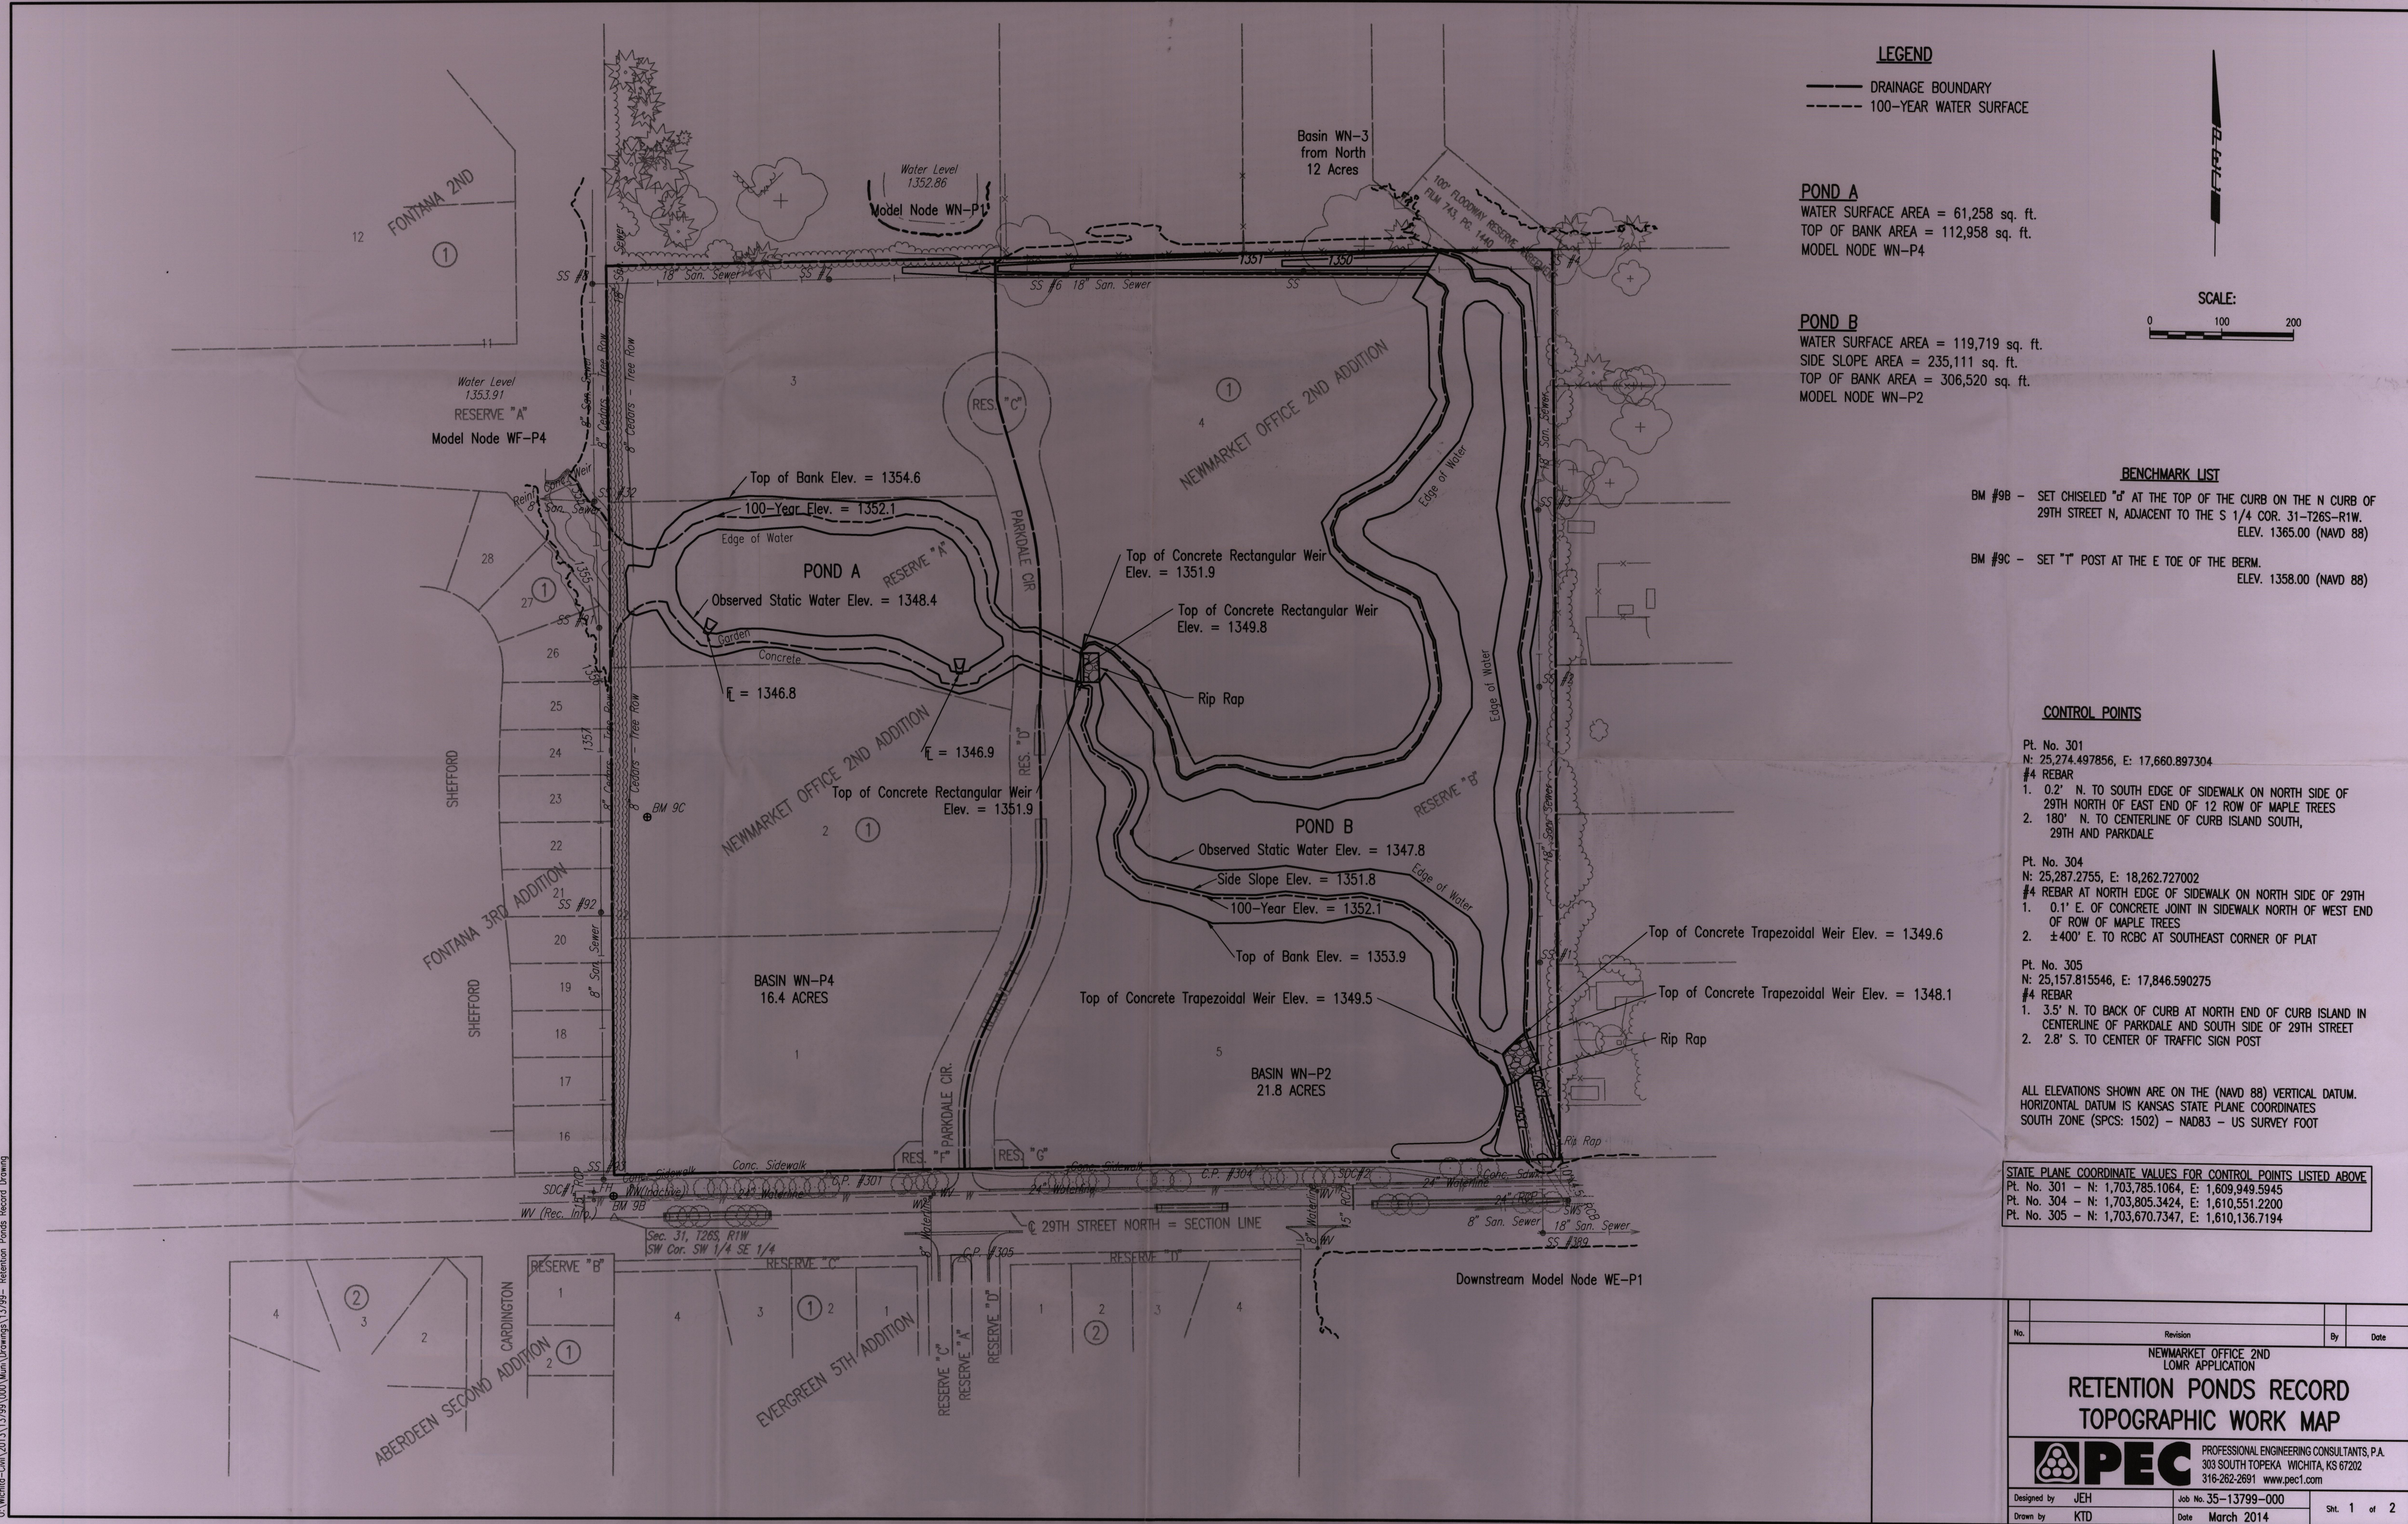

Sheet 1 of 2
Scale: 1" = 200'
Date: 03/14/2014
Author: JEH
Checked: KTD
Title: RETENTION PONDS RECORD TOPOGRAPHIC WORK MAP
Project: 35-13799-000
Revision: 000
Drawing: 000
Sheet: 1 of 2