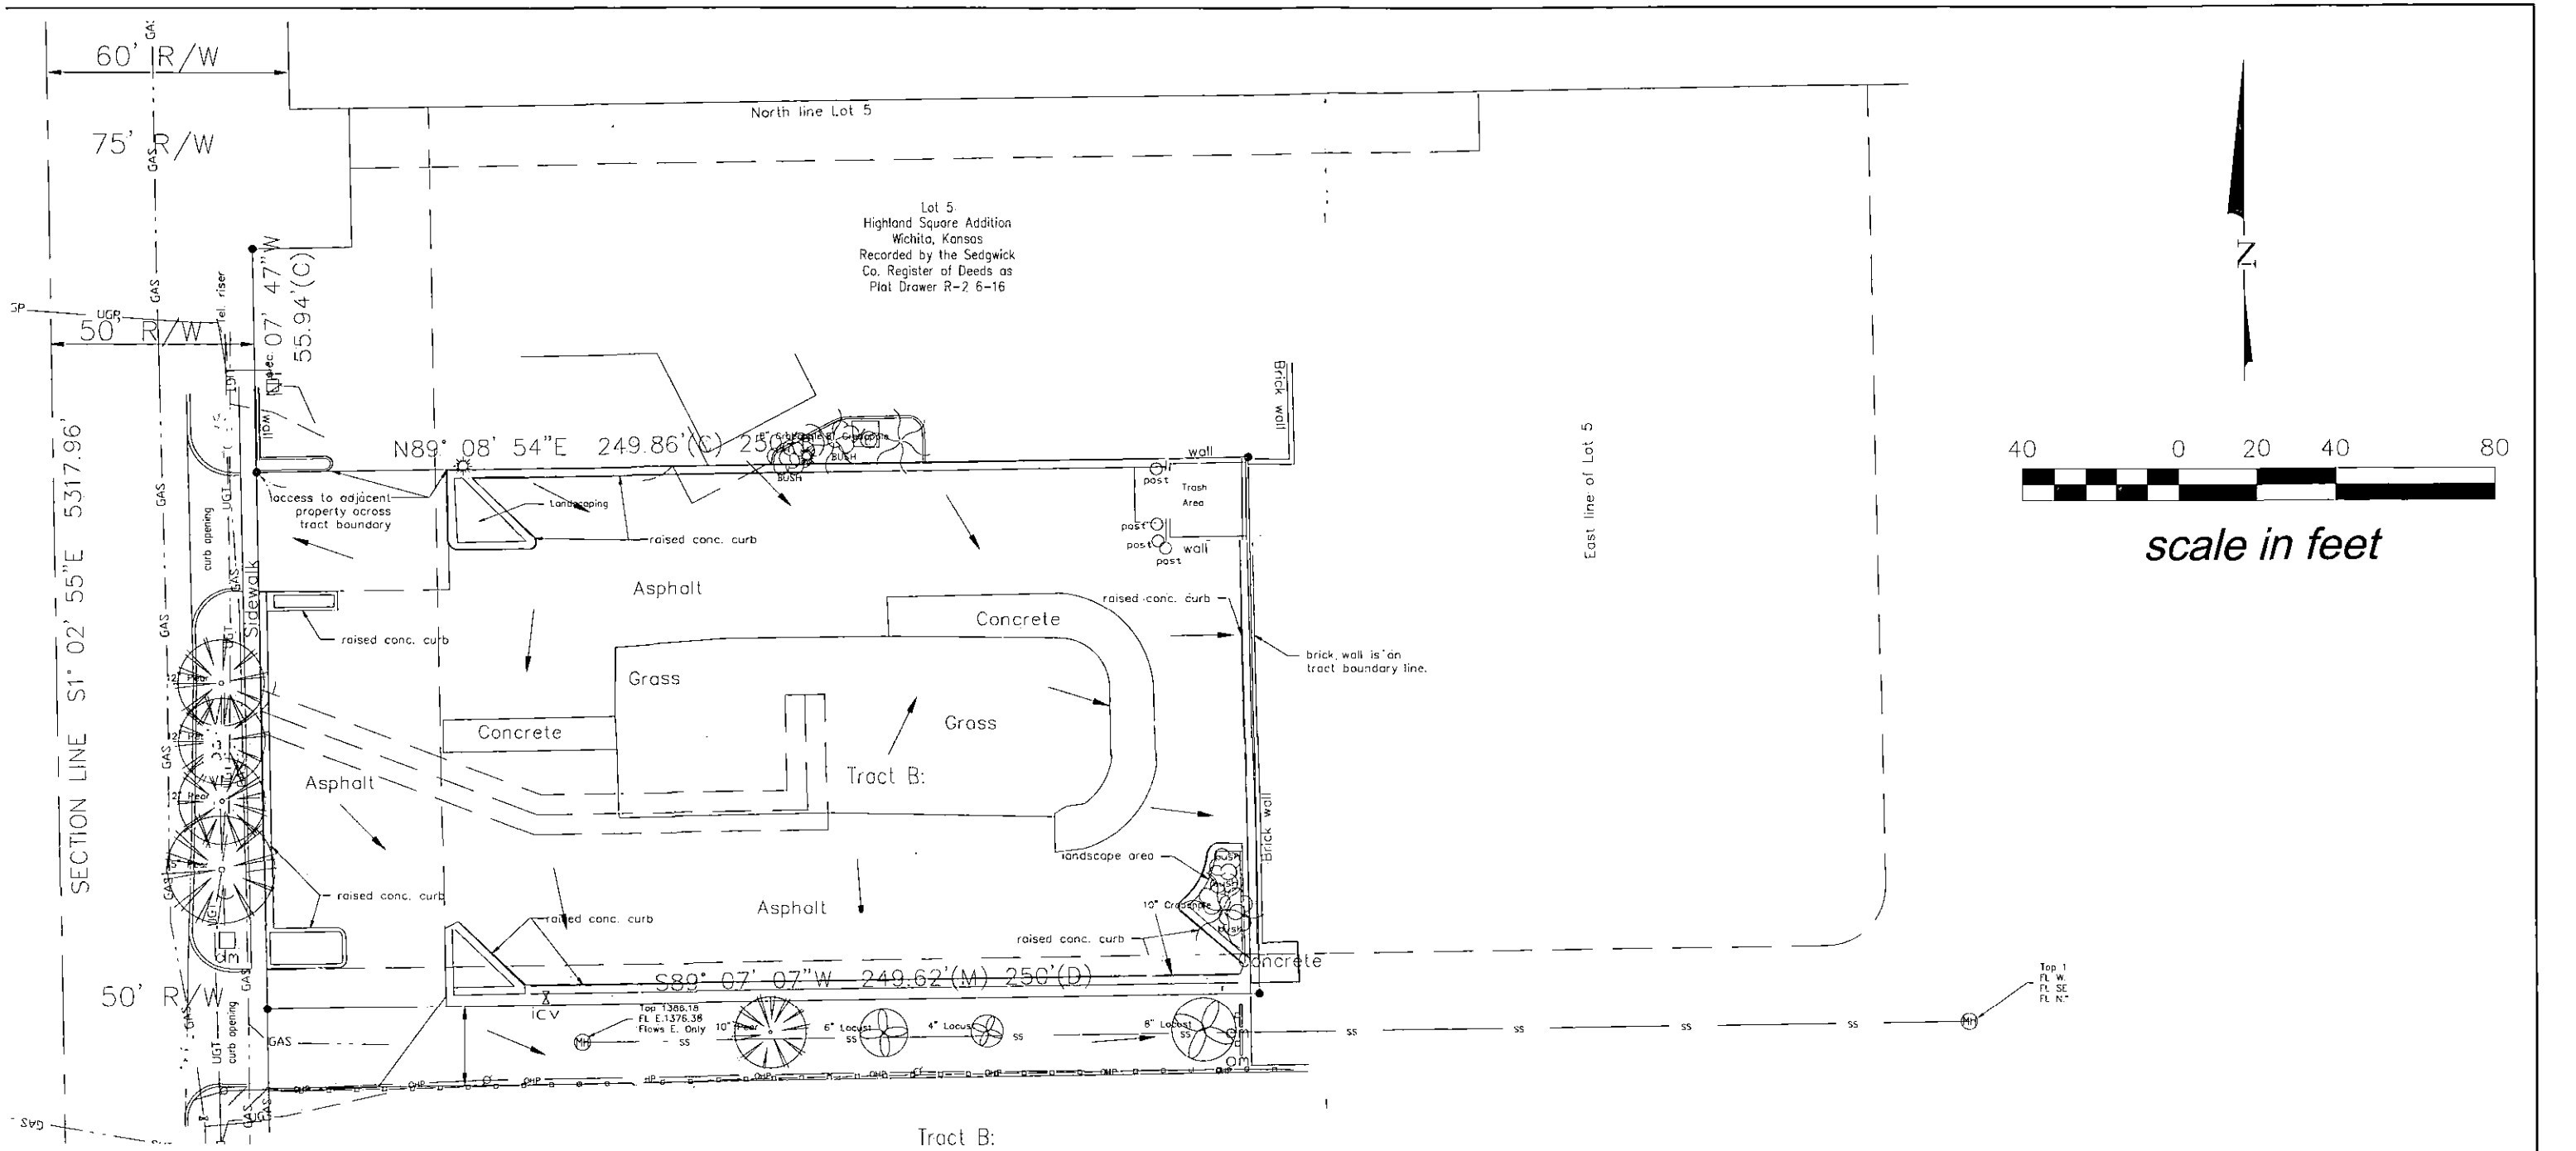

Tract B:
The South 135 feet of the West 250 feet of Lot 5, in HIGHLAND SQUARE ADDITION, Wichita, Sedgwick County, Kansas. Tract contains 33,698.2 square feet ±.

LEGEND

●	Corner point as noted	— GAS —	Gas Line
	Light pole	— UGT —	Underground Telephone cable
	Power Pole	— SS —	Snaitary Sewer Line
	Valve	— OHP —	Overhead Power line
icv	Irrigation control Valve	●	Corner point as noted
MH	Manhole	100.00' (P)	Platted dimension
dm	Anchor pole	100.00' (D)	Deed dimension
	Utility pole anchor	100.00' (C)	Calculated dimension
om	object marker sign	100.00' (M)	Measured dimension

PROJECT NO.	POE & ASSOCIATES, INC. CONSULTING ENGINEERS
102087	5940 E. Central, Suite 200 ■ Wichita, KS 67208-4242 Phone 316/685-4114 ■ FAX 316/685-4444

EXISTING GRADING
Part of Lot 5, Highland Square Addition
Wichita, Sedgwick County, Kansas

DWN BY	PLOT DATE	DRAWING FILE
AM	7/31/2014 8:53:18 AM	F:\APPS\DCA\P\102087\Survey\survey base.dwg