
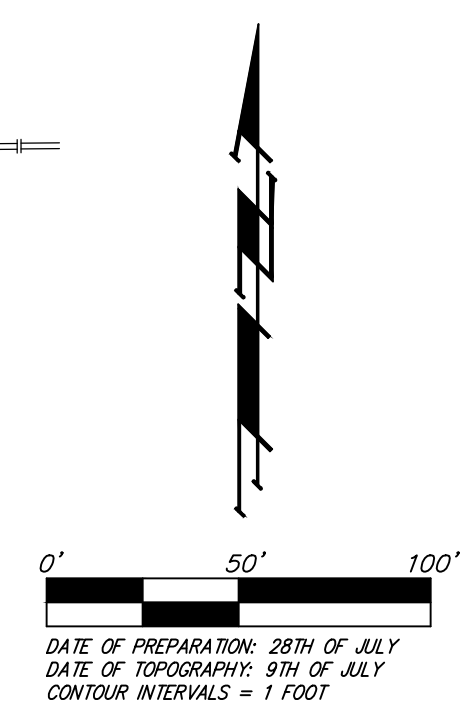


UTILITY PLAN

TYLER'S LANDING 5TH ADDITION

WICHITA, SEDGWICK COUNTY, KANSAS

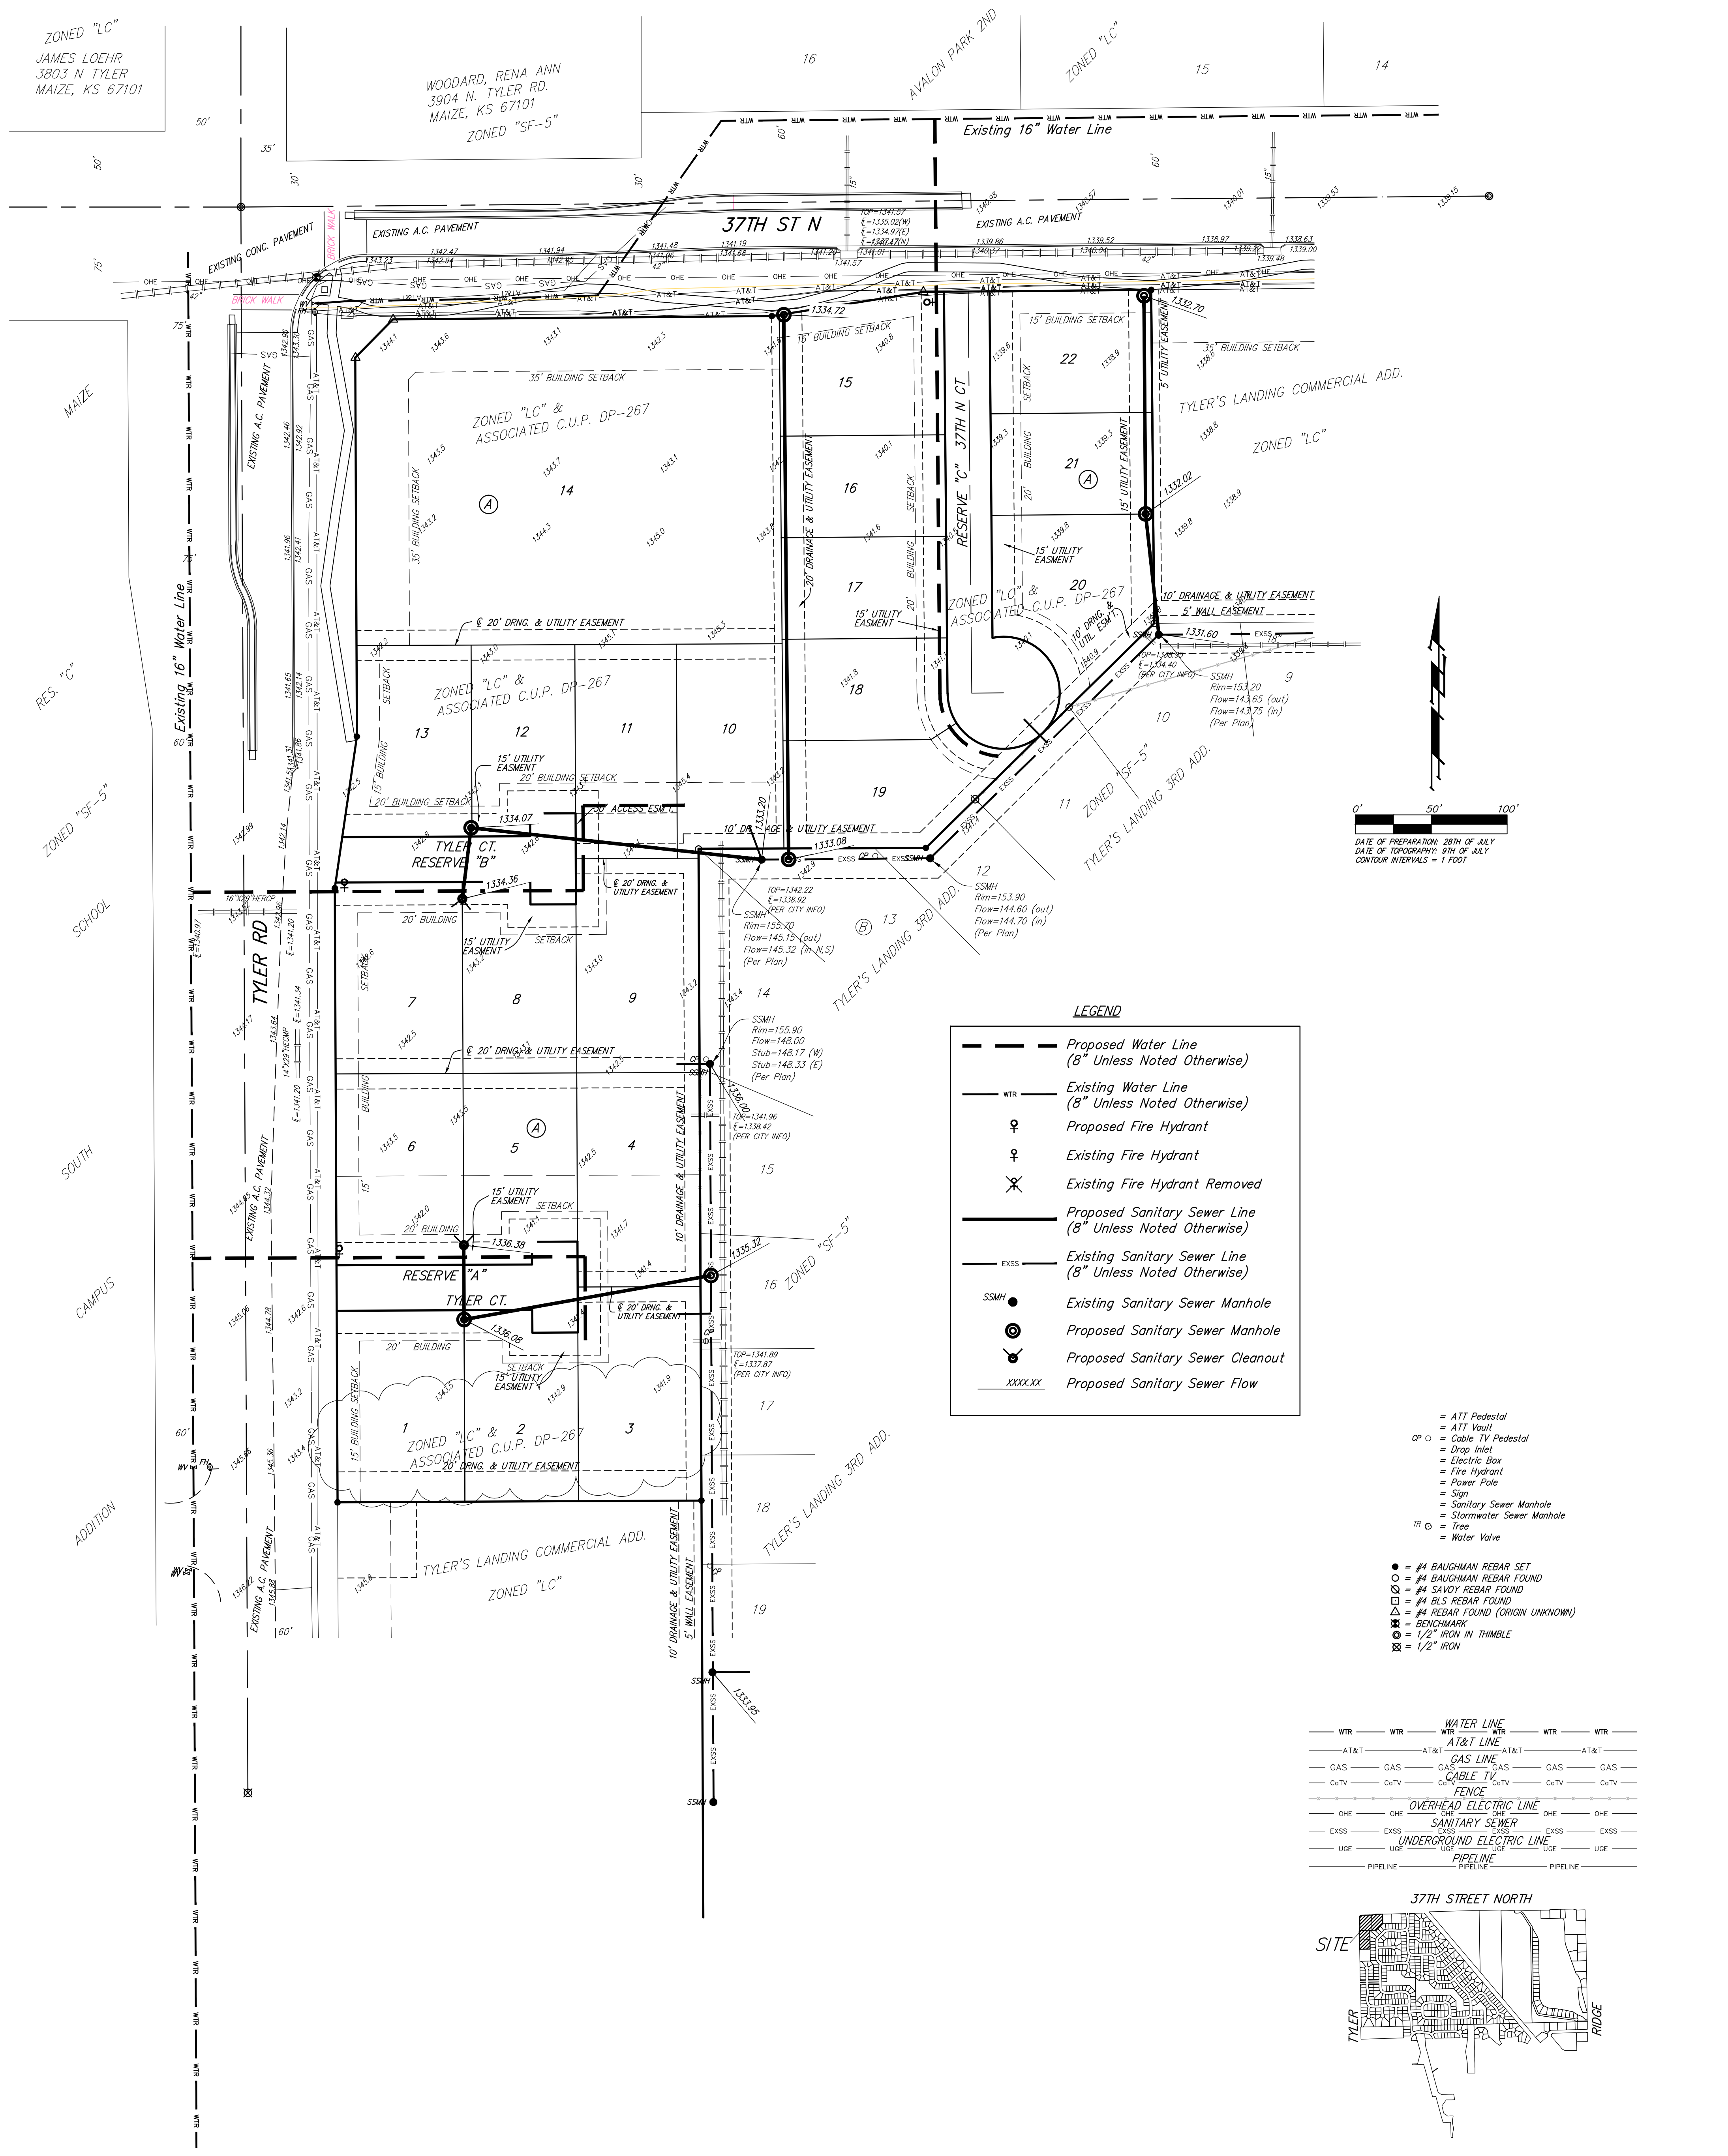


LEGEND

| | |
|--|---|
| | Proposed Water Line (8" Unless Noted Otherwise) |
| | Existing Water Line (8" Unless Noted Otherwise) |
| | Proposed Fire Hydrant |
| | Existing Fire Hydrant |
| | Existing Fire Hydrant Removed |
| | Proposed Sanitary Sewer Line (8" Unless Noted Otherwise) |
| | Existing Sanitary Sewer Line (8" Unless Noted Otherwise) |
| | Existing Sanitary Sewer Manhole |
| | Proposed Sanitary Sewer Manhole |
| | Proposed Sanitary Sewer Cleanout |
| | Proposed Sanitary Sewer Flow |

- = #4 BAUGHMAN REBAR SET
- = #4 BAUGHMAN REBAR FOUND
- = #4 SAVOY REBAR FOUND
- ⊠ = #4 BLS REBAR FOUND
- △ = #4 REBAR FOUND (ORIGIN UNKNOWN)
- ⊗ = BENCHMARK
- ⊗ = 1/2" IRON IN THIMBLE
- ⊗ = 1/2" IRON

| | | | | | | | |
|--|---------------------------|--|----------|--|----------|--|----------|
| | WATER LINE | | WTR | | WTR | | WTR |
| | AT&T LINE | | AT&T | | AT&T | | AT&T |
| | GAS LINE | | GAS | | GAS | | GAS |
| | CABLE TV | | C&TV | | C&TV | | C&TV |
| | OVERHEAD ELECTRIC LINE | | OHE | | OHE | | OHE |
| | SANITARY SEWER | | EXSS | | EXSS | | EXSS |
| | UNDERGROUND ELECTRIC LINE | | UG | | UG | | UG |
| | PIPELINE | | PIPELINE | | PIPELINE | | PIPELINE |

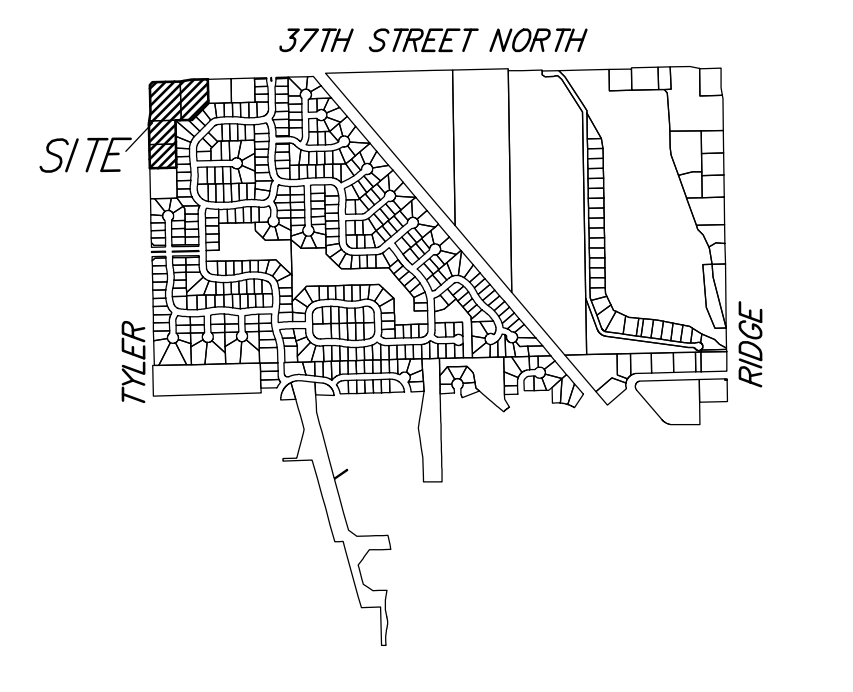

TYLER'S LANDING 5TH ADDITION

16 JULY 2014

Baughman Company, P.A.
315 Ellis St. Wichita, KS 67211 P 316-262-7271 F 316-262-0149
ENGINEERING | SURVEYING | PLANNING | LANDSCAPE ARCHITECTURE