




Saved: 08-05-2015 1:00:01 PM by JTS
 Plot Scale: 1" = 40'-0" (1:1600)
 G:\2013\13438\002\13438-002-056-REVISED CSB FOUR CORNER PLAN

REVISED 10-21-2014
 REVISED 08-05-2015

LEGEND

- SPOT ELEVATION
- MATCH EXISTING ELEVATION
- WALK-OUT BASEMENT
- VIEW-OUT BASEMENT
- STANDARD BASEMENT
- GRADING LIMITS/MATCH LINE

| MINIMUM PAD (LOWEST OPENING) | PER PLAT ELEVATION (NAVD88) | PER AFFIDAVIT OF PLAT CORRECTION FILM/PG 29546481 |
|------------------------------|-----------------------------|--|
| BLOCK 1 | | |
| LOTS 1, 22 | 1392.00 | 1391.40 |
| LOTS 2, 3 | 1393.00 | 1391.40 |
| LOT 4 thru 6 | 1392.50 | NO MINIMUM PAD REQUIRED |
| LOTS 7, 8 | 1391.50 | NO MINIMUM PAD REQUIRED |
| LOTS 9 | 1391.00 | NO MINIMUM PAD REQUIRED |
| LOT 10 | 1389.00 | NO MINIMUM PAD REQUIRED |
| LOTS 11, 12 | 1382.50 | NO MINIMUM PAD REQUIRED |
| LOT 13 | 1381.50 | NO MINIMUM PAD REQUIRED |
| LOT 14 | 1385.00 | NO MINIMUM PAD REQUIRED |
| LOT 15 | 1384.00 | NO MINIMUM PAD REQUIRED |
| LOTS 16, 17 | 1382.00 | 1380.30 |
| LOTS 18 THRU 20 | 1382.00 | 1380.30 |
| LOT 21 | 1386.50 | 1380.30 |

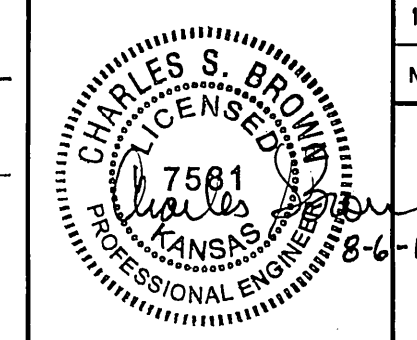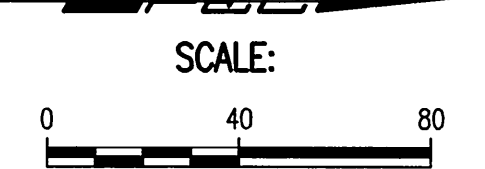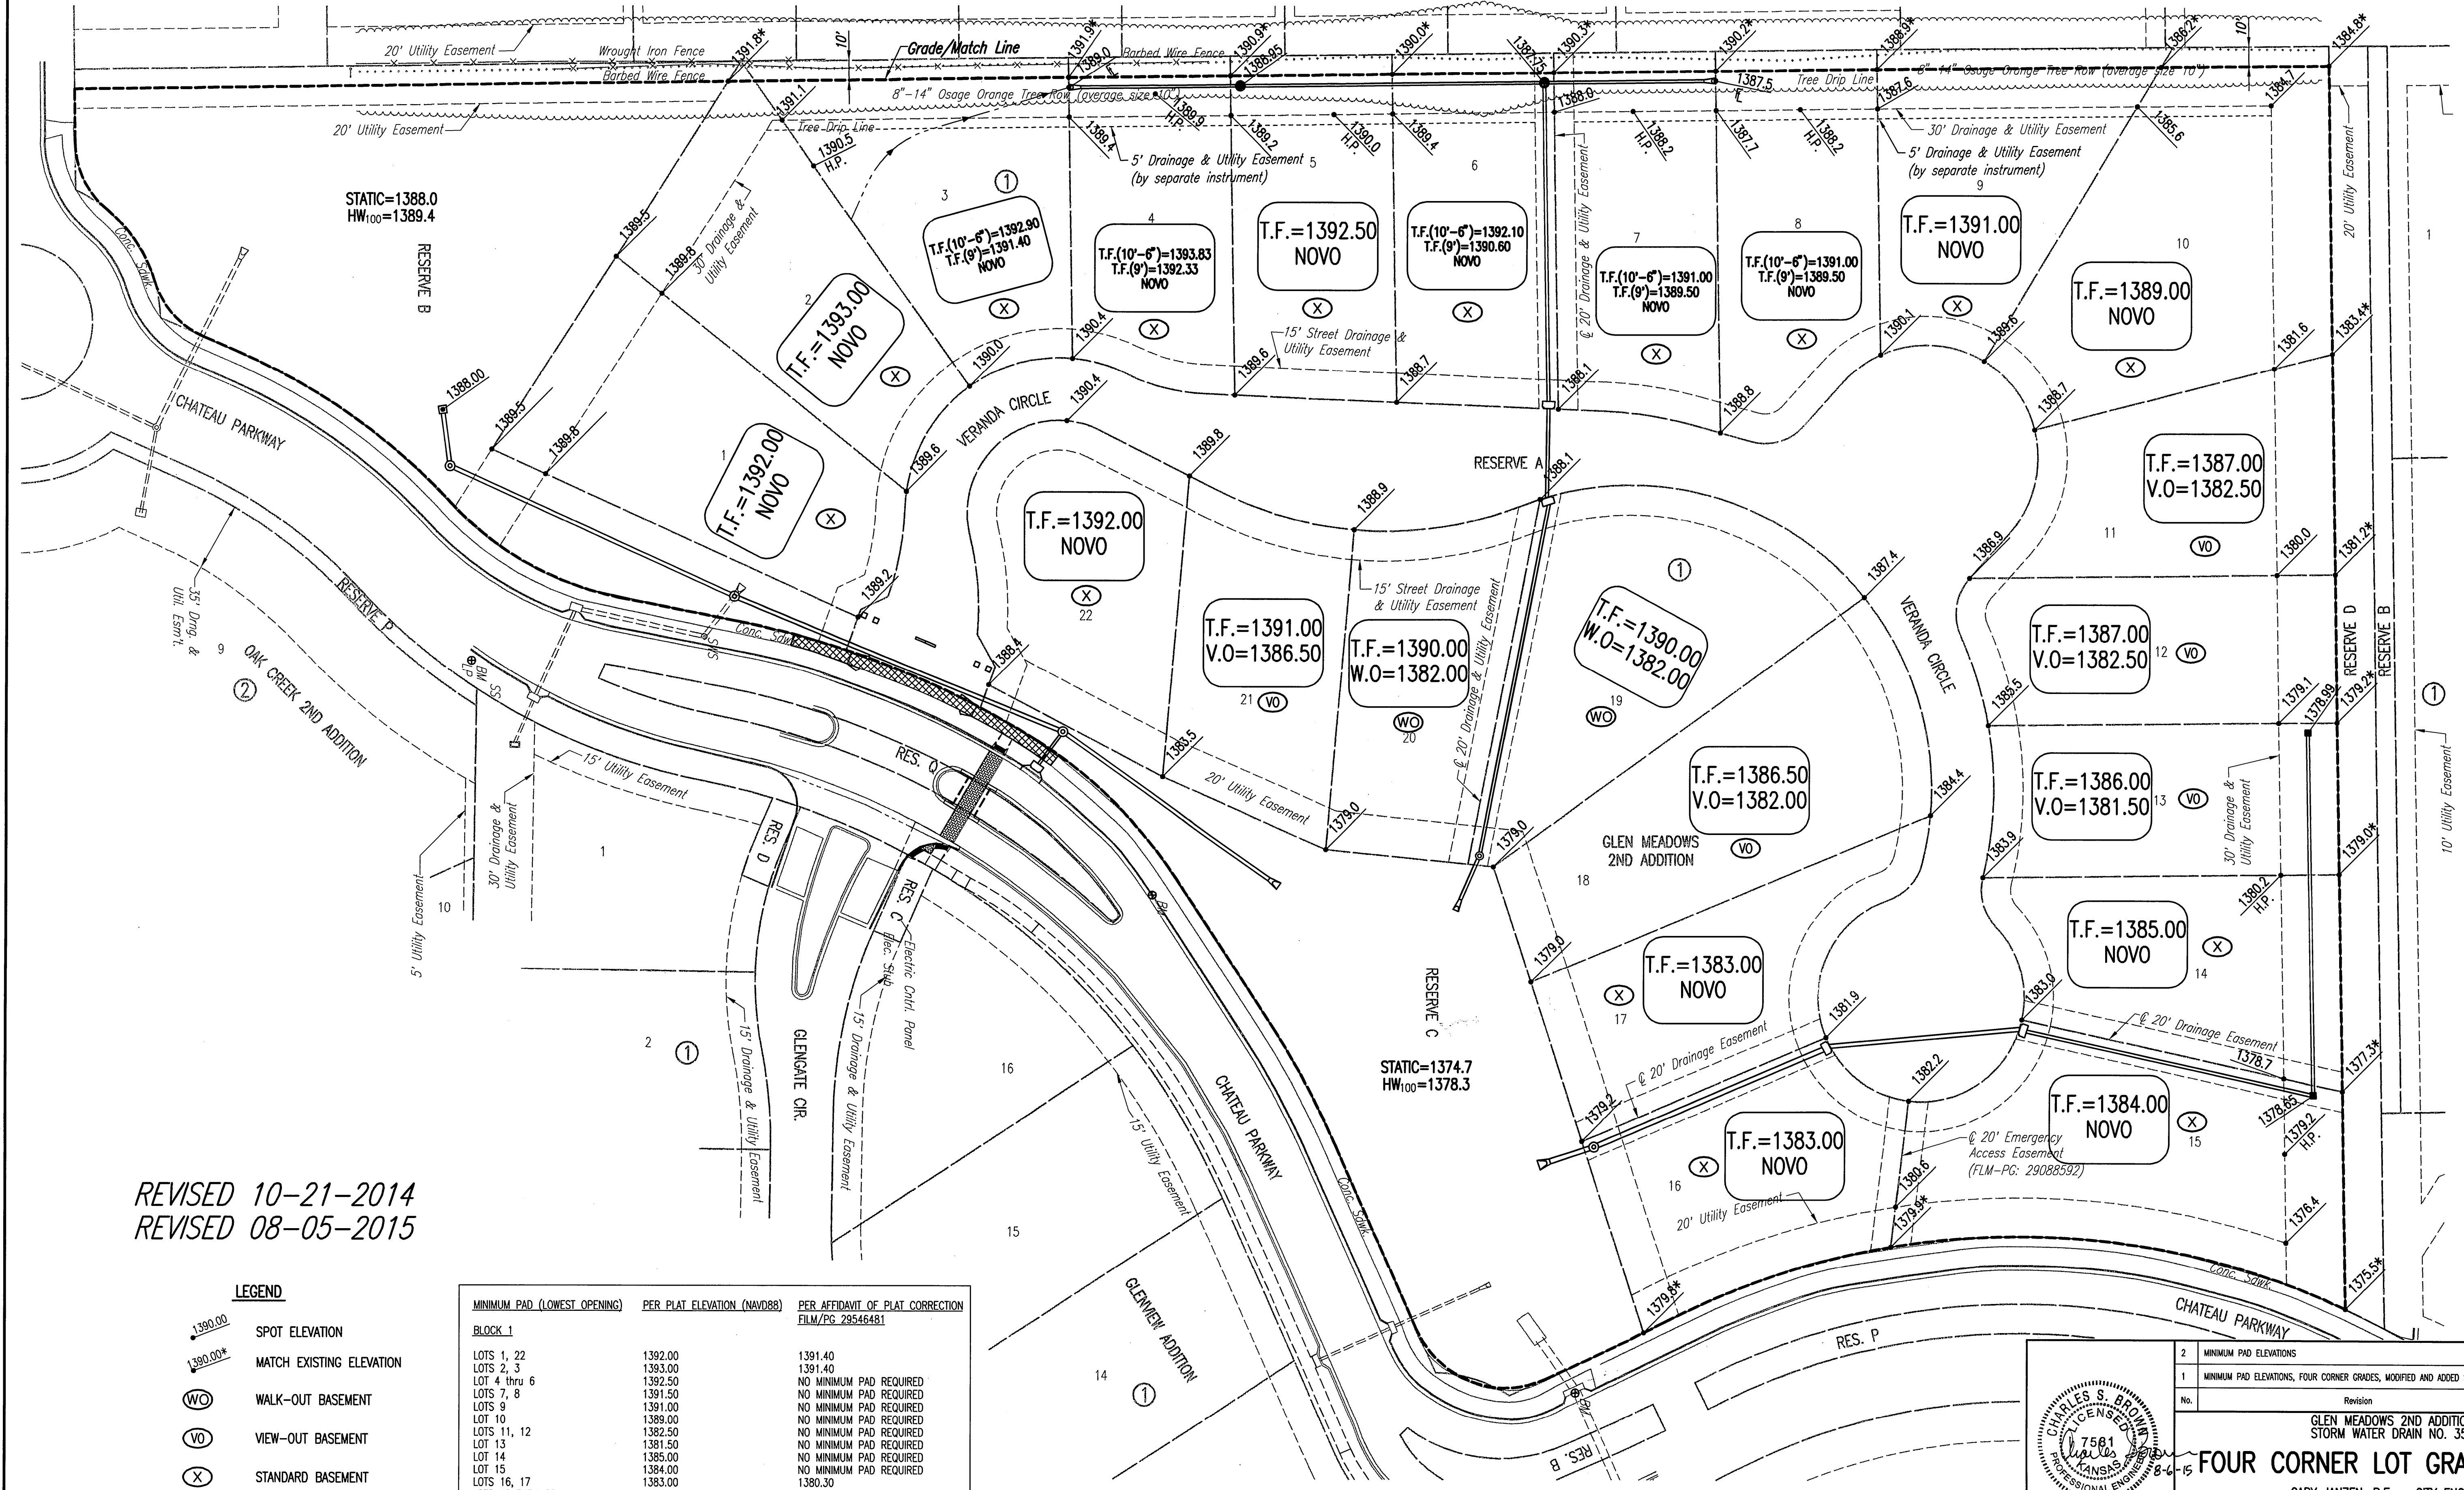

| | | | |
|--|--|----------------------|----------------|
| 2 | MINIMUM PAD ELEVATIONS | CSB | 08-05-2015 |
| 1 | MINIMUM PAD ELEVATIONS, FOUR CORNER GRADES, MODIFIED AND ADDED STORM SEWER | CSB | 10-21-2014 |
| No. | Revision | By | Date |
| GLEN MEADOWS 2ND ADDITION STORM WATER DRAIN NO. 359 | | | |
| FOUR CORNER LOT GRADING PLAN | | | |
| GARY JANZEN, P.E. - CITY ENGINEER CITY OF WICHITA PROJECT NO. 468-84634 | | | |
| PEC PROFESSIONAL ENGINEERING CONSULTANTS, P.A. 303 SOUTH TOPEKA WICHITA, KS 67202 316-262-2691 www.pec1.com | | | |
| Designed by | BMM | Job No. 35-13438-002 | Sht. 05 of 28 |
| Drawn by | BJS, JTS | Date | September 2013 |