UTILITY PLAN

MONARCH LANDING 4TH ADDITION

AN ADDITION TO WICHITA, SEDGWICK COUNTY, KANSAS

0' 100' 200'

DATE OF PREPARATION: 9TH MAY 2016
DATE OF TOPOGRAPHY:
CONTOUR INTERVALS = 1 FOOT

CB = Catch Basin
CP = Cable TV Pedestal
EB = Electric Box
FH = Fire Hydrant
Guy = Guy Anchor
GV = Gas Valve
LP = Light Pole
PM = Pipeline Marker
PP = Power Pole
Sign = Sign
SSMH = Sanitary Sewer Manhole
ATTMH = ATT Manhole
ATT Ped = ATT Pedestal
TB = Traffic Box
TMH = Traffic Manhole
WV = Water Valve
TR = Tree

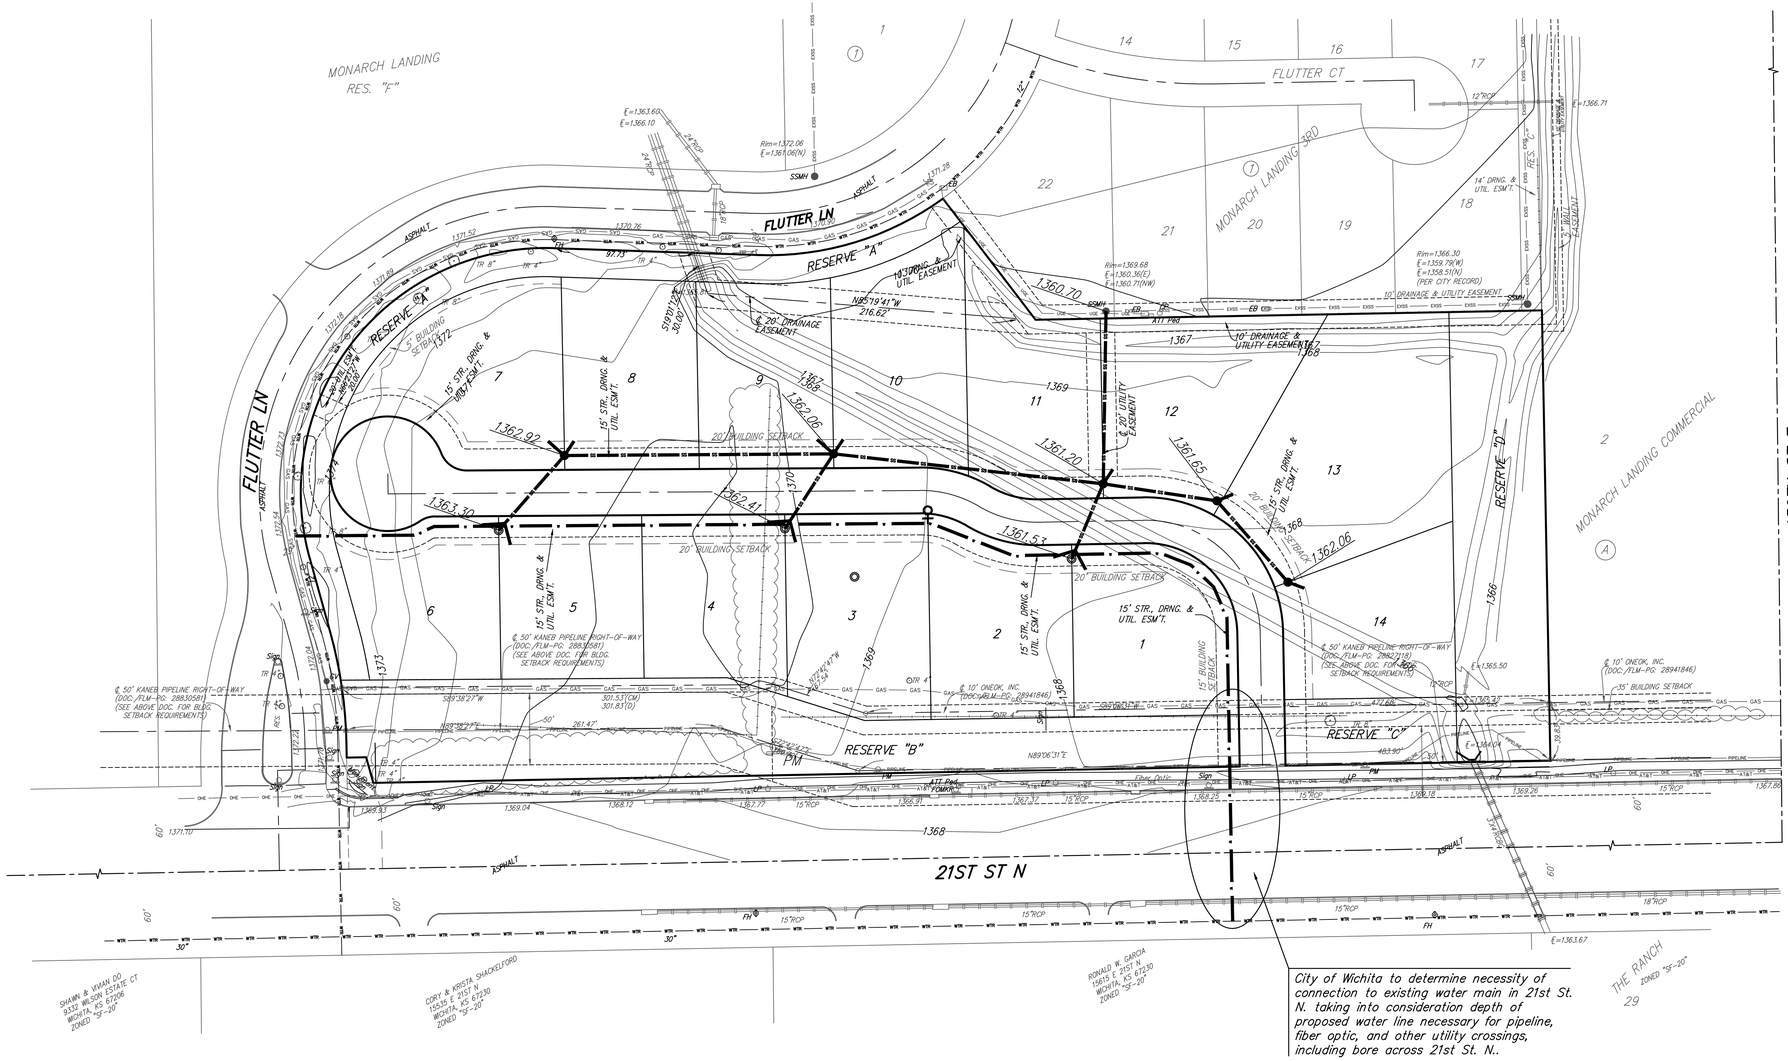

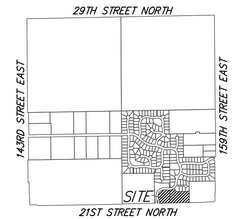

VICINITY MAP
SEC. 1, T27S, R2E

WATER LINE
AT&T LINE
GAS LINE
CABLE TV
FENCE
OVERHEAD ELECTRIC LINE
SANITARY SEWER
UNDERGROUND ELECTRIC LINE
PIPELINE

LEGEND

- Proposed Water Line (8" Unless Noted Otherwise)
- Existing Water Line (8" Unless Noted Otherwise)
- Proposed Fire Hydrant
- Existing Fire Hydrant
- Proposed Sanitary Sewer Line (8" Unless Noted Otherwise)
- Existing Sanitary Sewer Line (8" Unless Noted Otherwise)
- Existing Sanitary Sewer Manhole
- Proposed Sanitary Sewer Manhole
- Proposed Sanitary Sewer Cleanout

UTILITY PLAN
MONARCH LANDING 4TH ADDITION
13 Feb 2017

Baughman Company , P.A.
315 Ellis St. Wichita, KS 67211 P 316-262-7271 F 316-262-0149
Baughman ENGINEERING | SURVEYING | PLANNING | LANDSCAPE ARCHITECTURE

E:\Projects\Monarch Landing 4th Add_16-03-P185\Engineering\Utility Plan\Monarch Landing 4th_Util Plan.dwg