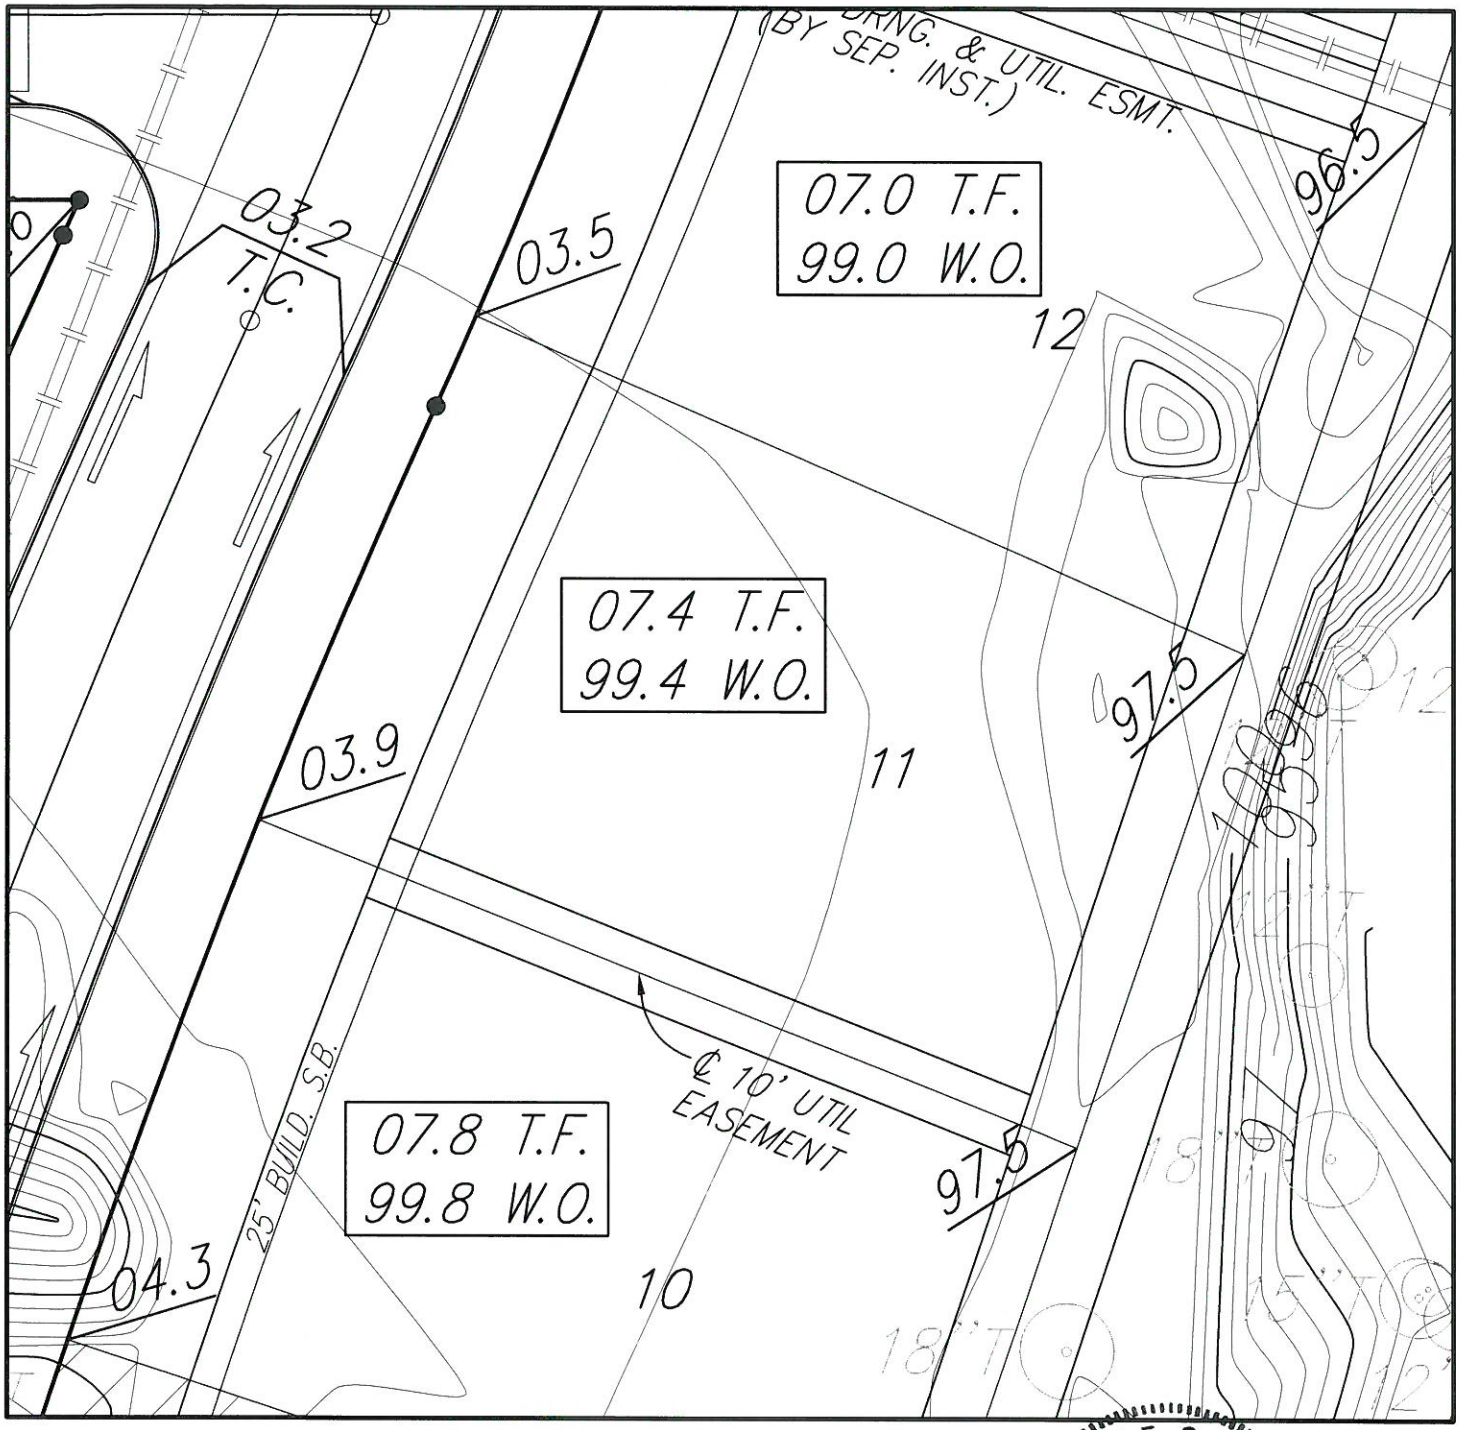

General Notes:

1. Staking Dimensions are shown for representation only.
2. It shall be the Builder's responsibility to ensure that the final location of the house conforms to all applicable setbacks.
3. Any changes in elevations shown on this plan must be approved by the Developer or his Authorized Representative.

AUSTIN E. GOTTLOB
LICENSED
17919
3/2/17
KANSAS
PROFESSIONAL ENGINEER

1" = 30'

Lot Grade Revision

Location:
Lot 11, Block D
Blue Lake Addition

Prepared For:
[redacted]
Phone: 393-1617 Fax: n\a

Benchmark:

File Location:

Baughman Company, P.A.
315 Ellis St. Wichita, KS 67211 P 316-262-7271 F 316-262-0149
Baughman ENGINEERING | SURVEYING | PLANNING | LANDSCAPE ARCHITECTURE

Date Drawn:	Drawn By:	Project Number:
03/02/07	AEG	
Reviewed By:	**Approved By:**	**Page 1 of 1**