


# DRAINAGE PLAN


## EDGE WATER 3RD ADDITION

### WICHITA, SEDGWICK COUNTY, KANSAS

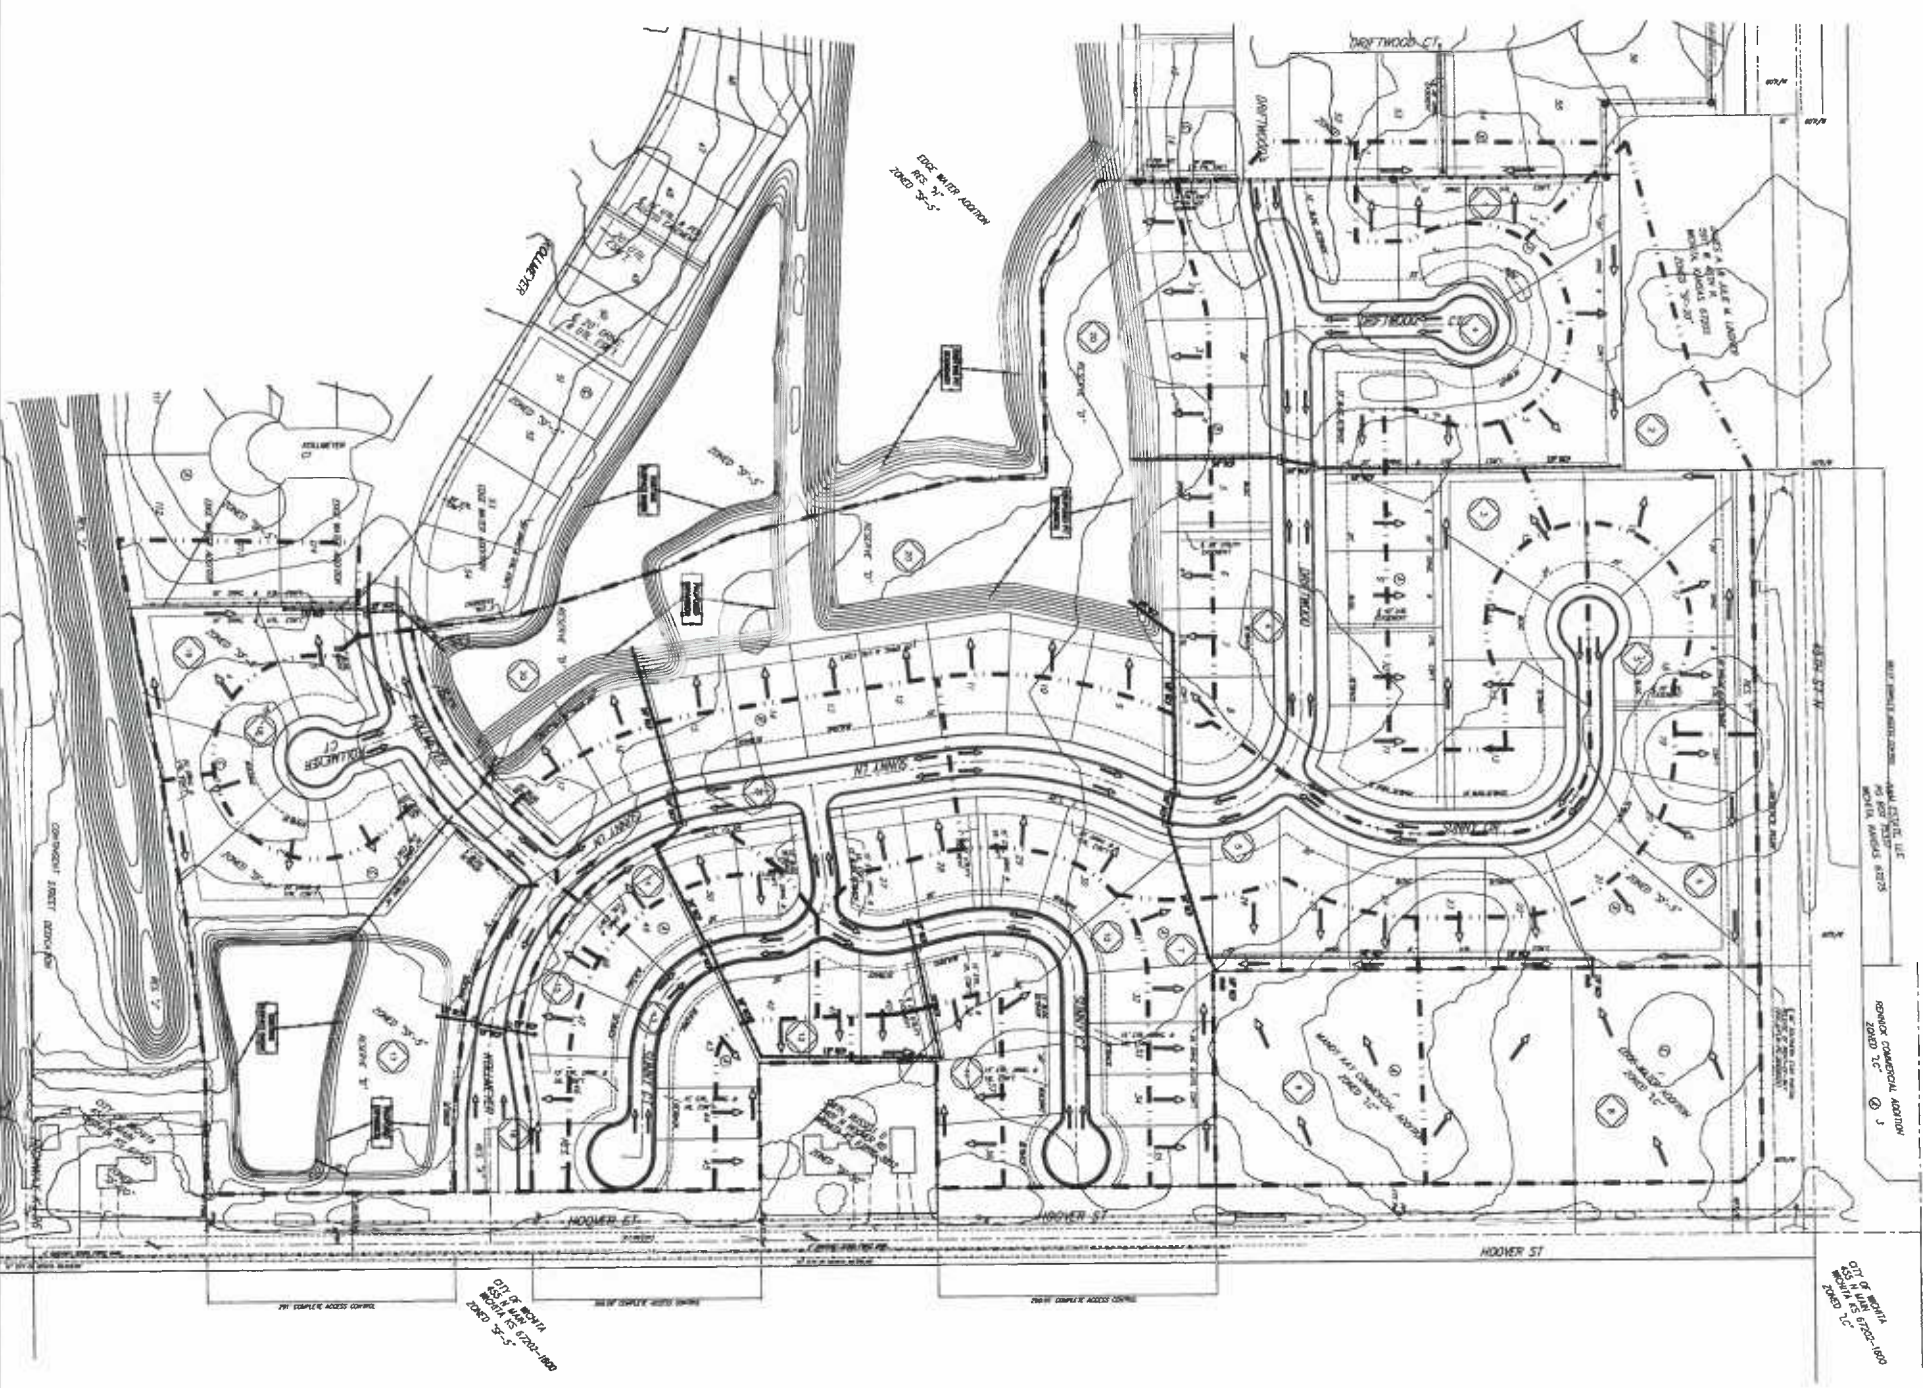


Basin ID	Area (Ac)	Developed Flowrates		
		2-yr CWA	10-yr CWA	100-yr CWA
1	1.1	7.1	7.1	7.1
2	1.3	4.2	4.2	4.2
3	1.3	5.2	4.2	7.3
4	6.8	11	18	31
5	3.4	4.5	1.2	20
6	1.2	2.3	3.5	6.7
7	1.1	2.1	3.4	4.2
8	2.2	4.4	7.4	13
9	1.4	2.7	4.5	7.8
10	2.2	4.4	7.4	13
11	3.2	6.4	11	20
12	1.7	3.3	4.2	6.2
13	0.2	0.2	1.0	1.7
14	0.4	0.8	1.3	2.2
15	0.4	0.8	1.3	2.2
16	0.6	1.1	1.5	3.4
17	3.2	6.1	10	18
18	1.5	2.5	4.5	8.4
19	1.1	2.1	3.5	6.2
20	2.9	5.1	9	16
21	2.0	3.8	6.2	11
<b>TOTAL</b>	<b>30.2</b>	<b>73</b>	<b>127</b>	<b>229</b>

MAIN DRAINAGE BASIN	

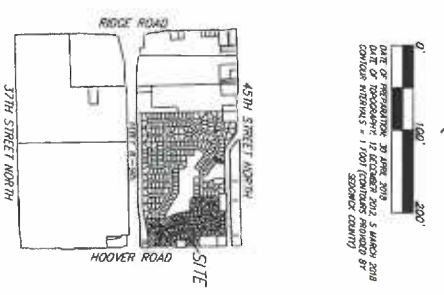

BOUNDARIES IN RED: EDGE OF POWER POLE  
 50' WEST OF THE SOUTHWEST CORNER OF  
 RESERVE 'C'. DO NOT WATER AND  
 ELEVATION = 1135.24 (NOV03)

**NOTES:** There is no SWA pool located on the property at this site.  

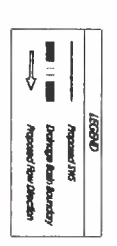

*add a note*  
*Are all elevations shown are NAVD83?*  
*I see the plot calls*  
*lot grade is NAVD29*  
*For modern standards other*  
*may be using NAD83*  
*ADD NAVD83 TO PLOT TITLE*