
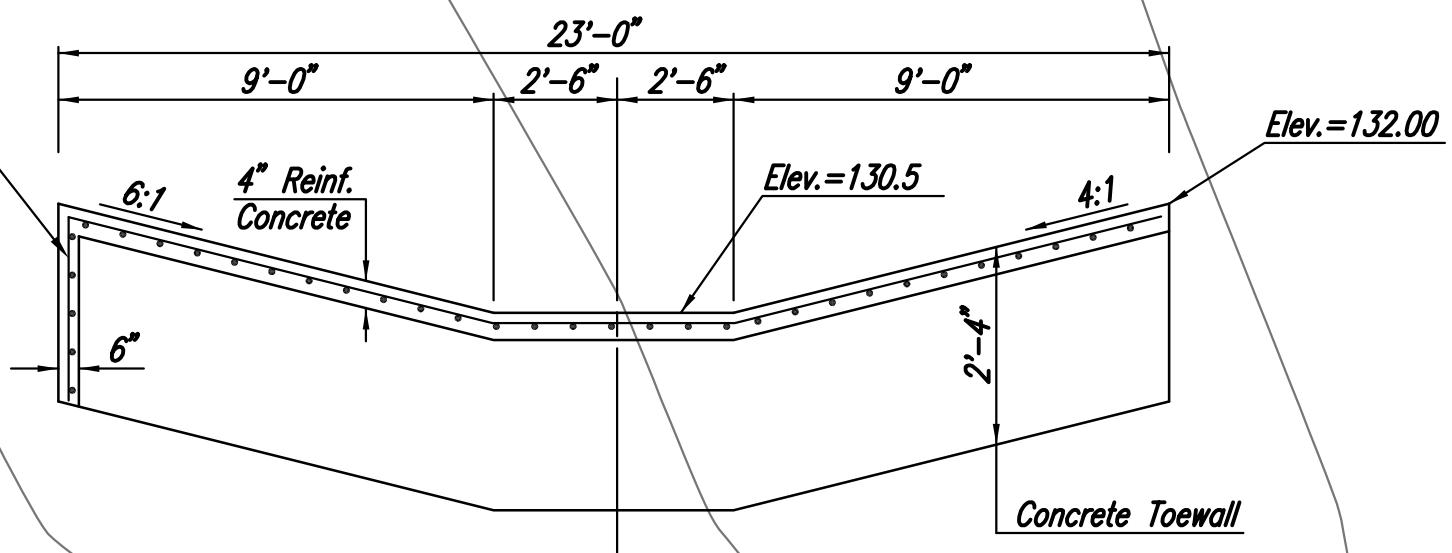
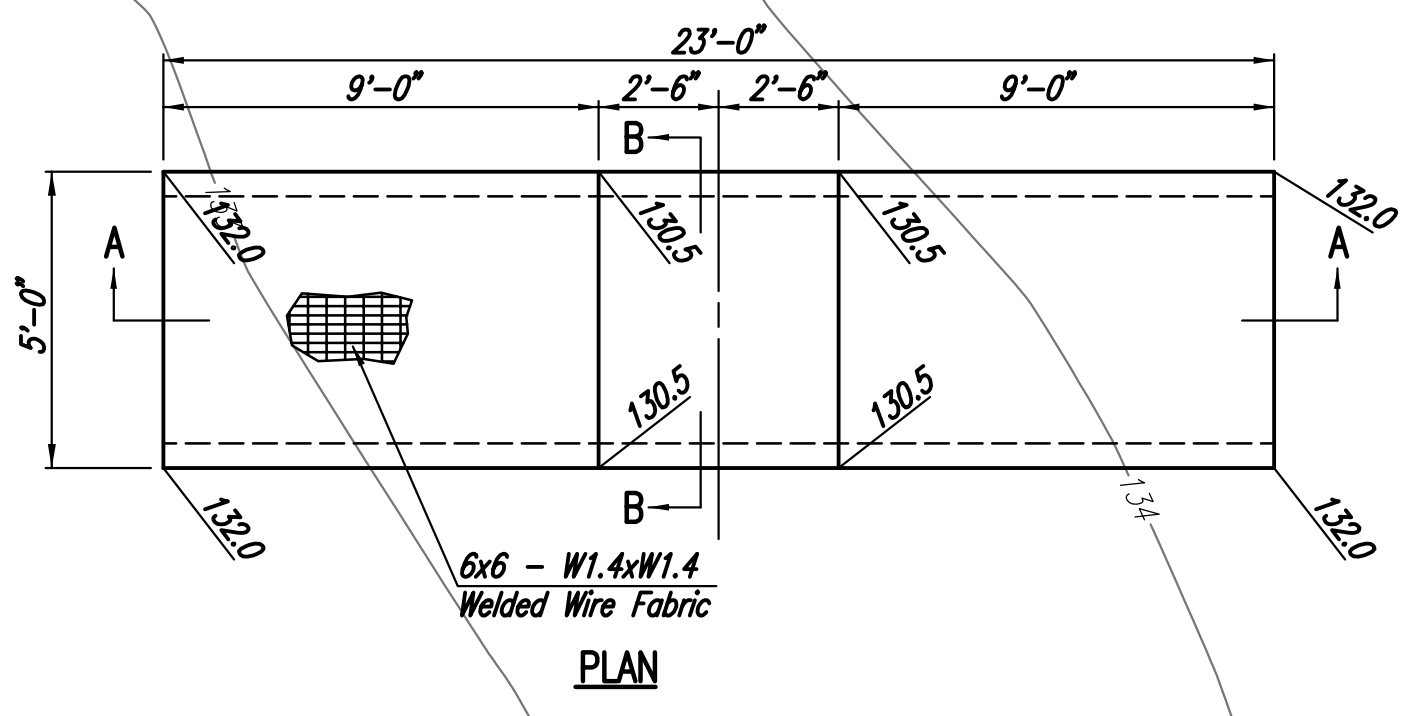


SECTION A1-A1
N.T.S.

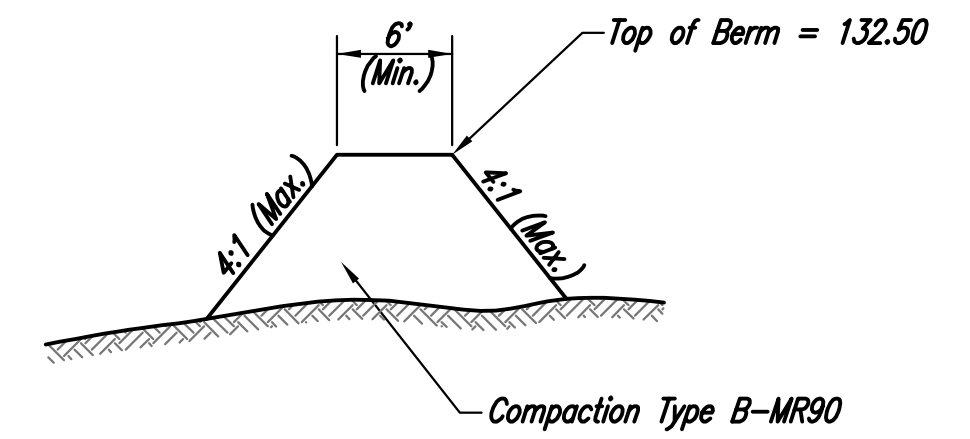

GENERAL NOTES

UNIT STRESSES:
 CONCRETE: $F_c=4,000$ P.S.I., $F_y=60,000$ P.S.I.
 $F_c=1,600$ P.S.I., $F_s=24,000$ P.S.I.

CONCRETE: Concrete shall have a minimum 28 day compressive strength of 4,000 P.S.I. Bevel all exposed edges with a 3/4" triangular moulding, unless otherwise noted.



REINFORCING: Welded wire fabric shall conform to ASTM A185.

SCALE: 1"=20'

DRY DETENTION
 0.70 AC. @ 130.5
 1.00 AC. @ 131.0
 1.20 AC. @ 132.0
 Hw100=131.5

Construct Berm
See Section A1-A1
this sheet.

Construct Concrete
Overflow Weir. See
Detail this sheet.

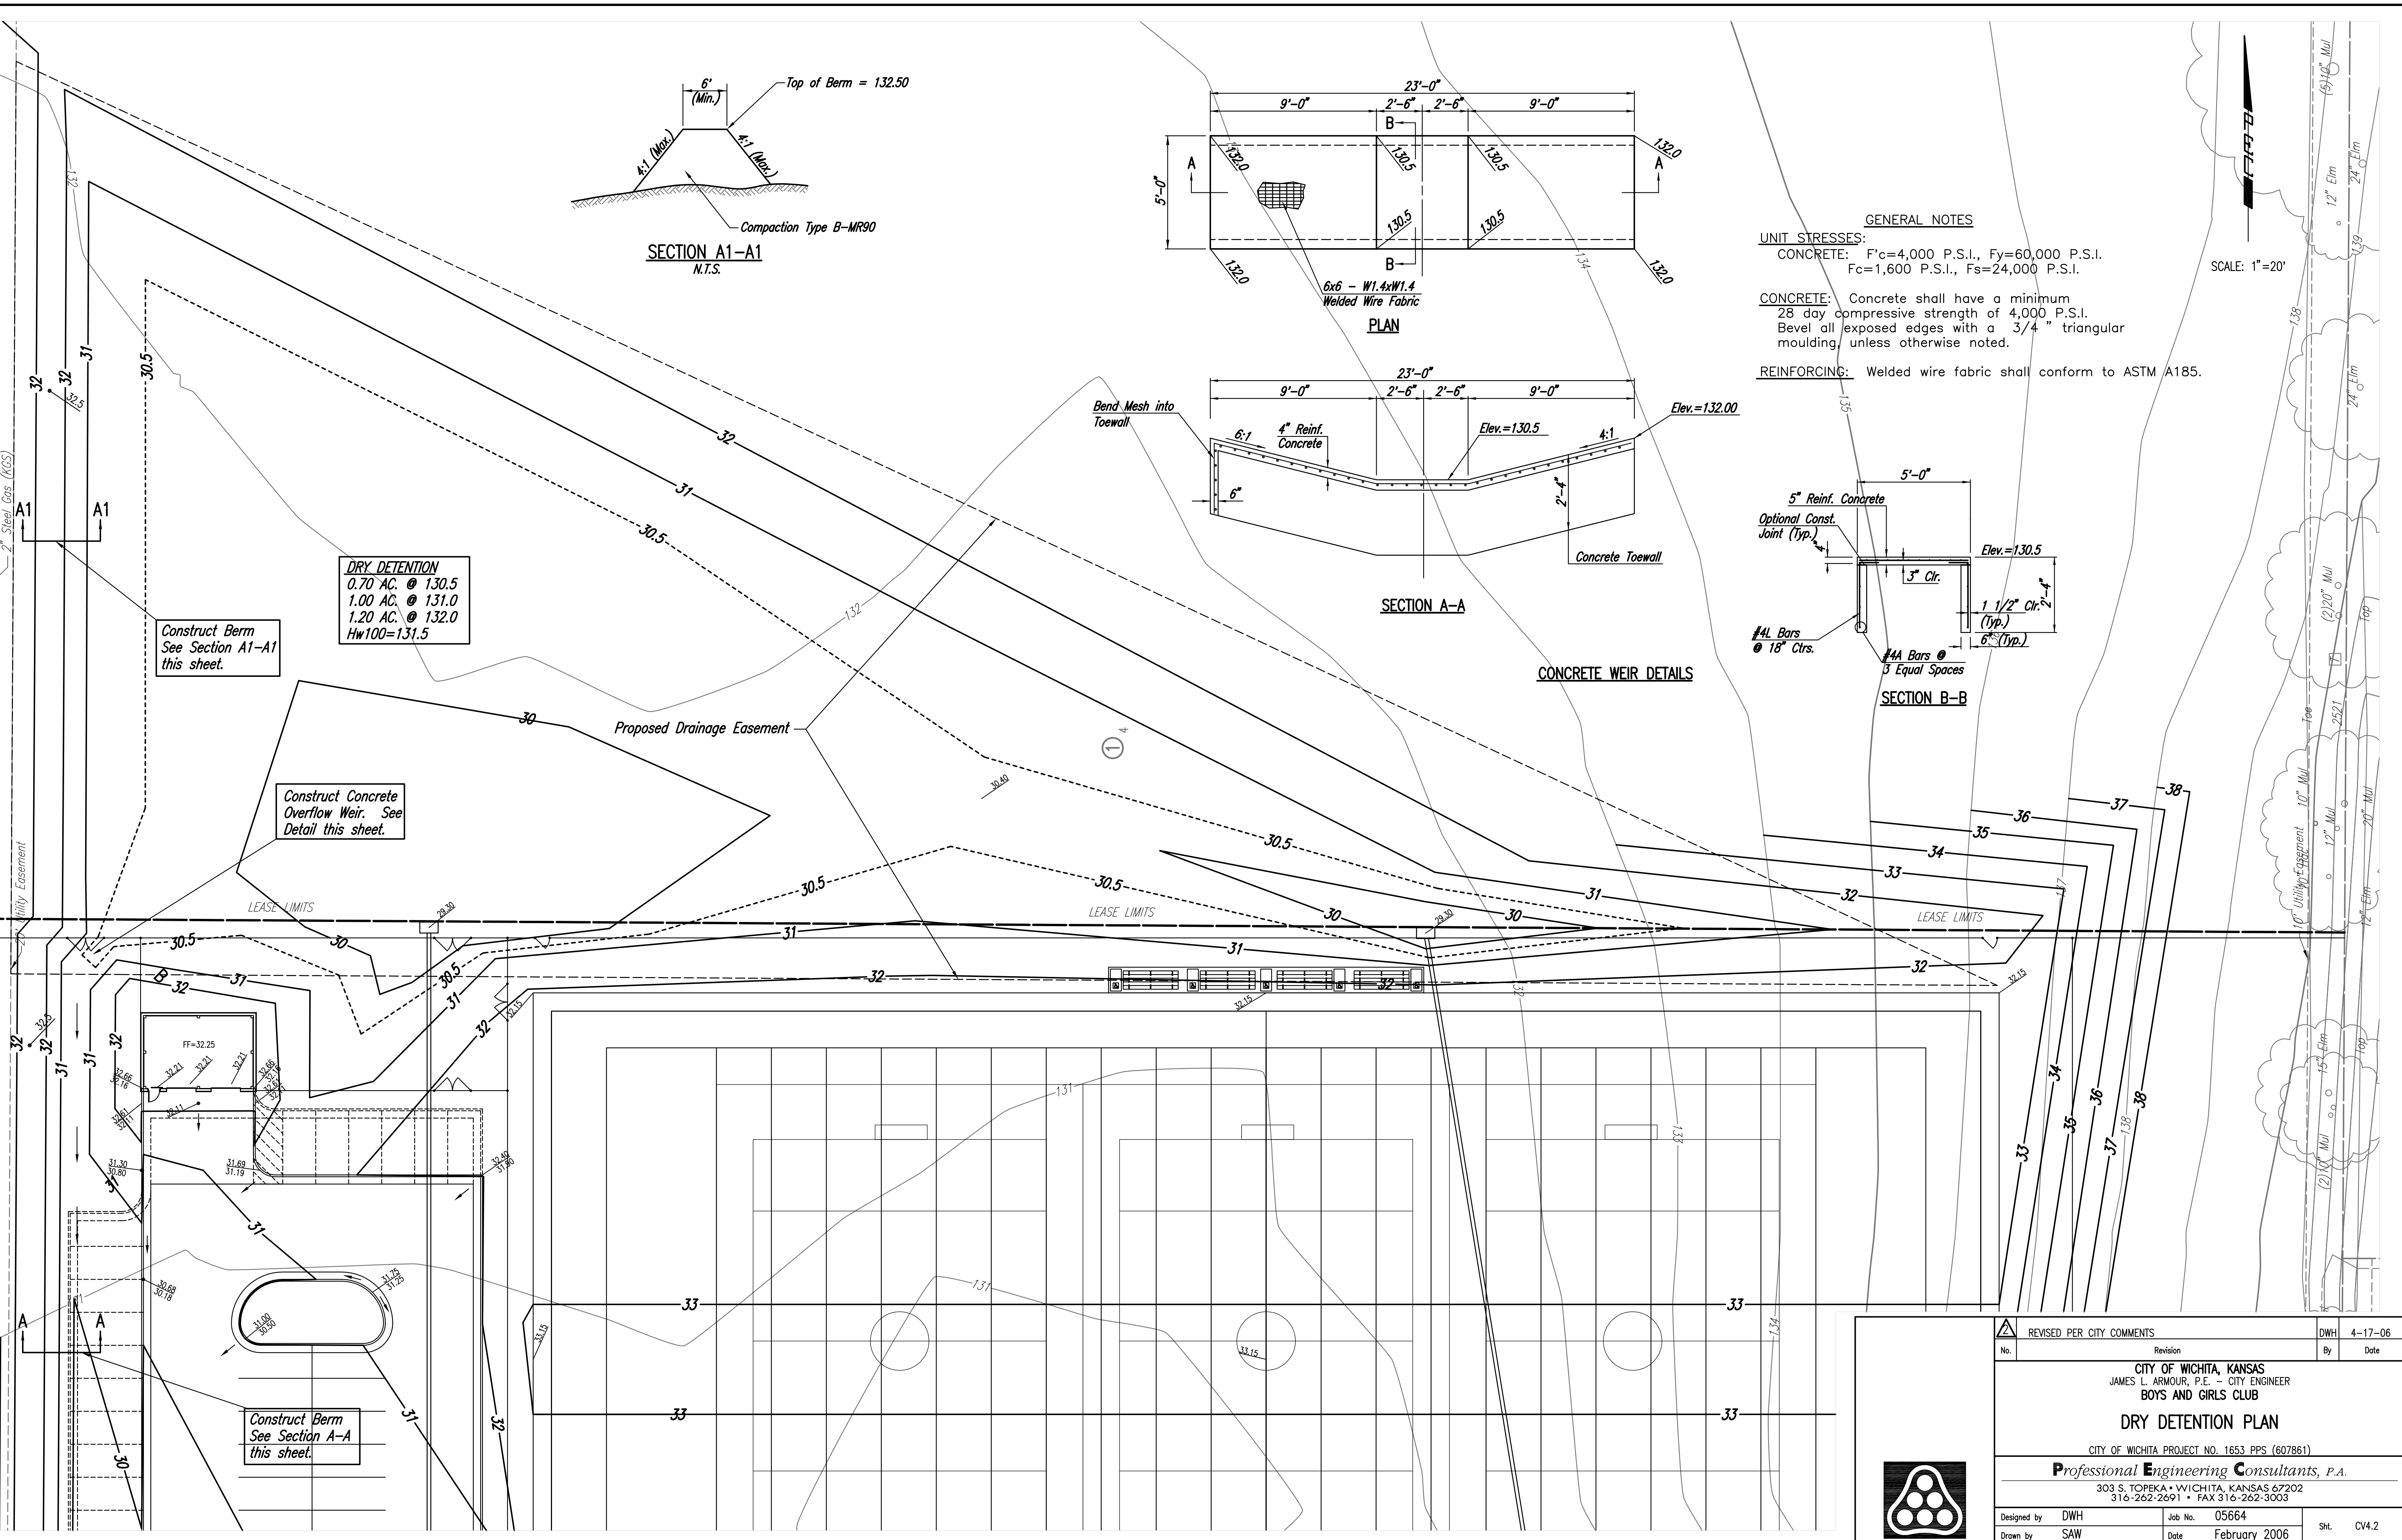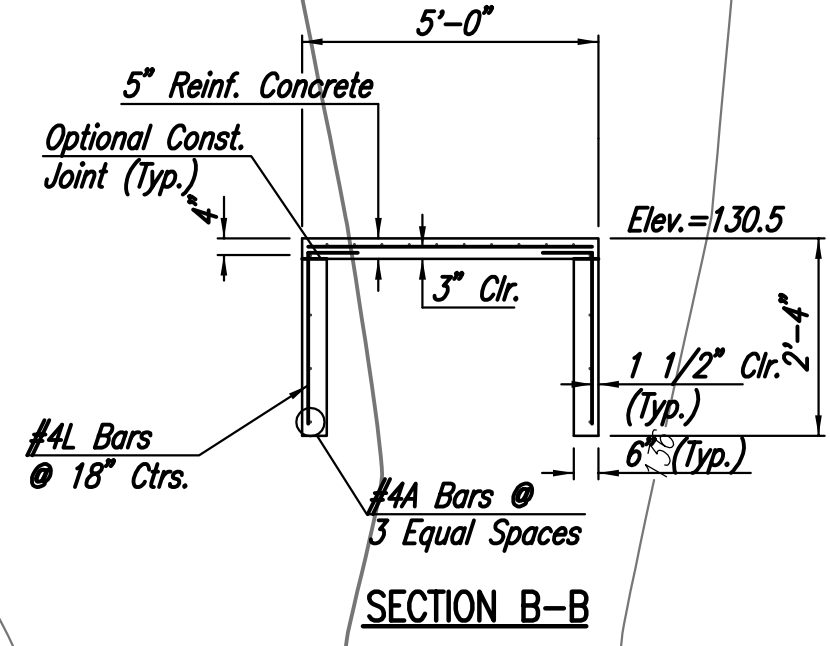

Saved 04-12-2006 10:54:38 AM by SWM
 04-08-04-2006 SWM by DWH
 C:\2005\0566A\Prints_Para\DW\0566A-0412-06.Dwg

REVISION PER CITY COMMENTS		DWH	4-17-06
No.	Revision	By	Date
CITY OF WICHITA, KANSAS JAMES L. ARMOUR, P.E. - CITY ENGINEER BOYS AND GIRLS CLUB DRY DETENTION PLAN CITY OF WICHITA PROJECT NO. 1653 PPS (607861)			
Professional Engineering Consultants, P.A. 303 S. TOPEKA • WICHITA, KANSAS 67202 316-262-2691 • FAX 316-262-3003			
Designed by	DWH	Job No.	05664
Drawn by	SAW	Date	February 2006
		Sht.	CV4.2

