


SCALE: 1" = 60'  
• = Iron

**BENCHMARK:**

Revised Site in Power Pole  
Located 27' South and 402' East  
of the Northwest Corner of the  
NE 1/4, Section 24, Twp. 28-S, R-1-W  
Elevation = 92.98  
City Datum

City of Wichita Benchmark, Disc-55 Corner  
at Intersection of 47th St. S. and West St.  
5100' S. of Centerline  
9980' E. of P.P. on SW Corner  
2380' S. of P.P.  
Elevation = 92.29  
City Datum

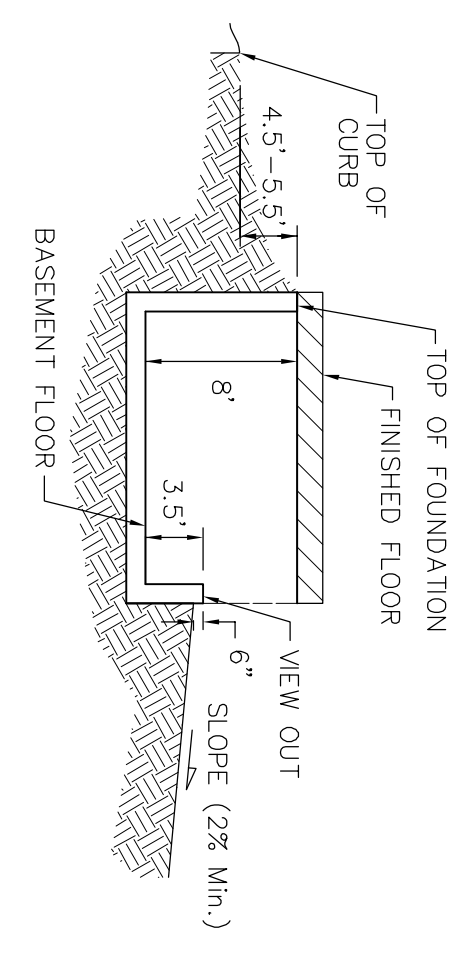

**TYPICAL VIEW OUT DETAIL**  
NO SCALE

**NOTES:**

Proposed Top of Foundation Elevations Are Shown On  
Plans. Contractor to Set Finished Floor Elevations.  
All Street Elevations Shown on Plans Are for Top of  
Curb (Full-Height).  
This Grading Plan is Designed with View-Outs.  
Elevations Shown at Rear of House (XX.X V.O.)

LOT	BLOCK	ELEVATION	CITY DATUM
3-5	B	94.0	
31-52	B	94.0	
2-18	C	94.0	
23-26	C	94.0	
28-32	C	94.0	
34-37	C	94.0	
39-46	C	94.0	

REVISED PAD & CORNER FOR LOT 21, BLOCK A - 2/15/05 BY AEG PER NBW

**ANGEL FIRE  
GRADING PLAN**

CITY OF WICHITA, SEDGWICK COUNTY, KANSAS

**BAUGHMAN COMPANY P.A.**  
ENGINEERING, SURVEYING, & PLANNING

318-282-7271 • 315 ELLIS • WICHITA, KANSAS 67211

PROJECT NUMBER

DESIGN: SCJ  
DRAWN: JMW  
APPROVED: NBW  
DATE: 12/26/00  
SCALE: 1" = 60'  
SHEET 3 OF 3