BENCHMARKS:
City Disc In T.C. Adj. to F.H. 38' South of intersection of Onewood and Auburn Hills.
Elev. = 178.48 (City Datum)

"□" cut in south curb of Onewood 272' west of C.L. Auburn Hills.
Elev. = 179.73 (City Datum)

SEE SHEET 2 FOR NOTES AND TYPICALS

— — 140 — — Existing Grade

Scale: 1" = 60'

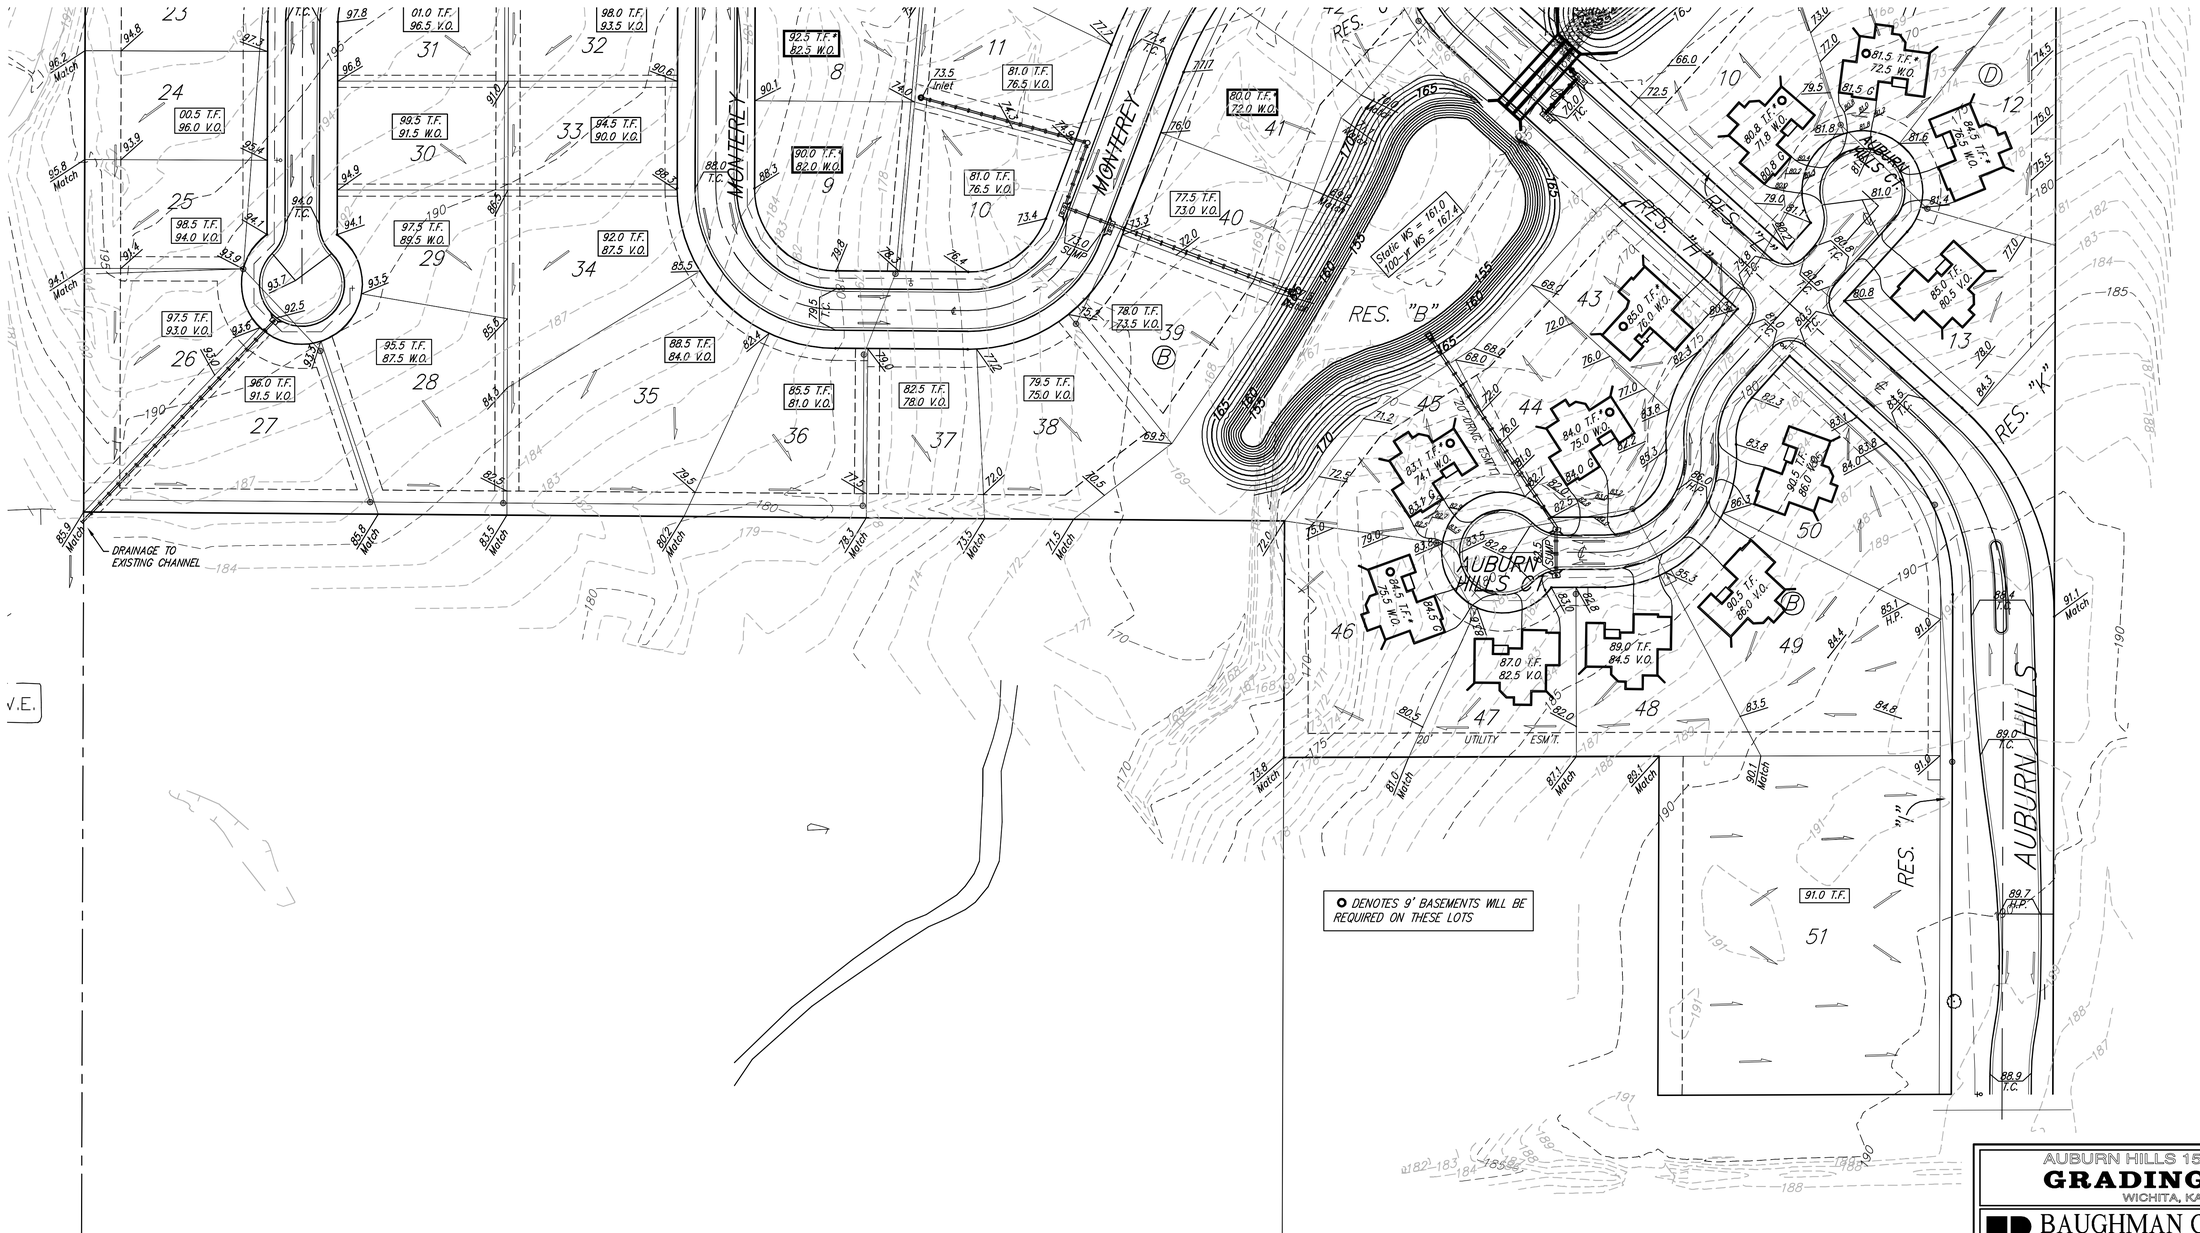


REV. 01/09/06 – Lots 43–50, B & 10–13, D – JEB per NBW
REV. 12/16/05 – Lots 46–50, B & 12–13, D – AEG
REV. 11/2/05 – Ph. 2 Westar Asbuilt – AEG
REV. 10/28/05 – Ph. 2 Final Grades – AEG
REV. 10/14/05 – Ph. 2 Final Grades – AEG
REV. 7–18–05 – Rear Yard Grades – Lot 4, Blk D – AEG
REV. 10–20–2004– Lots 3 & 4, Blk D–NLS

AUBURN HILLS 15TH ADDITION

# GRADING PLAN

WICHITA, KANSAS

BAUGHMAN COMPANY P.A.
ENGINEERING, SURVEYING, & PLANNING
316–262–7271 • 315 ELLIS • WICHITA, KANSAS 67211

| PROJECT NUMBER | | | | | SHEET 1 OF 2 |
|---|---|---|---|---|---|
| DESIGN NBW | DRAWN ATD | APPROVED | DATE 06/04 | SCALE Noted | |

AH15th/Moss