



BECKMANN:
 ELEVATION: 82.33
 Small Railroad Spike in West face of Power Pole, East of 44th and Hydraulic.
 Elev. = 82.94
 Railroad Spike in Light Pole, Southwest corner of 45th and Victoria.
 Elev. = 84.74

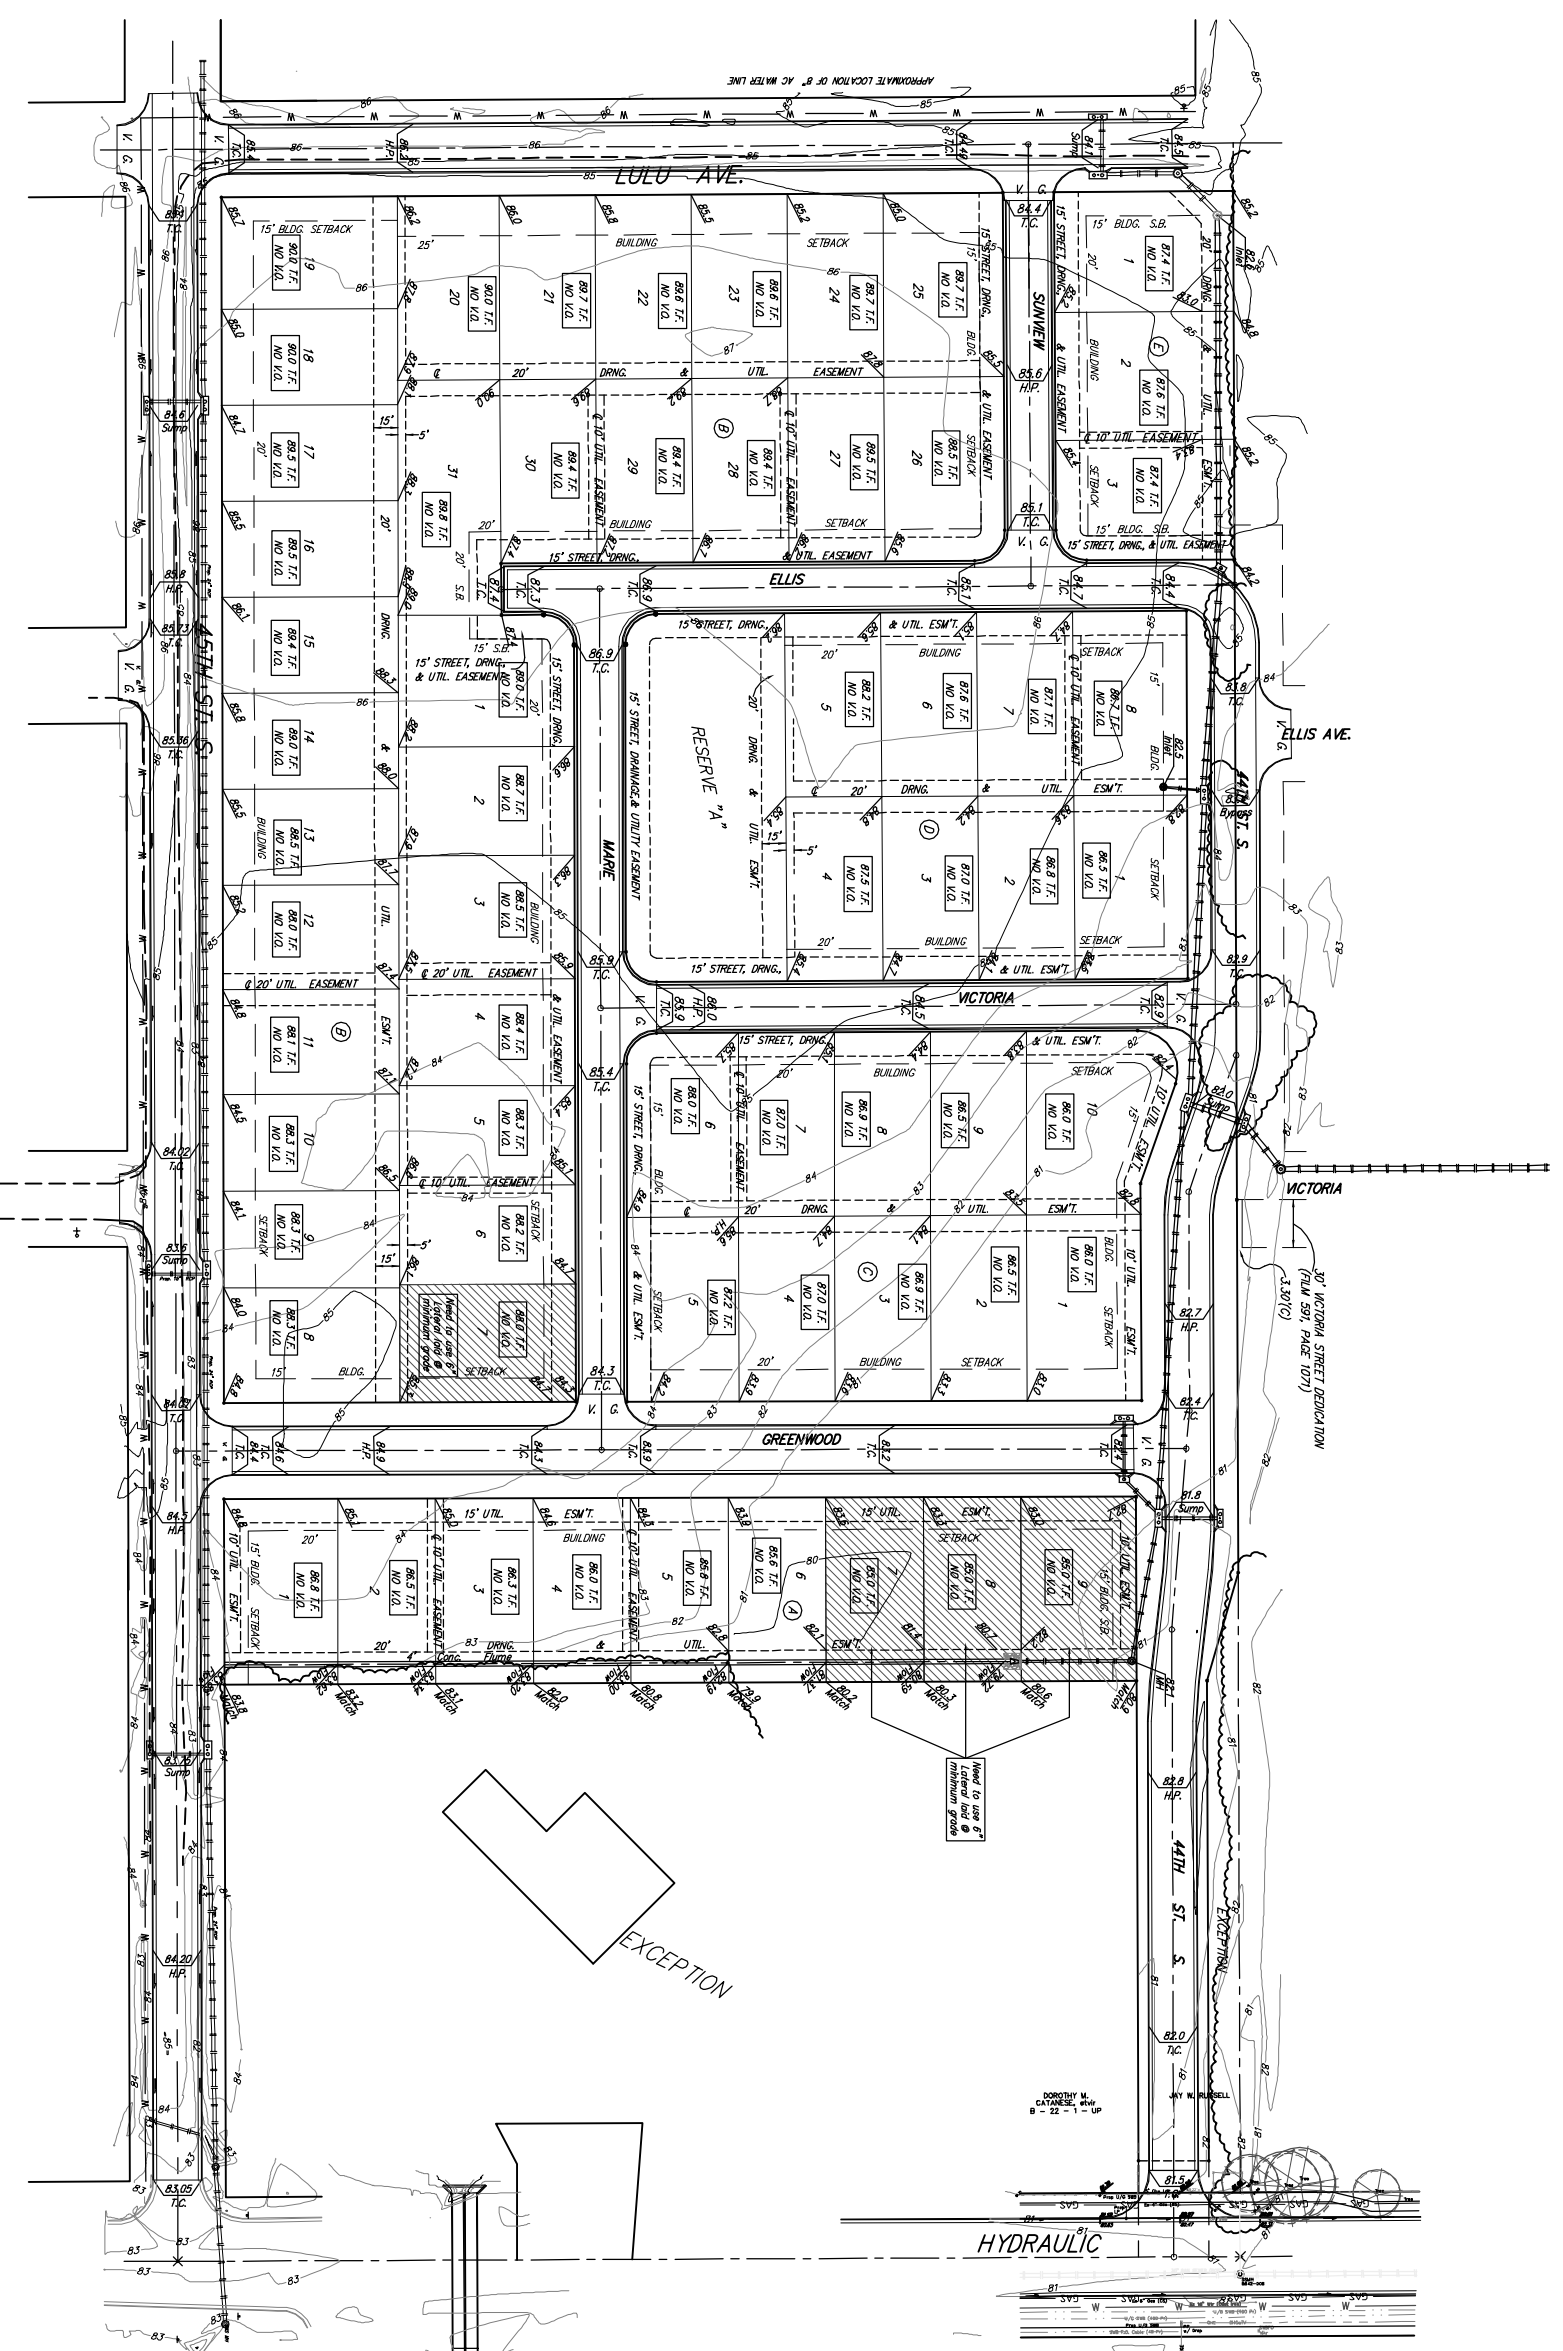


SCALE: 1" = 60'

• = IRON

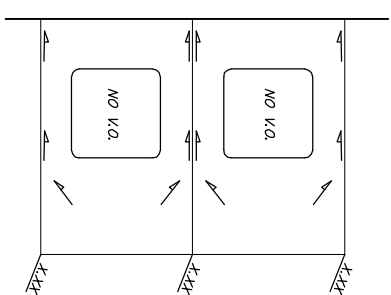

TYPICAL LOT DRAINAGE FOR LOTS REQUIRING FLOW TO FRONT OF LOT

NO SCALE

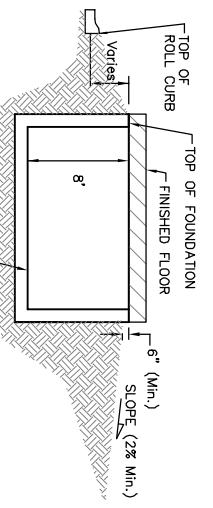

TYPICAL NON-VIEW OUT

NO SCALE

NOTES:

- Notes: Proposed Top of Foundation Elevations Are Shown On Plans.
- Contractor to Set Finished Floor Elevations.
- All Street Elevations Shown on Plans Are for Top of Curb.
- This Grading Plan is Designed with Non-View Outs.
- Lot dimensions have been omitted on this plan, refer to the recorded plat for this information.

Baughman Hidden Glen Addition
 Grading Plan
 Wichita, Kansas

REVISIONS:	DATE:
9.30.2004	MMWS
11.23.2005	MMWS
01.24.2006	MMWS
Updated Plans	

PROJECT NUMBER:	DATE:
9.30.2004	09/29/04
DESIGNER:	APPROVED:
MMWS	MMWS
SCALE:	SHEET:
1 OF 1	

Updated: 01-24-2006
 Updated: 11-23-2005
 Updated: 09-30-2004