


FOR DESCRIPTION OF ELEVATION  
REFERENCE MARKS, SEE PANEL  
200321 0075

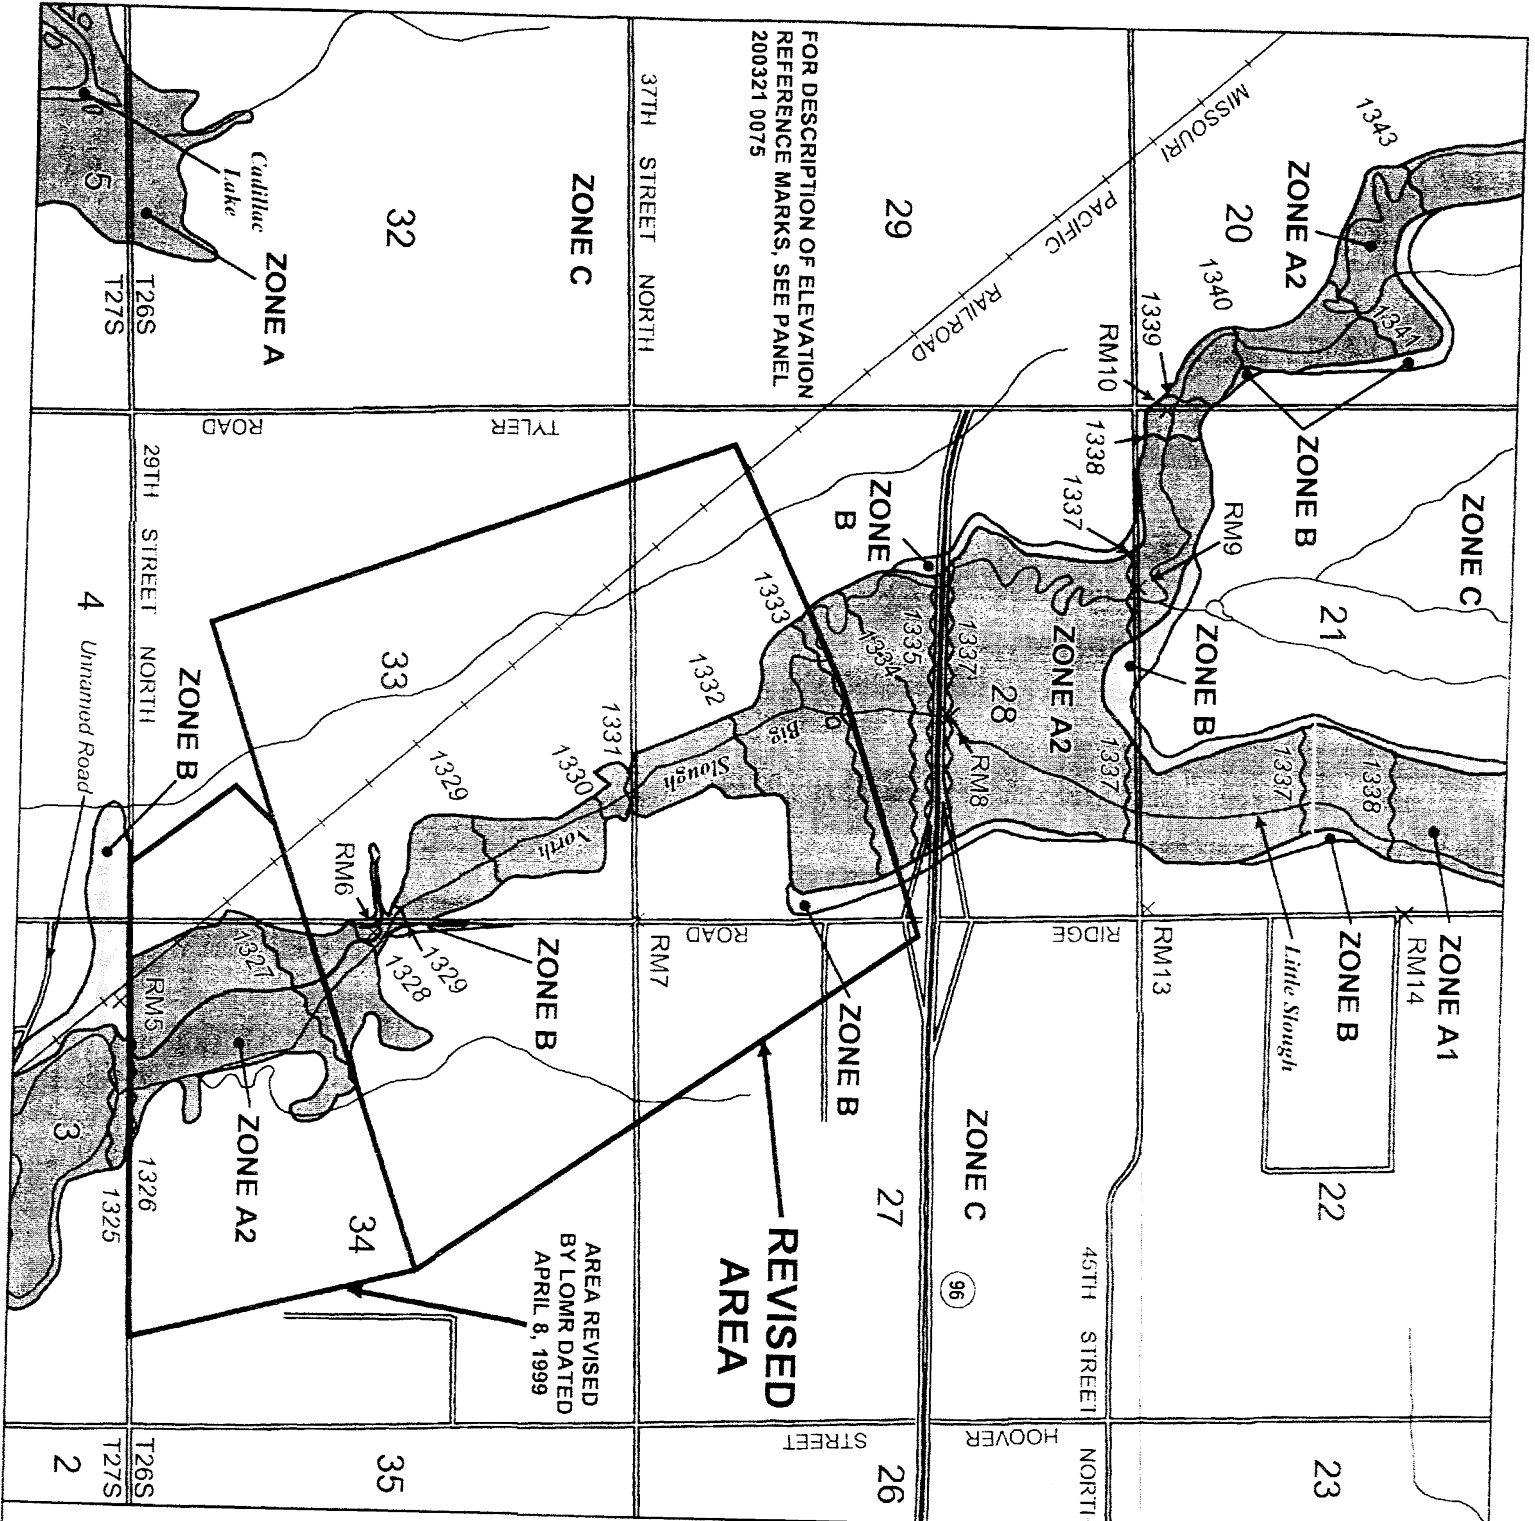

- Legend
- 1% annual chance (100-Year) Floodplain
  - 0.2% annual chance (500-Year) Floodplain



**FIRM**  
FLOOD INSURANCE RATE MAP

SEDGWICK COUNTY,  
KANSAS  
(UNINCORPORATED AREAS)

PANEL 125 OF 300  
(SEE MAP INDEX FOR PANELS NOT PRINTED)

**REVISED TO  
REFLECT LOMR  
DATED MAY 16 2005**

COMMUNITY PANEL NUMBER  
200321 0125 A

EFFECTIVE DATE:  
JUNE 3, 1986

Federal Emergency Management Agency

