



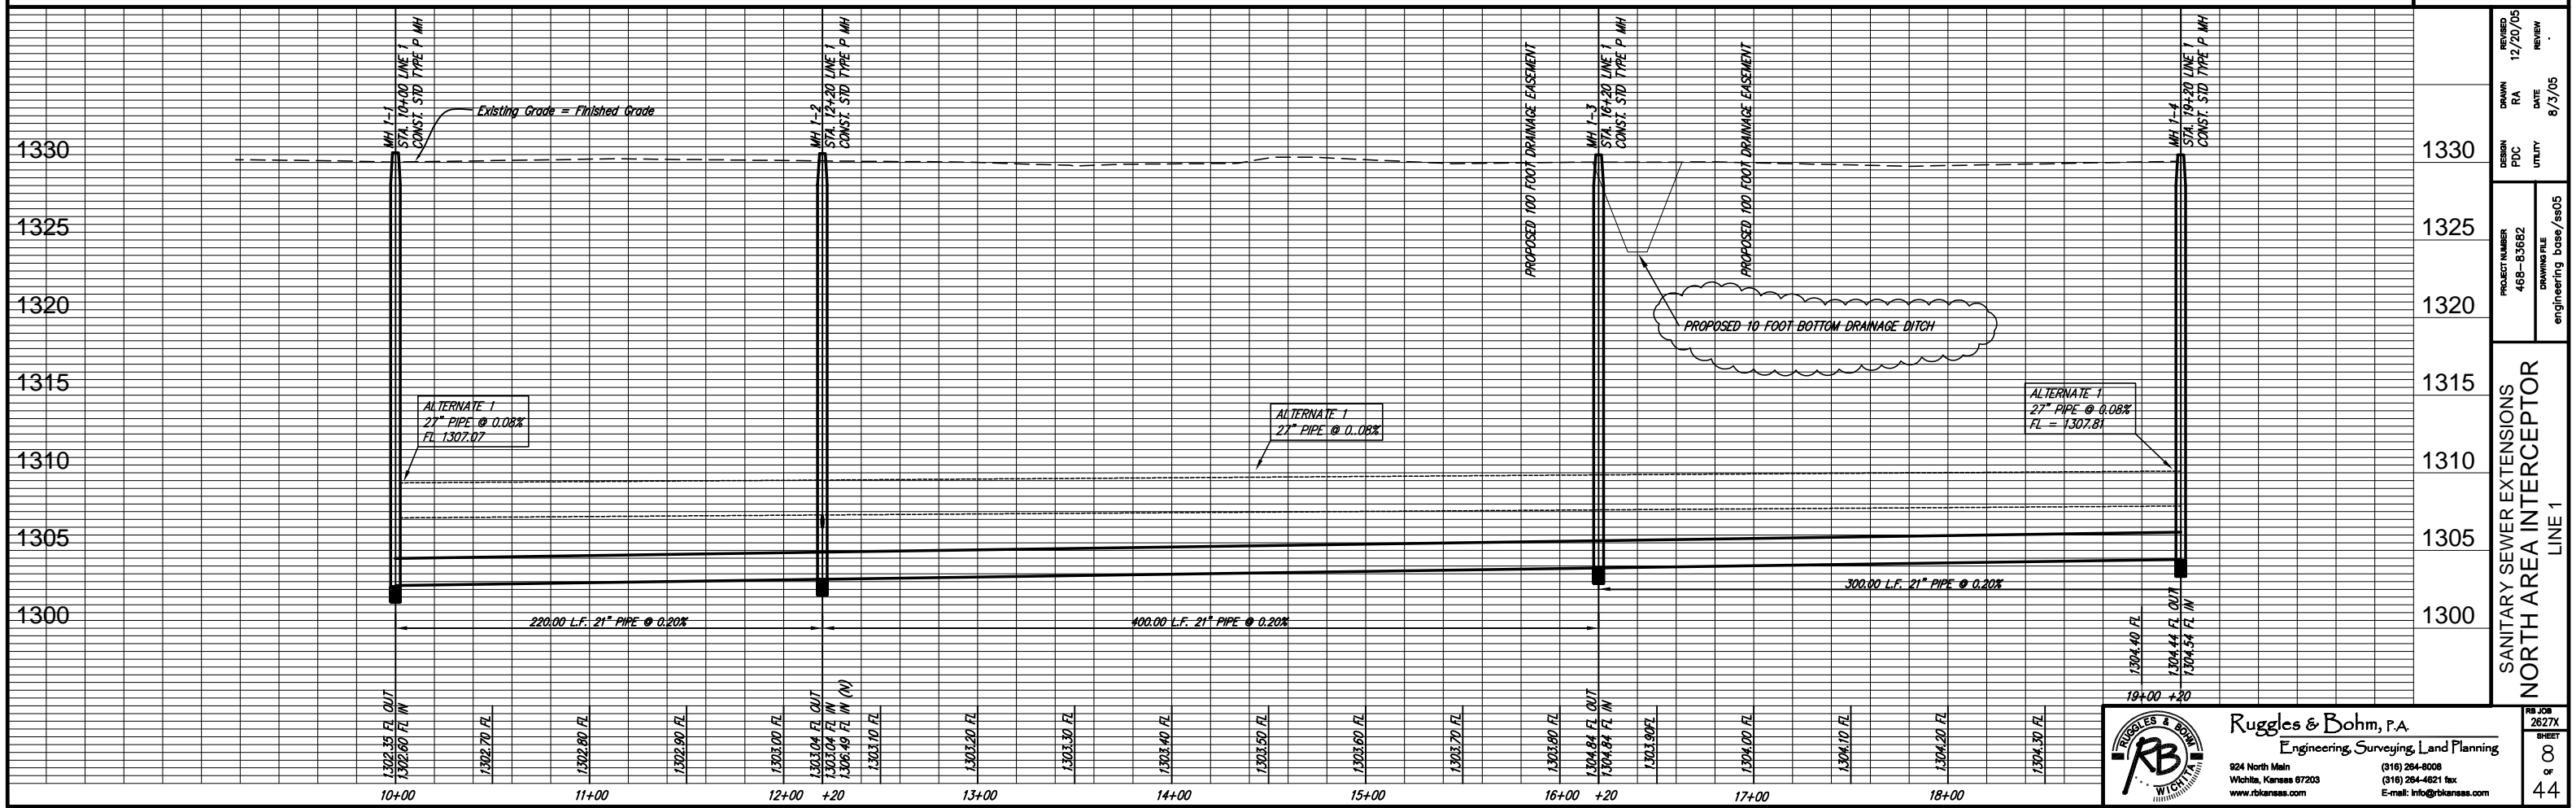

Scale 1" = 40' (Horiz.)  
1" = 5' (Vert.)

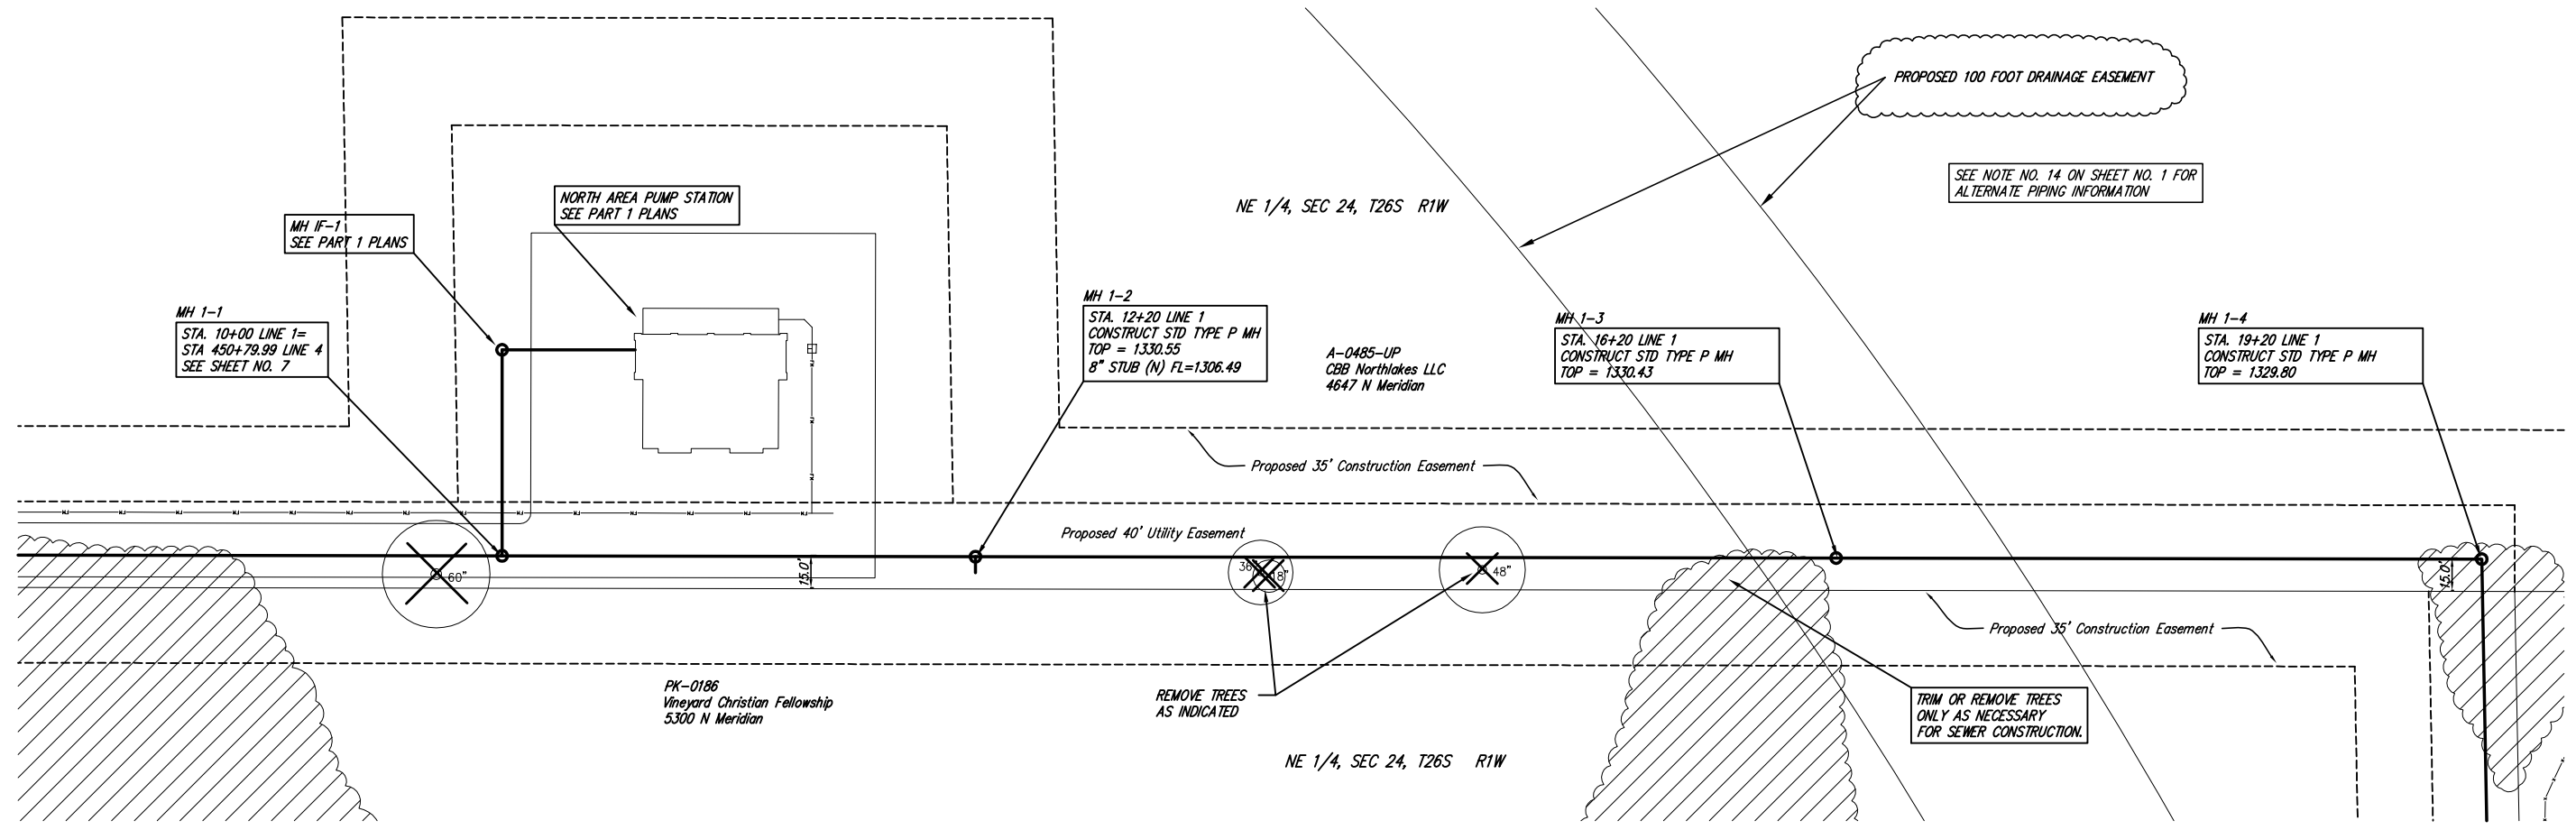

REVISION	12/20/05
DATE	8/23/05
DESIGN	PDC
UTILITY	
PROJECT NUMBER	468-83682
DRAWING FILE	engineering_base/ess05
SANITARY SEWER EXTENSIONS NORTH AREA INTERCEPTOR LINE 1	

**Ruggles & Bohm, P.A.**  
Engineering, Surveying, Land Planning

924 North Main  
Wichita, Kansas 67203  
www.rbkansas.com

(316) 264-9008  
(316) 264-4621 fax  
E-mail: info@rbkansas.com

RB JOB 2627X  
SHEET 8 OF 44