
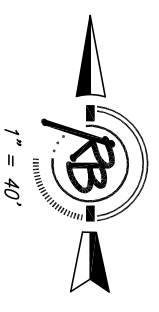


# 4 Corner Lot Grading Plan

## SIERRA HILLS 2ND ADDITION

An Addition to Wichita, Sedgwick County, Kansas

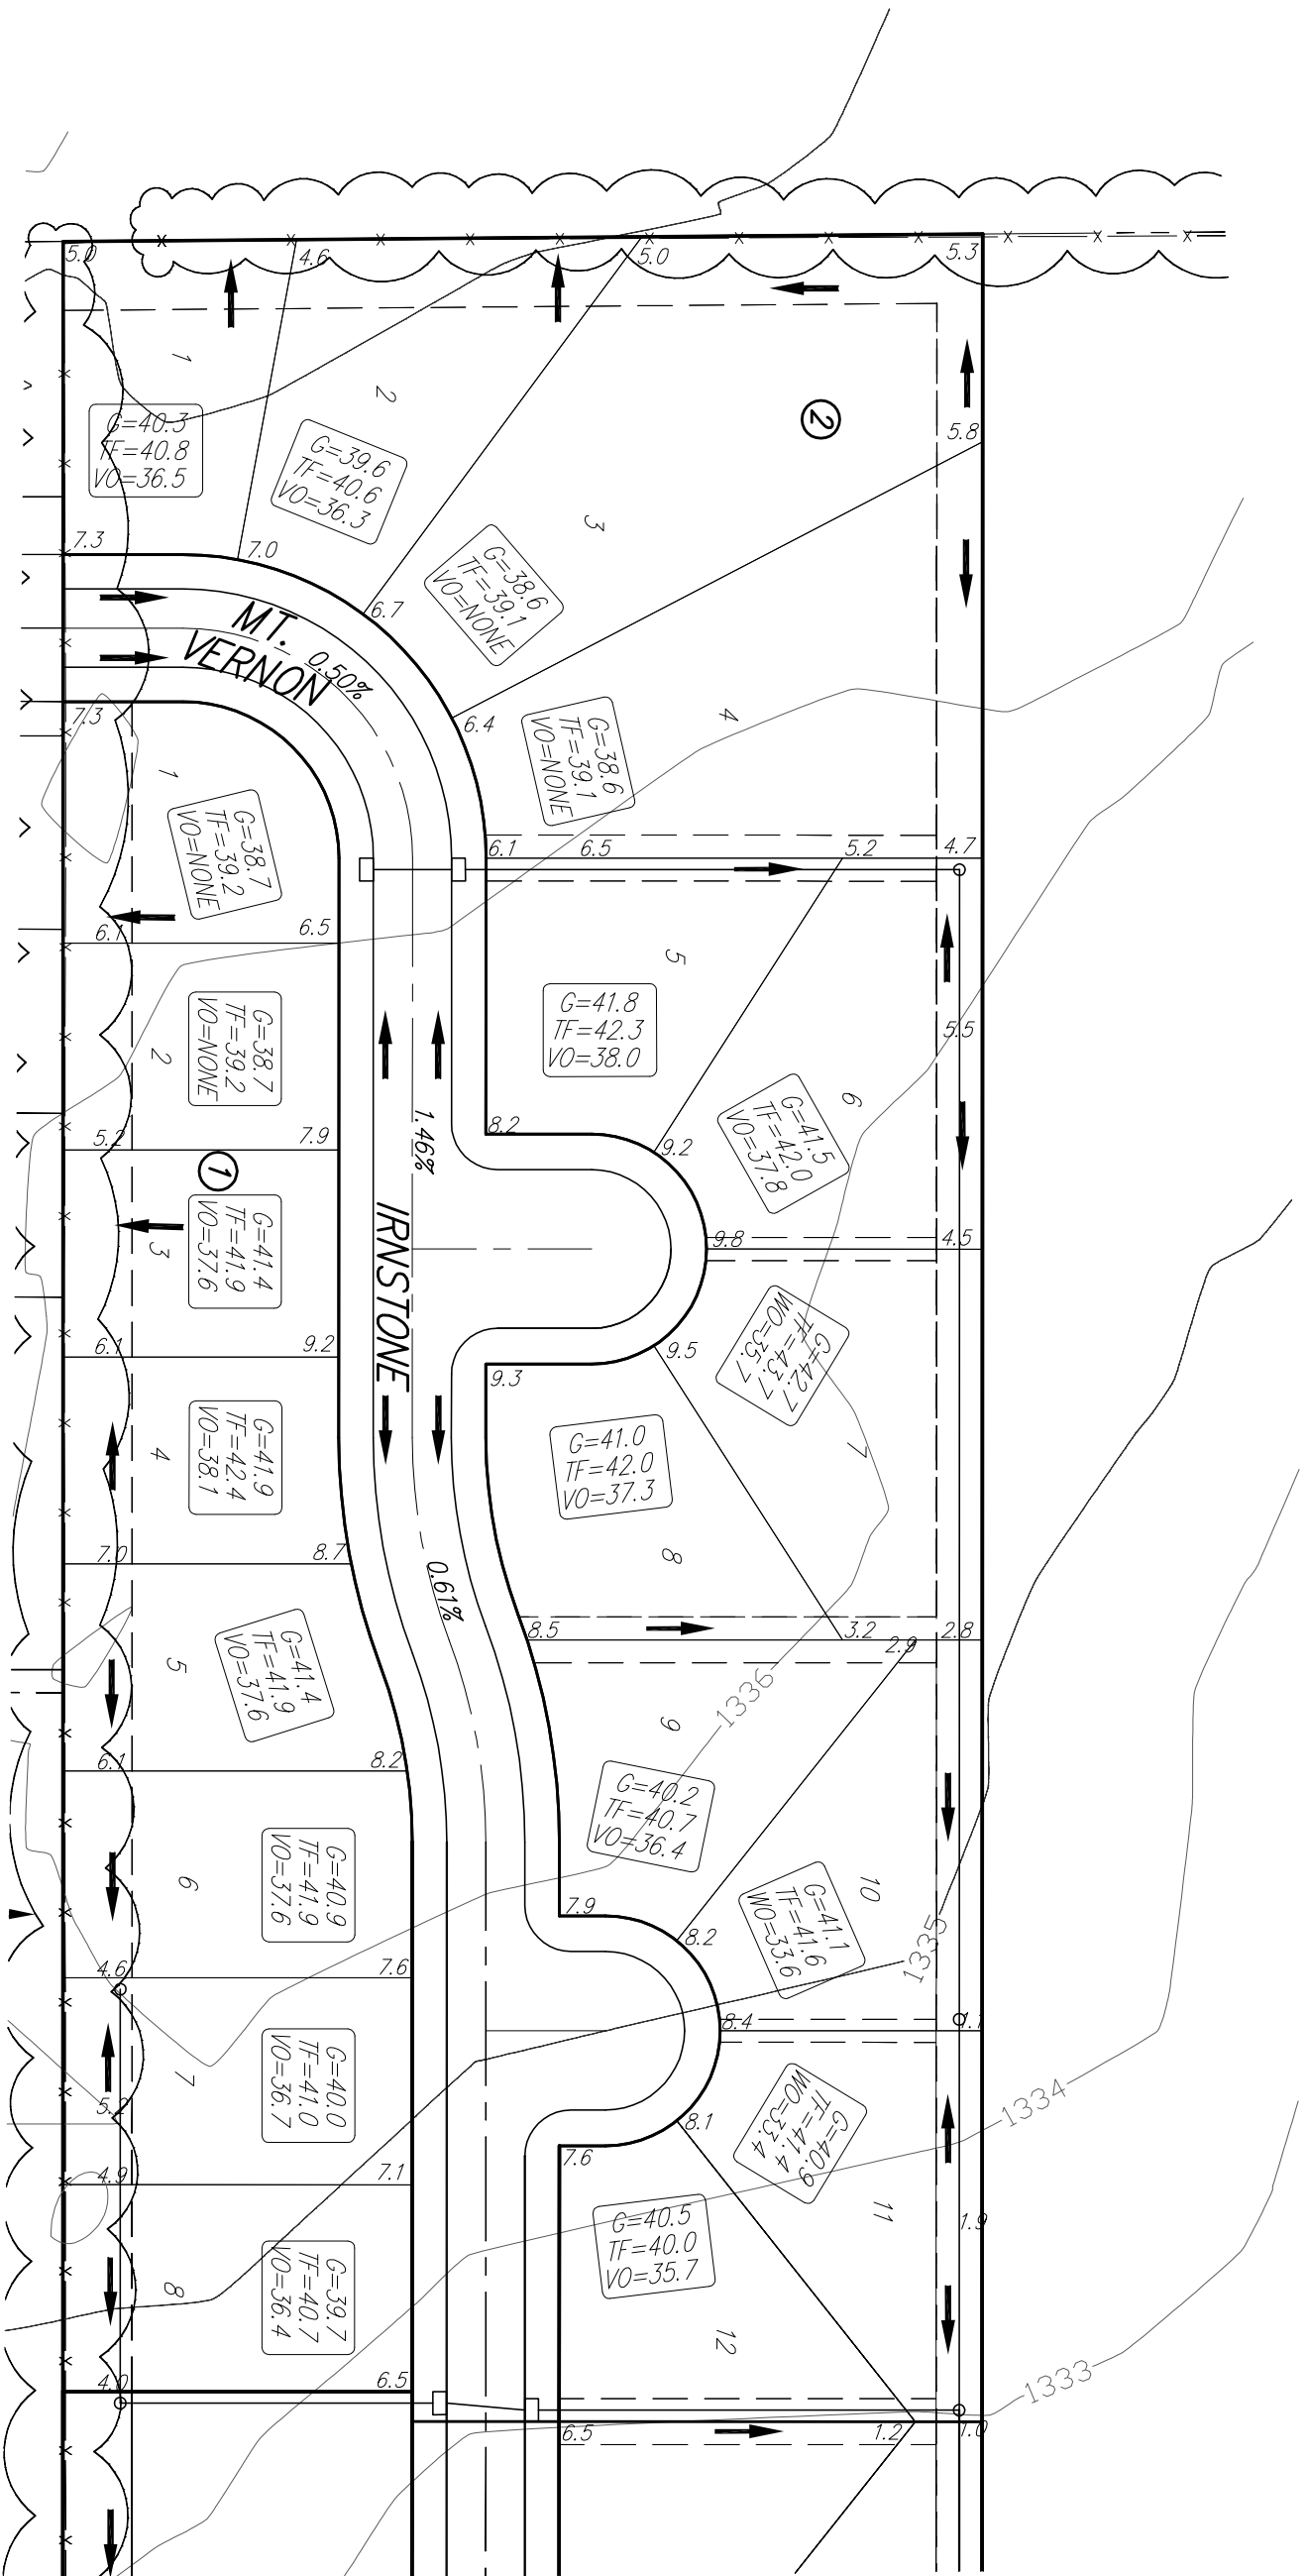

PAC REG. SURVEYOR  
 PROJECT NO. 2529  
 MAY 7, 2007



**Rugles & Bohm, P.A.**  
 Engineering, Surveying, Land Planning  
 924 North Main  
 Wichita, Kansas 67203  
 (316) 264-4008  
 (316) 264-4021 fax  
 Email: info@rbohms.com  
 www.rbohms.com