
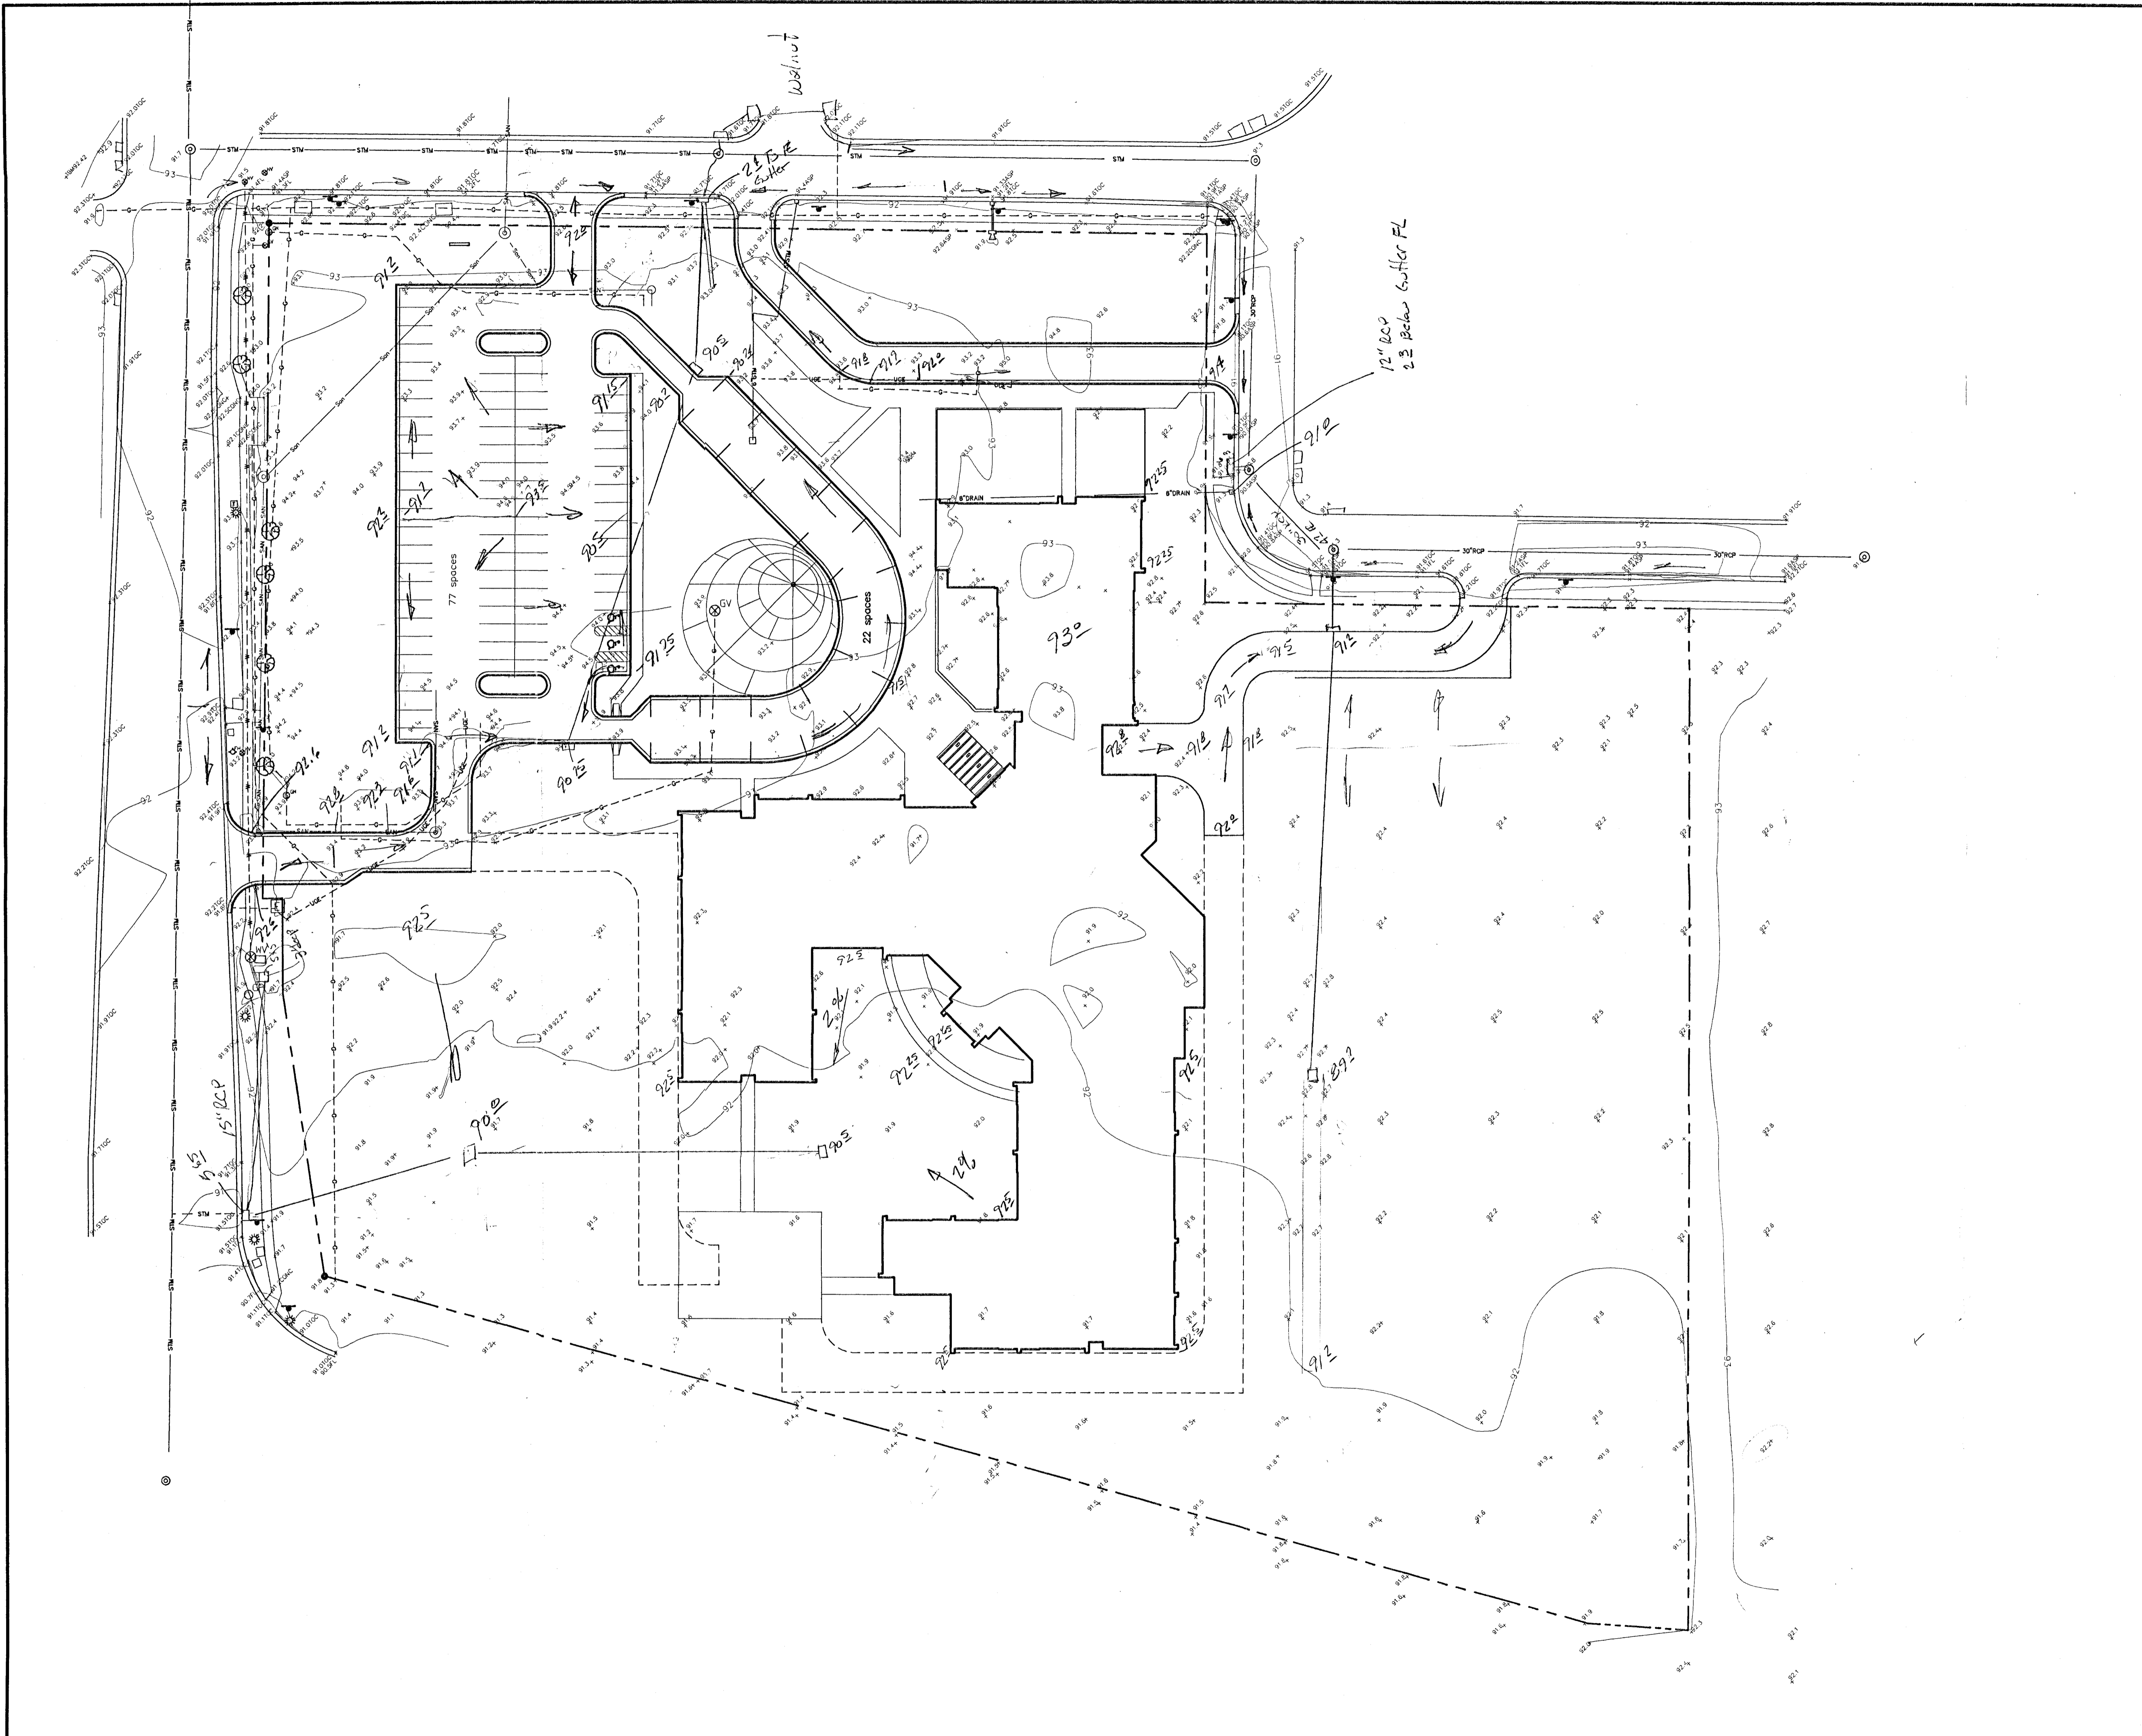
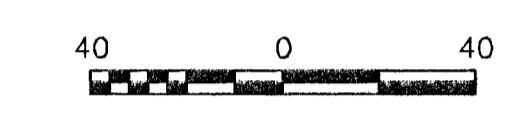


Project Number	Sheet Number	Total Sheets
6,217	1	1

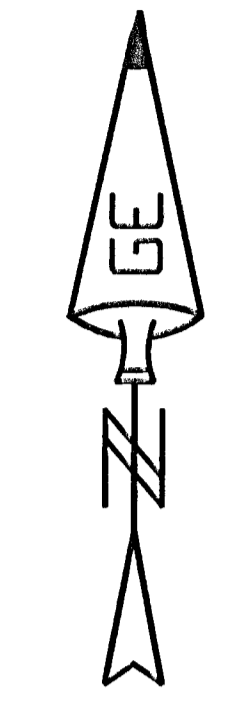

Plot Config Name Checked By:

Box 629	GOEDECKE ENGINEERING CO.	321-3773
205 S. Main El Dorado, Kansas 67042		
SCALE: AS NOTED	PROJECT NO. 6,217	DRAWN BY: RMH
DATE: MM/DD/YY		REVISED BY:
ENTERPRISE ELEMENTARY SCHOOL - WICHITA, KS		
DRAINAGE PLAN		FILE: MS-6217 - drainplan