


N
W S E

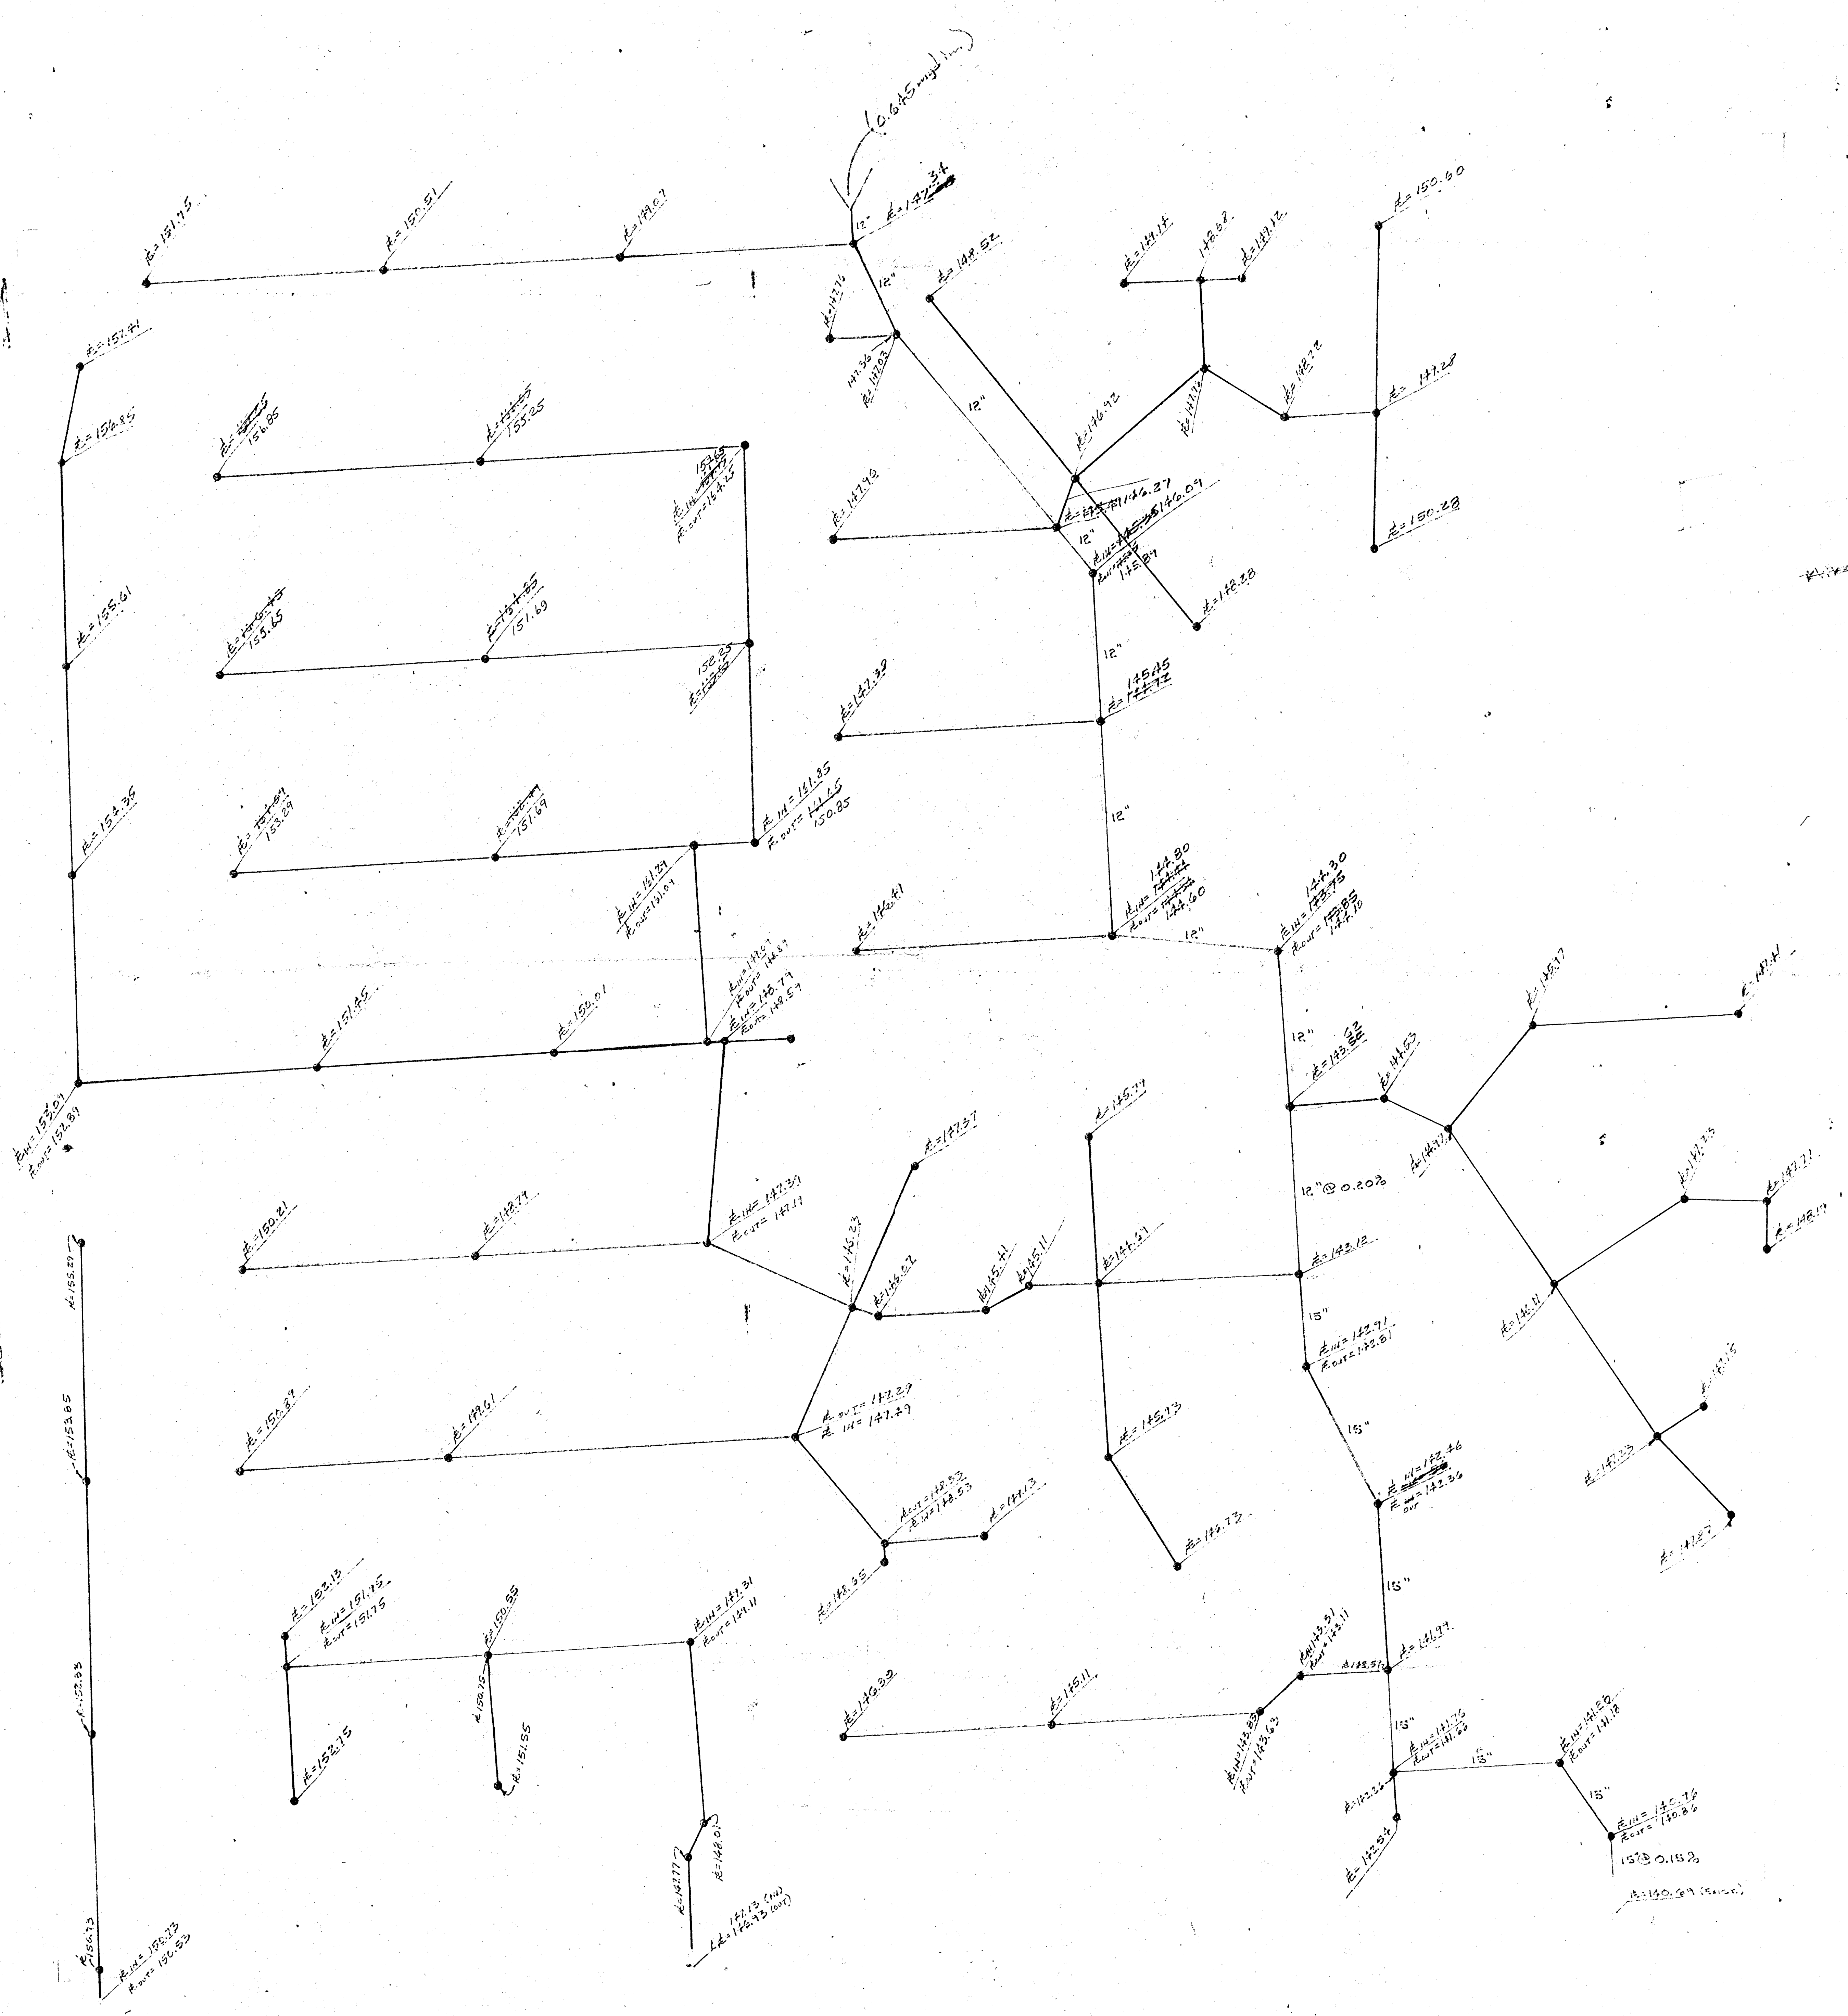


15" @ 0.15 %
12" @ 0.20 %
