

WHITE TAIL ADDITION TO SEDGWICK COUNTY, KANSAS

(Fire Hydrant Location Map)

- Phase 1 - [Symbol]
- Phase 2 - [Symbol]
- Phase 3 - [Symbol]
- Phase 4 - [Symbol]
- Phase 5 - [Symbol]


**SEDGWICK COUNTY
FIRE DEPARTMENT**
4343 N. Woodlawn - Wichita - 744-0471

SUBMITTAL DATA

Approved For Design and arrangement
 Approved As Noted subject to specification
 Not Approved requirements and notations.

[Signature] Date *7/27/93*
 Fire Prevention Bureau

30 Hydrants

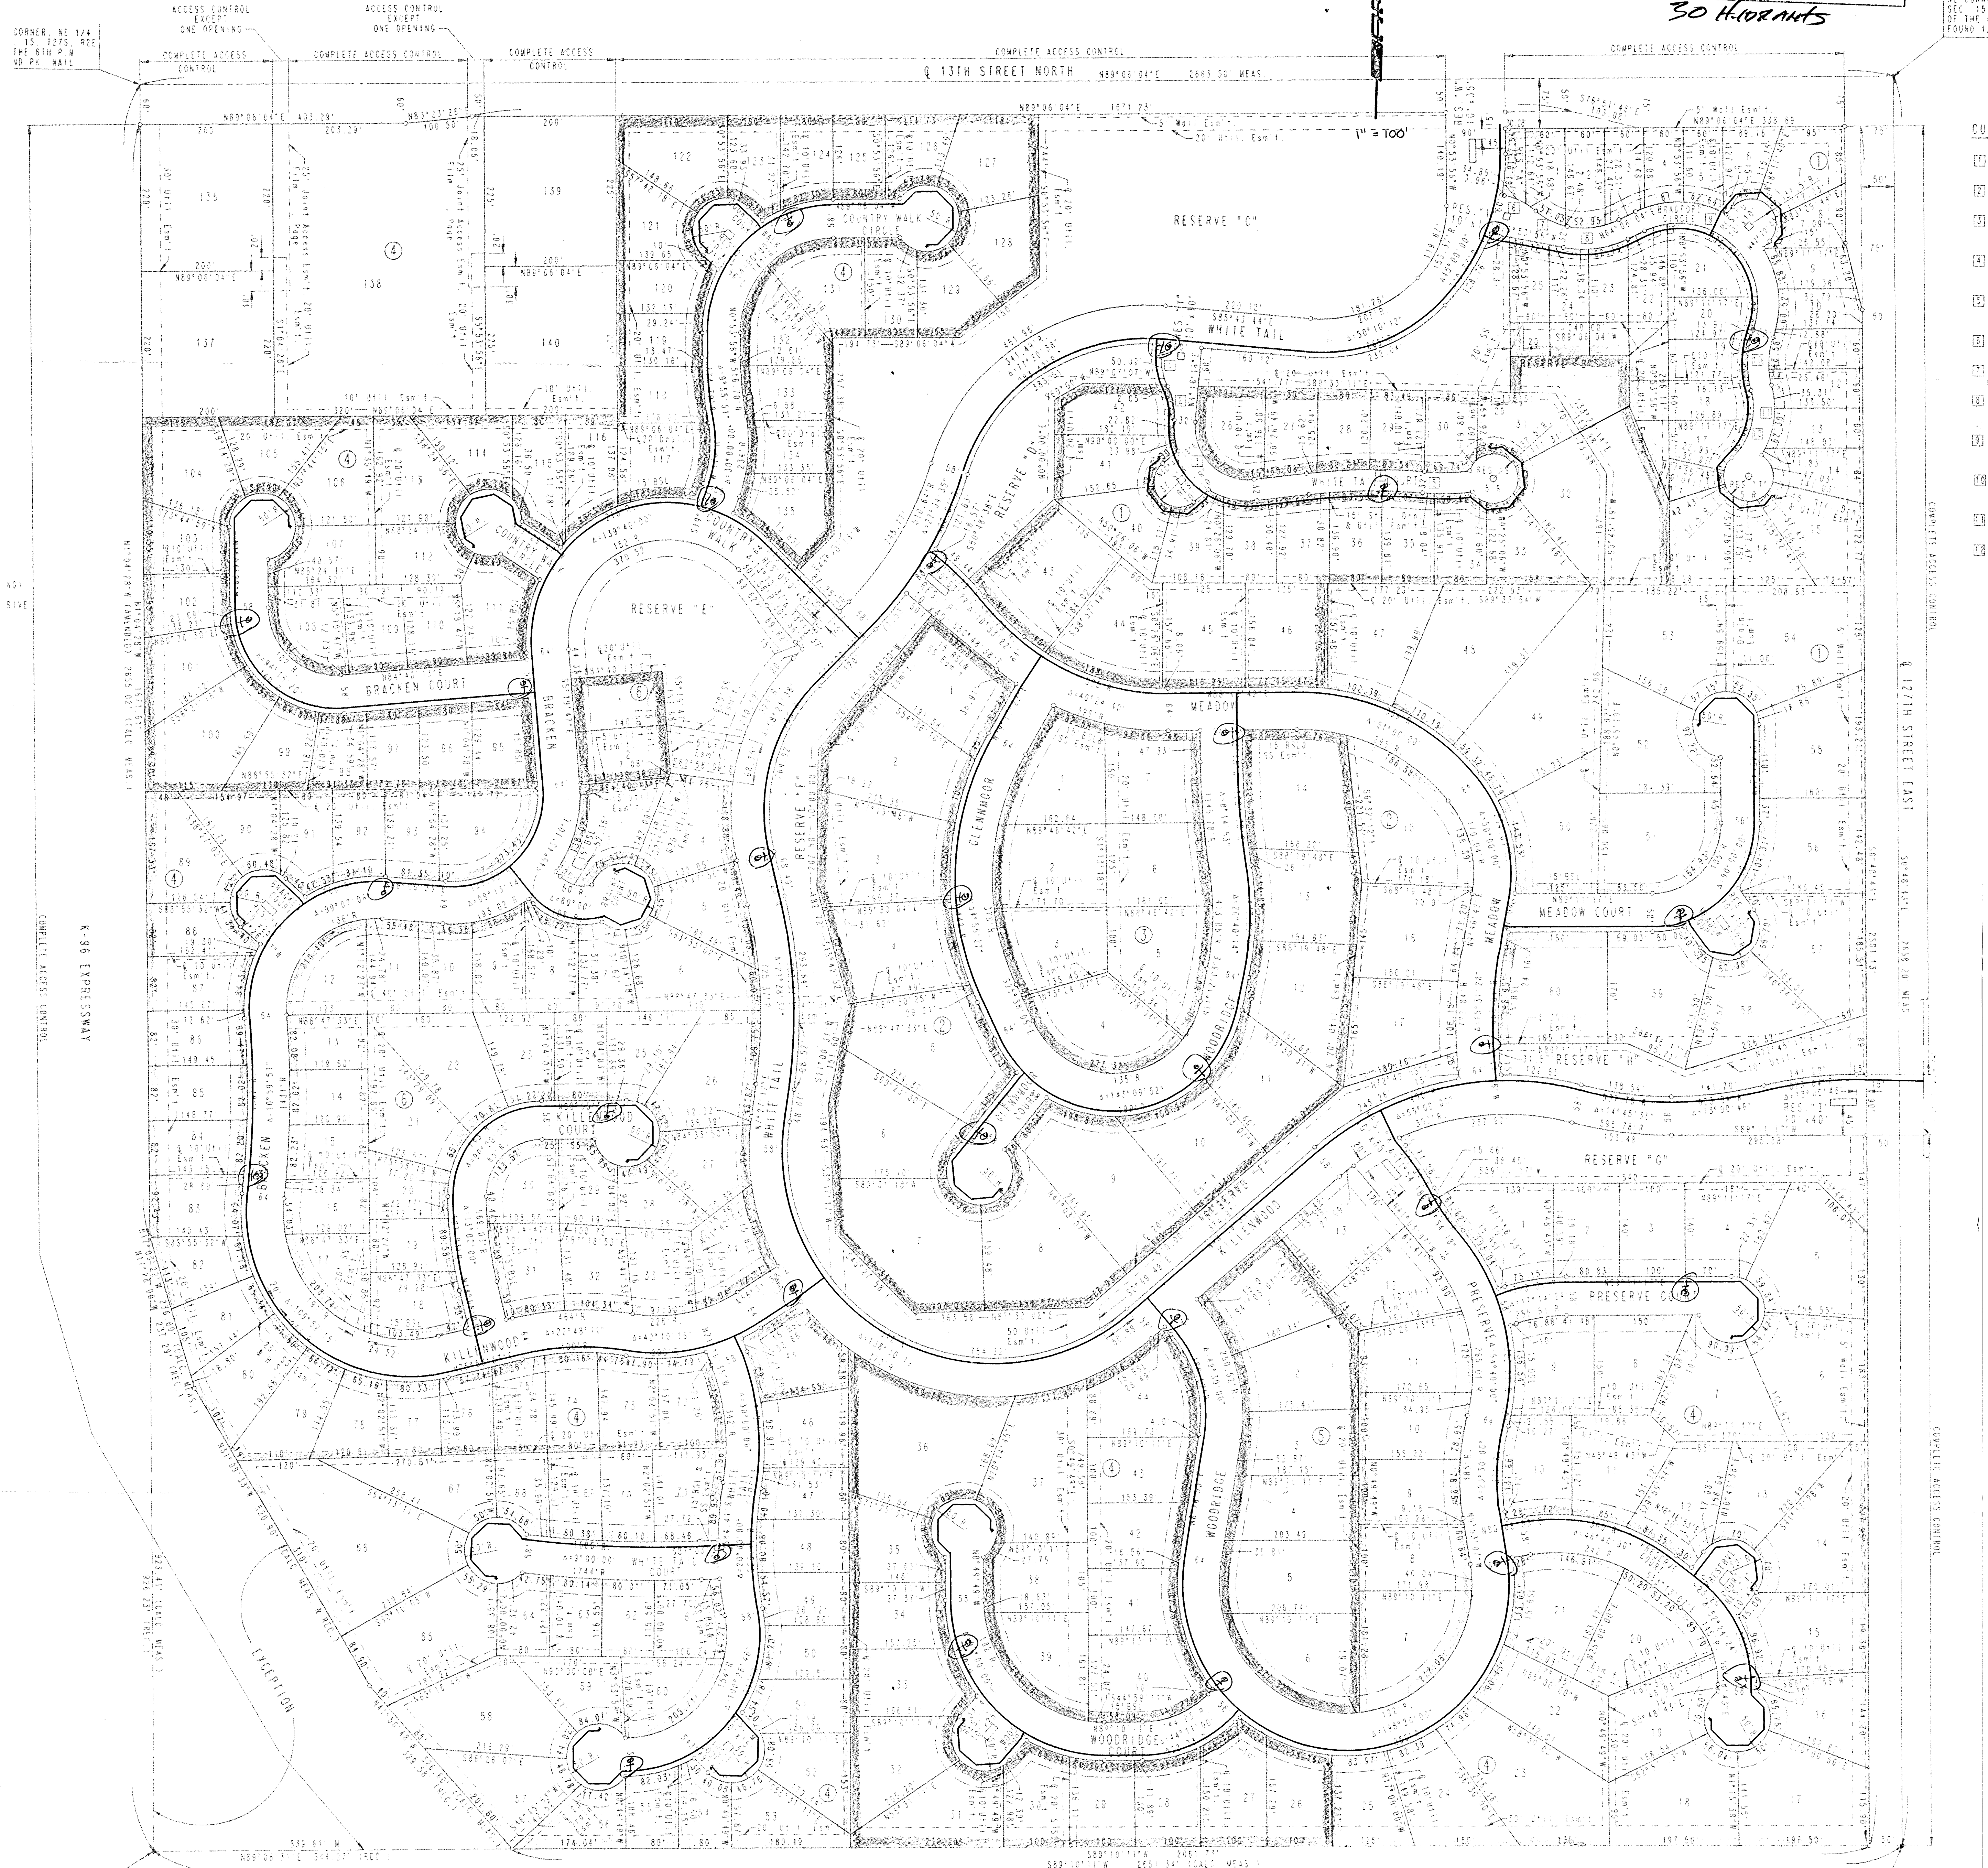

NE CORNER SEC. 19 OF THE E. FOUND 1.

COMPLETE ACCESS CONTROL

Q 12TH STREET EAST

COMPLETE ACCESS CONTROL

SW CORNER NE 1/4 SEC. 19 OF THE E. FOUND 1.

SE CORNER NE 1/4 SEC. 19 OF THE E. FOUND 1.