

VICINITY MAP OF  
**CAPITAL 2ND ADDITION**

OWNERS: W.K. CAPITAL ENTERPRISES, INC  
 DR. ROBERT D. SMITH  
 DR. JOAN C. LOEHR  
 DR. GERALD L. HOWELL  
 c/o SHAROL RASBERRY  
 300 N. MAIN - SUITE 200  
 WICHITA, KANSAS 67202

ENGINEERS: PROFESSIONAL ENGINEERING CONSULTANTS, P.A.  
 303 S. TOPEKA  
 WICHITA, KANSAS 67202

SCALE: 1"=50'


o = IRON SET

B.M. - CHISELED "d" SOUTH END CURB RETURN  
 WEST SIDE OF ROCK ROAD AT EAST 1/4  
 CORNER SEC. 18, T27S, R2E  
 ELEV.=179.18 CITY DATUM

For Bldg setback lines  
 See C.U.P. DP-146  
 Topo: March 1985

N.E. Corner N.E. 1/4  
 Sec. 18, T27S, R2E  
 of the 6th P.M.

North Line N.E. 1/4  
 Sec. 127S, R2E  
 of the 6th P.M.

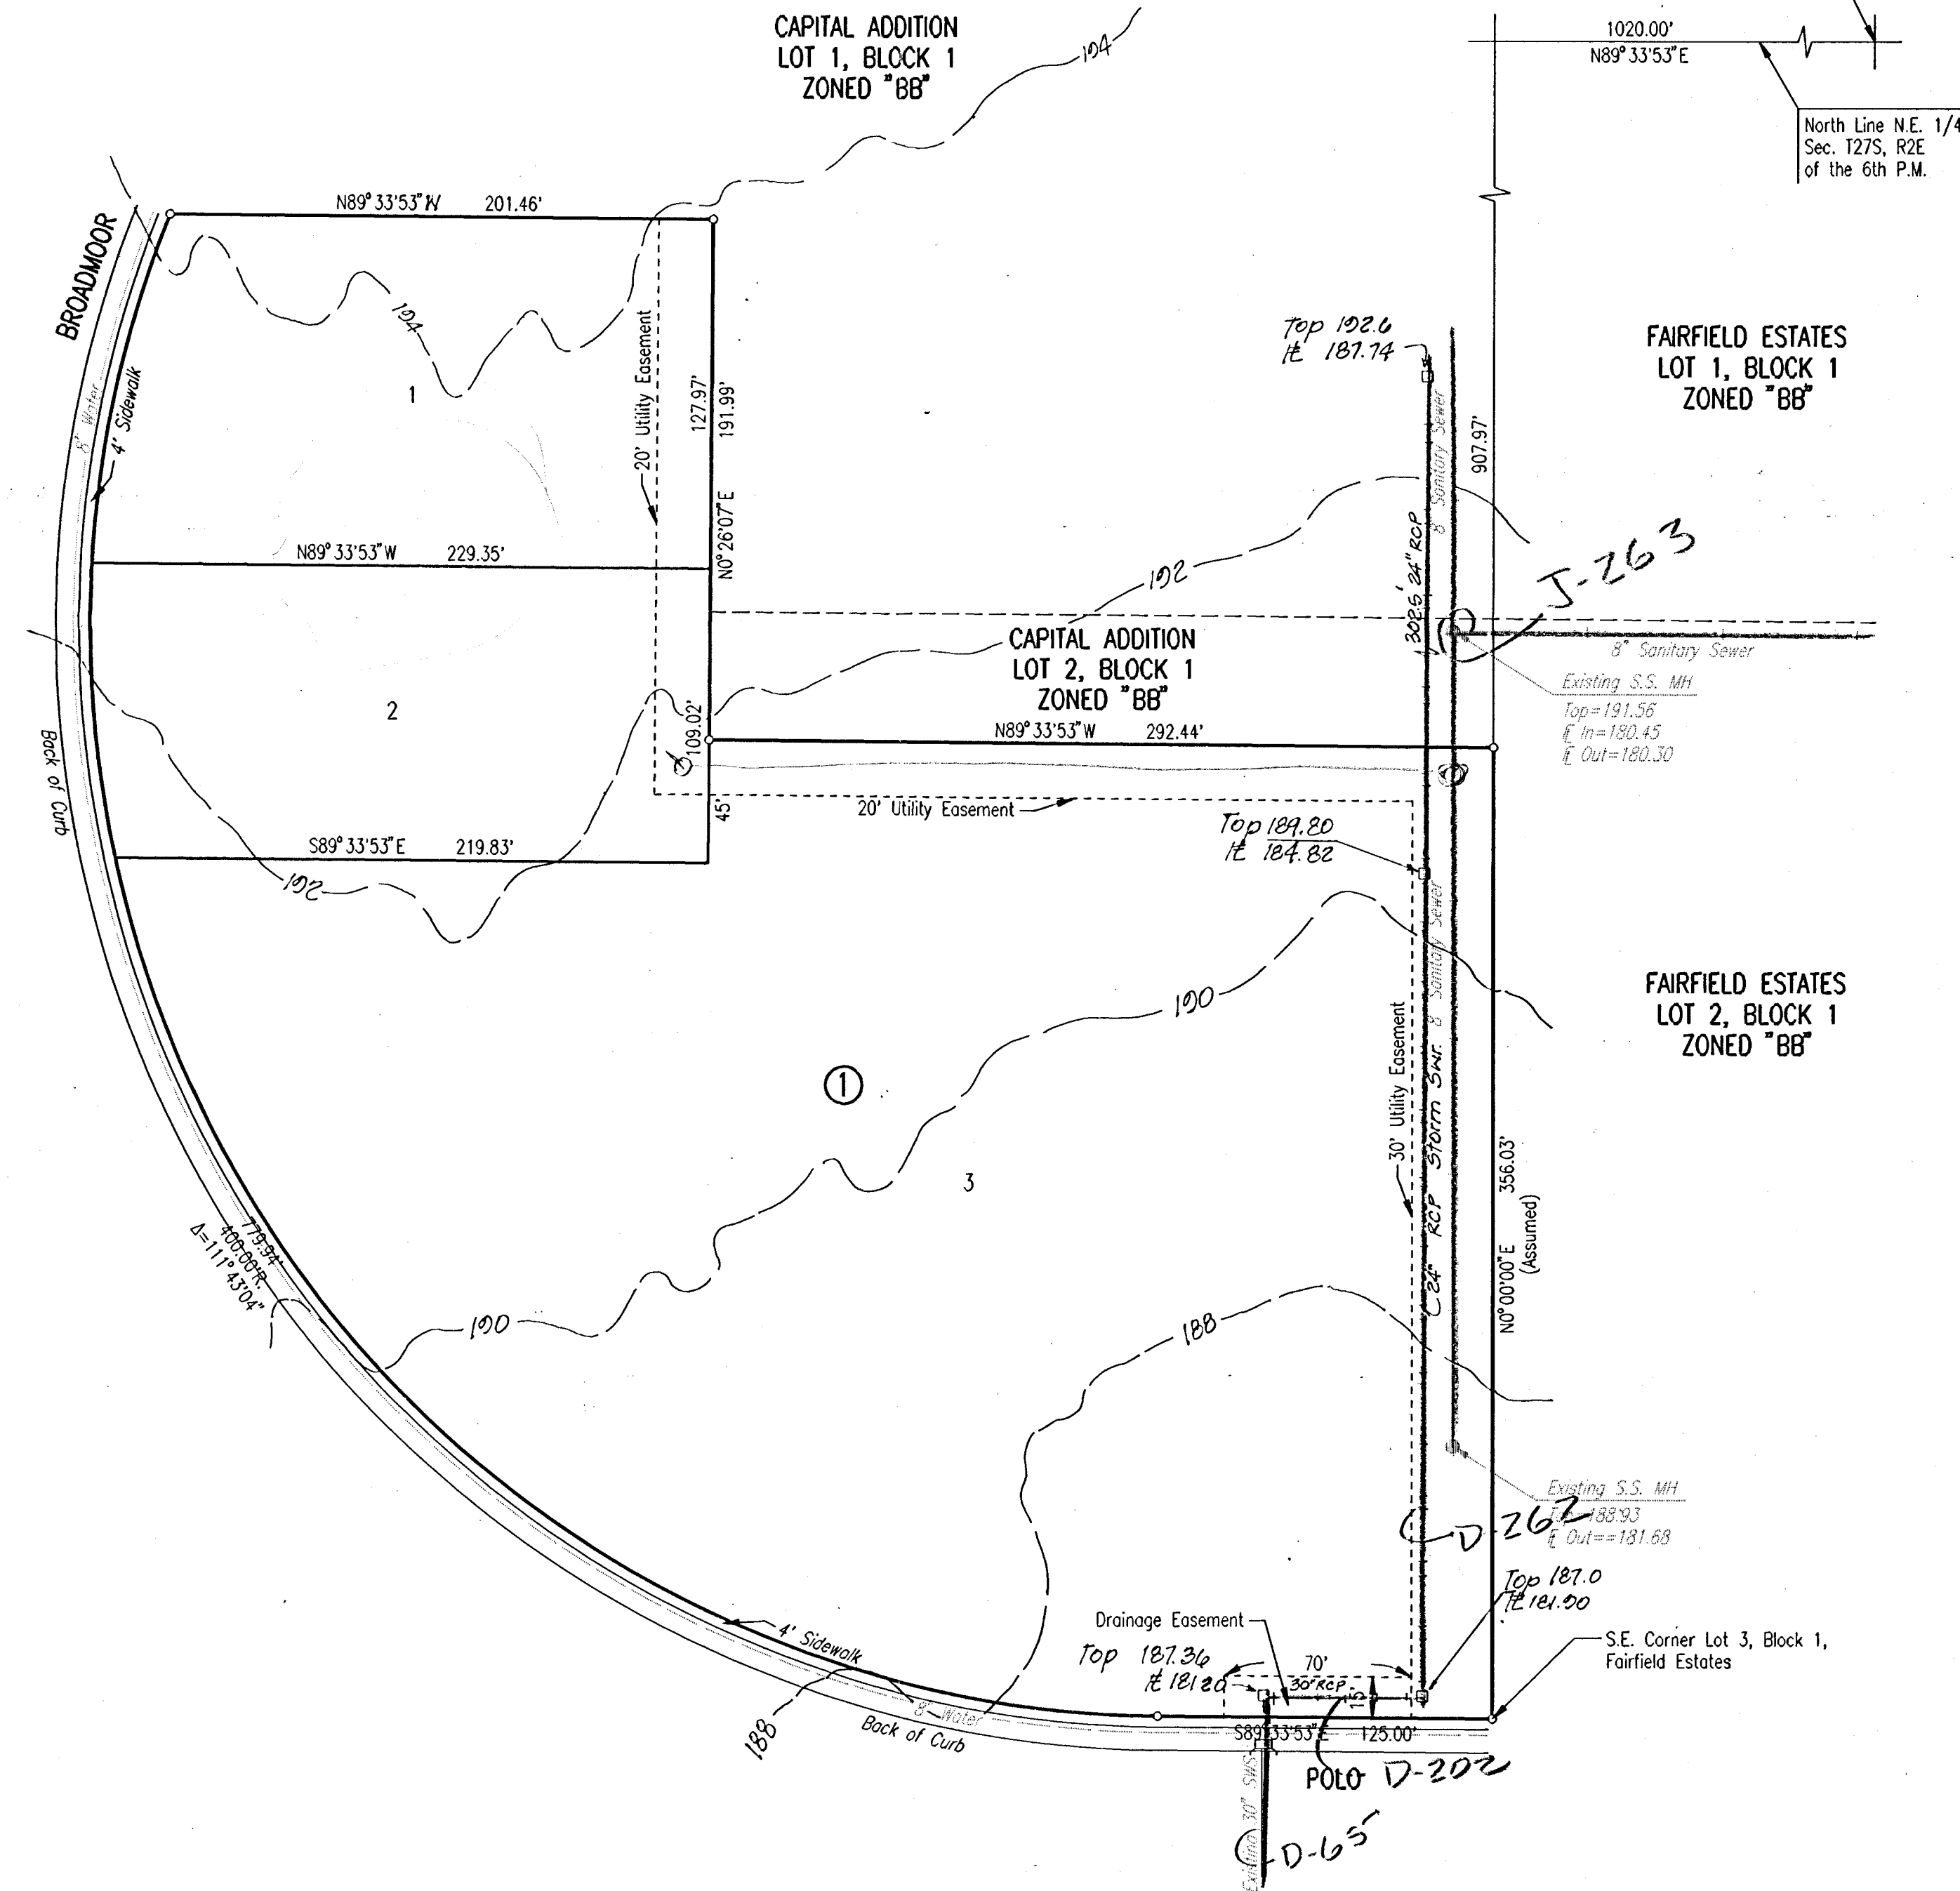

DSNR: SANCHEZ OFER: DEP SCALE: 1"=50.00  
 0:\1995\05570\WICMAP.DWG 11-10-1995 11:01:25 am