VICINITY MAP OF

CAPITAL 2ND ADDITION

OWNERS: W.K. CAPITAL ENTERPRISES, INC
DR. ROBERT D. SMITH
DR. JOAN C. LOEHR
DR. GERALD L. HOWELL
c/o SHAROL RASBERRY
300 N. MAIN - SUITE 200
WICHITA, KANSAS 67202

ENGINEEERS: PROFESSIONAL ENGINEERING CONSULTANTS, P.A.
303 S. TOPEKA
WICHITA, KANSAS 67202

SCALE: 1"=50'

o = IRON SET

B.M. - CHISELED "d" SOUTH END CURB RETURN
WEST SIDE OF ROCK ROAD AT EAST 1/4
CORNER SEC. 18, T27S, R2E
ELEV.=179.18 CITY DATUM

For Bldg setback lines
See C.U.P. DP-146
Topo: March 1985

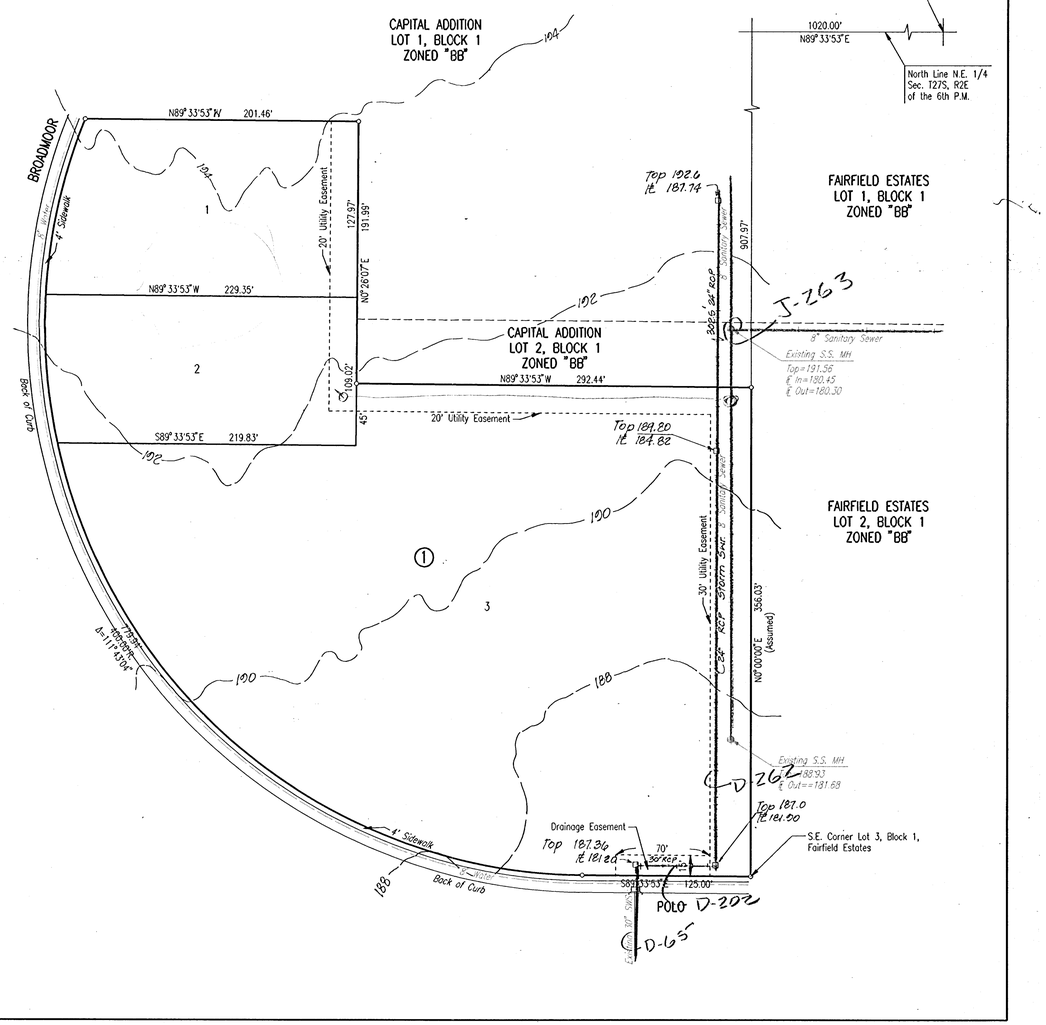

DSNR: SANCHEZ OPER: DEP SCALE: 1=50.00
O:\1995\95570\VICMAP.DWG 11-10-1995 11:01:25 am