27

PRELIMINARY PLAT

LEWIS C. CARPENTER ADDITION

WICHITA, SEDGWICK COUNTY, KANSAS

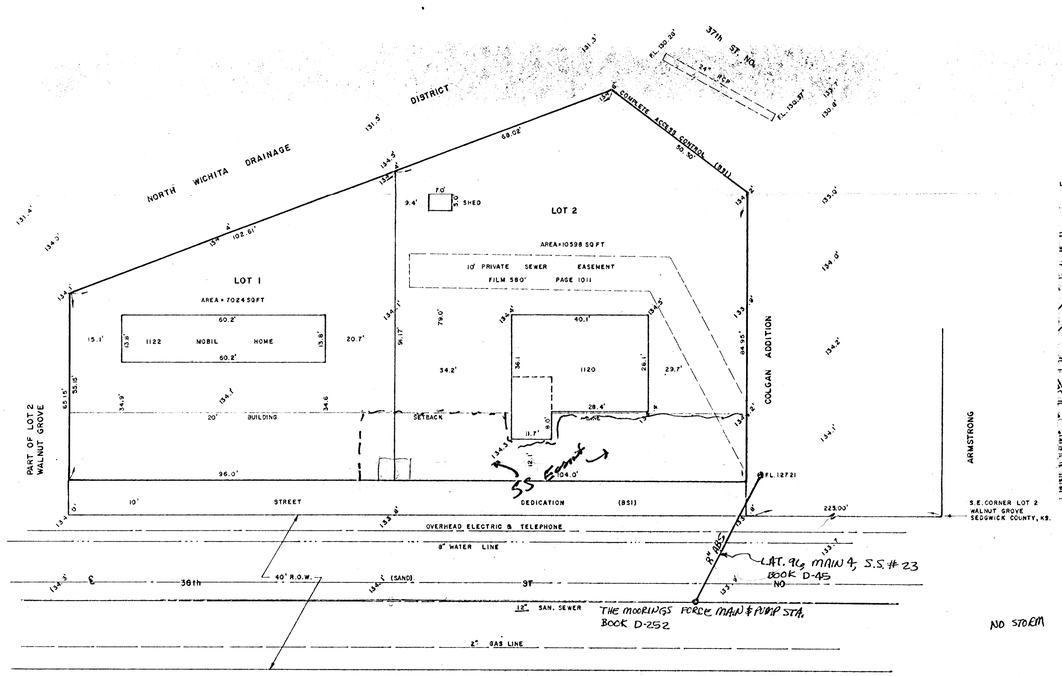

N

SCALE: 1" = 20'

BENCH MARK = R.R. SPIKE IN POWER POLE AT 35th ST. NO. & ARMSTRONG. ELEV. = 131.27'

DATE OF TOPOGRAPHIC SURVEY: 6/2/83

OWNER:
LEWIS C. CARPENTER
1122 W. 36th ST. NO.
WICHITA, KANSAS 67204

AIR CAPITOL LAND SURVEYORS
2160 W. 21st ST.
WICHITA, KS. 67203
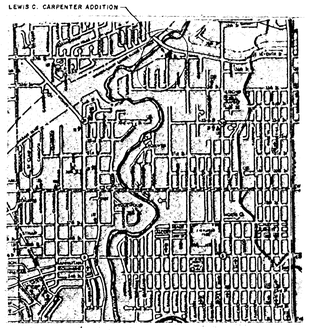
(BSI) = BY SEPERATE INSTRUMENT