Utility Concept

COMOTARA VILLAGE 3RD ADDITION

WICHITA, SEDGWICK COUNTY, KANSAS

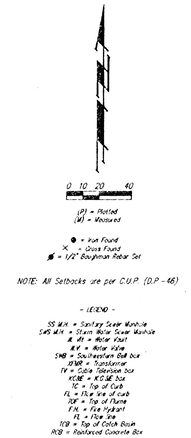

NOTE: All Setbacks are per C.U.P. (D.P.-48)

- LEGEND -

SS M.H. = Sanitary Sewer Manhole
SWS M.H. = Storm Water Sewer Manhole
W. V. = Water Vault
W.V. = Water Valve
SWB = Southwestern Bell box
TRANS = Transformer
TV = Cable Television box
KCME = KCME box
TC = Top of Curb
FL = Flow line of curb
TOP = Top of Plume
F.H. = Fire Hydrant
FL = Flow line
TCB = Top of Catch Basin
RCB = Reinforced Concrete Box

Legal Description:
A Replat of Lot 1, Comotara Villages Second Addition

Owner:
Alcon Development
Att'n: Chuck Caro
2400 N. Woodlawn
Wichita, KS 67220
Ph: 316-681-0529

Benchmark:
"U" in Mueller on fire hydrant at the NE. Cor. of Walden and Bramblewood
Elev. = 1317.39 City Datum

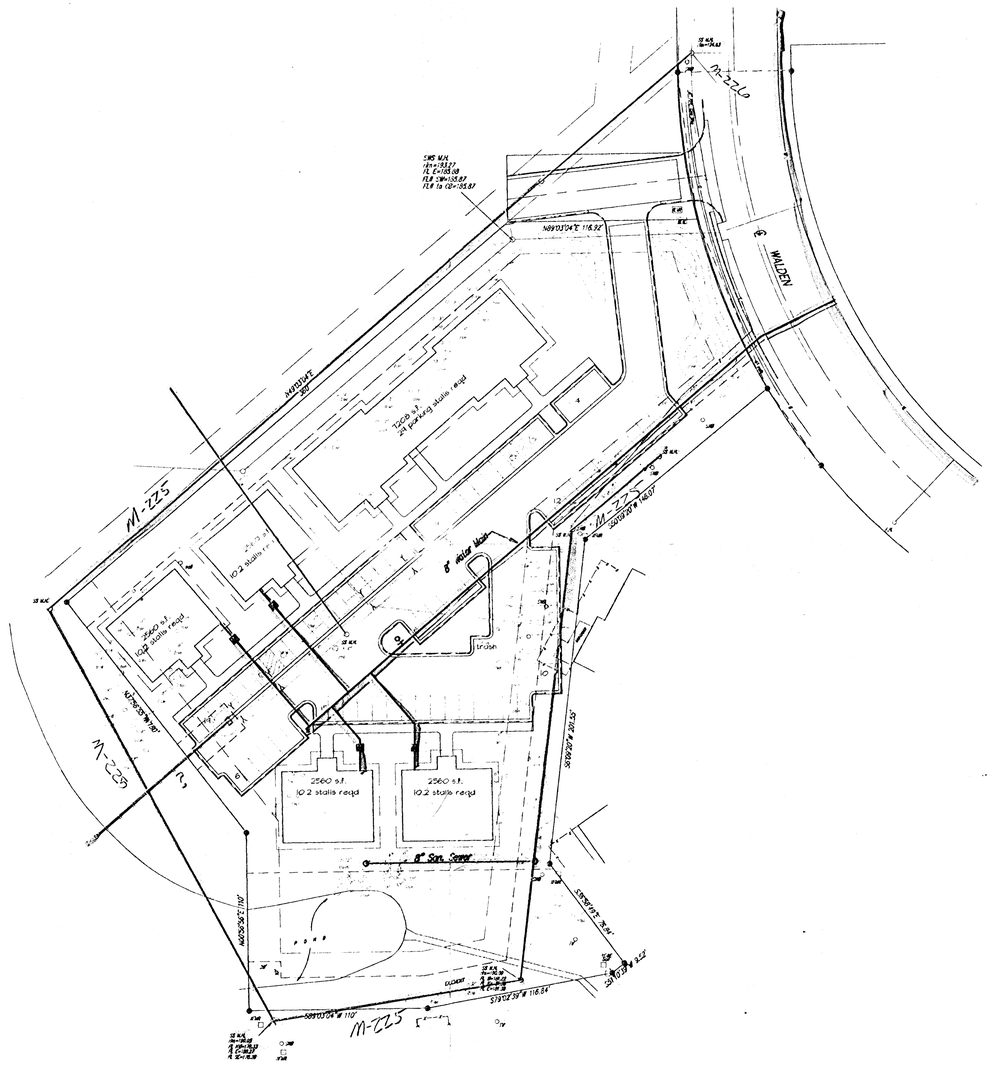

12-29-95

BAUGHMAN COMPANY P.A.
ENGINEERING, SURVEYING, & PLANNING
(316)-262-7271 • 315 ELLIS • WICHITA, KANSAS 67211

C:\util\como3ut