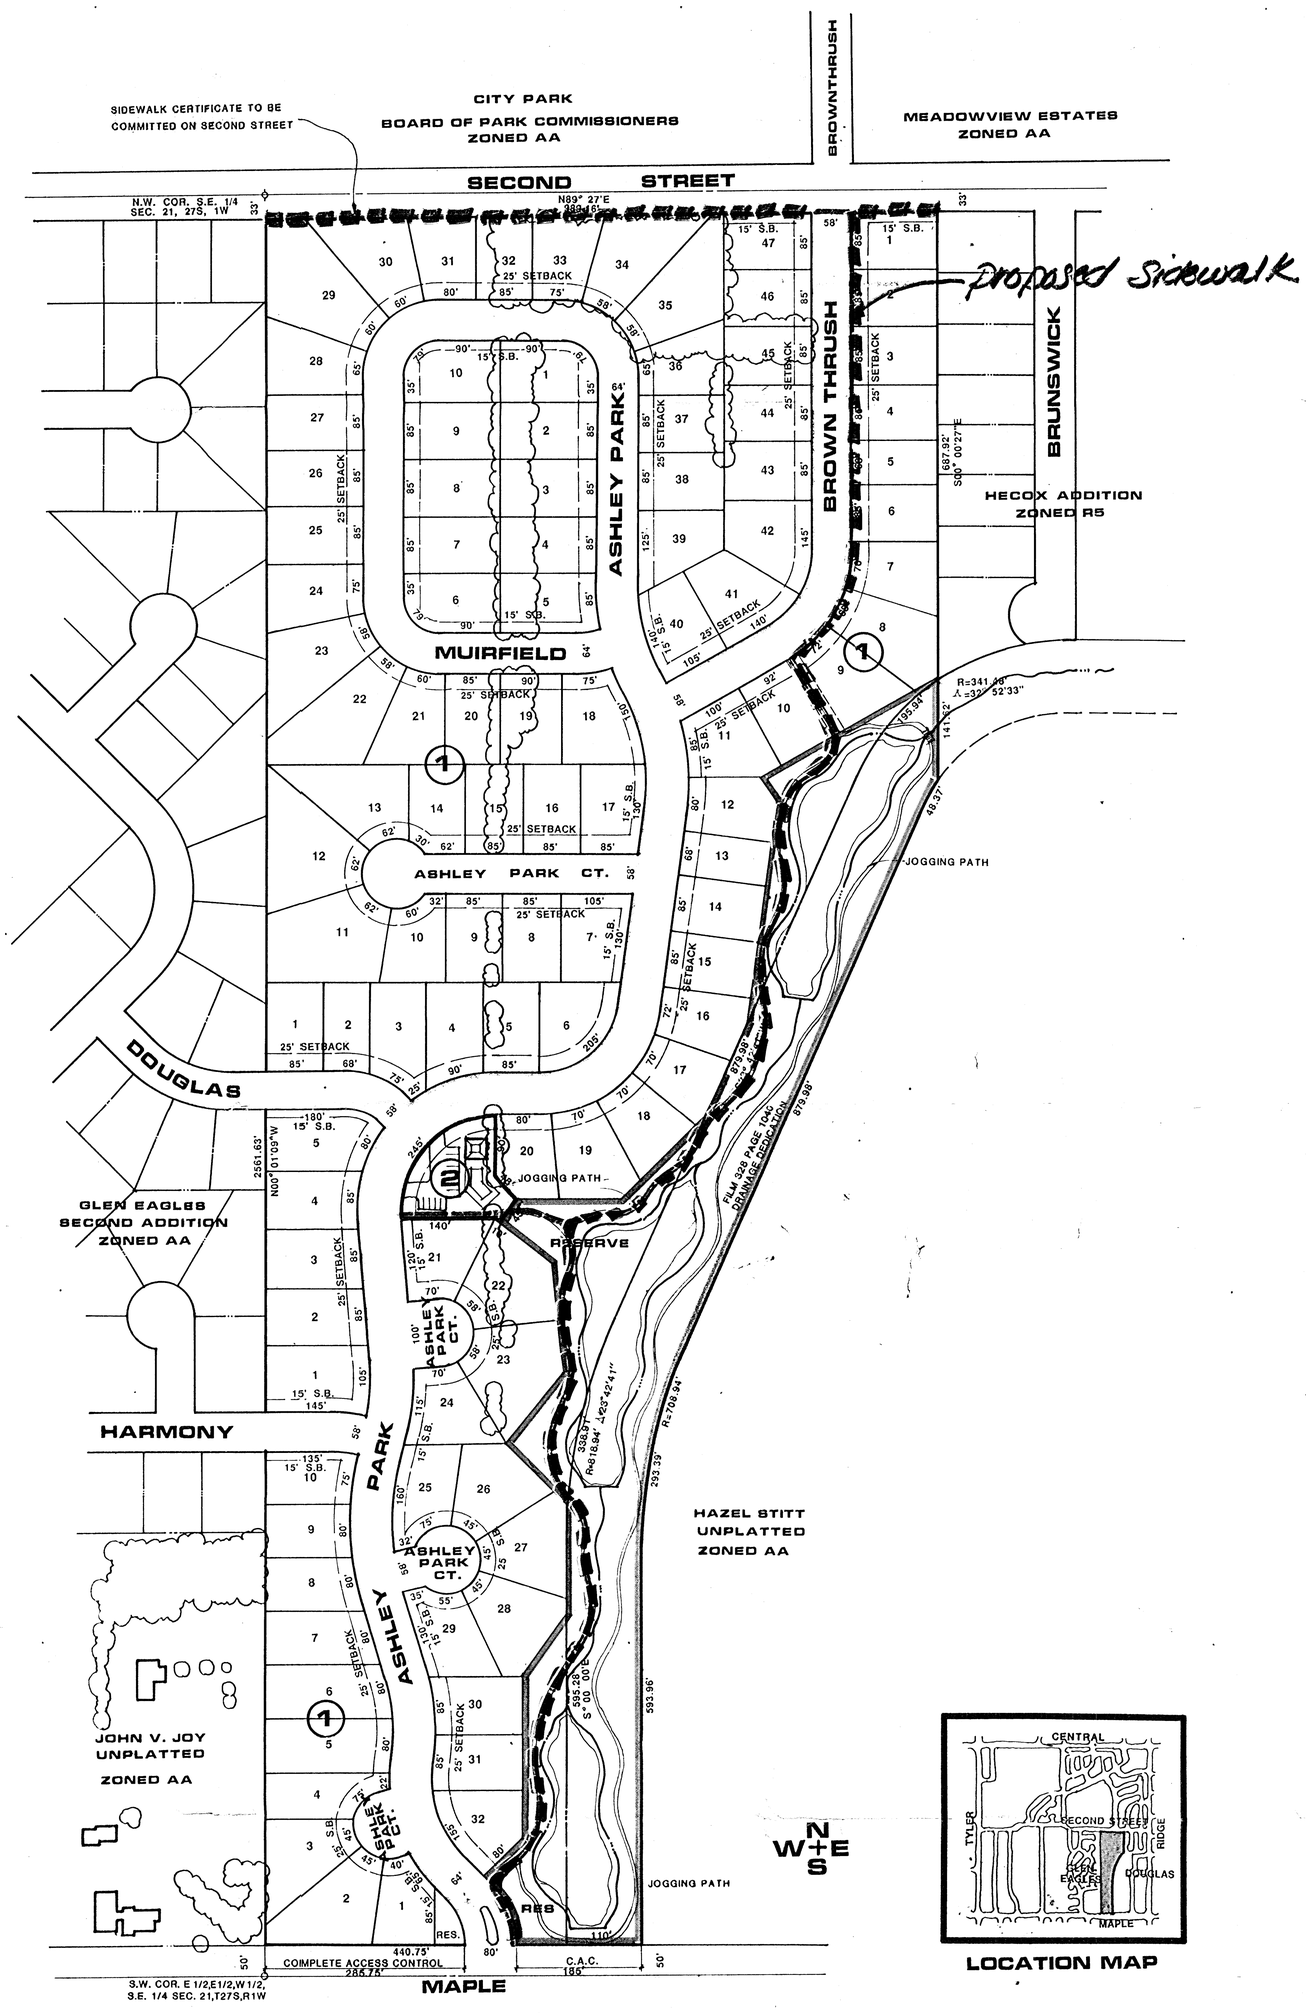

For Vicky

SIDEWALK PLAN

SIDEWALK PLAN

ASHLEY PARK (FORMERLY GREYSTONE ADDITION)

OWNER: J.W. RUSSELL 443 N. MAIZE ROAD, WICHITA, KS. 67212 PH. 722-2417

JULY 19, 1988

100' 50' 0 50' 100' 200'

BILL G. YUNG DESIGN
4812 E. 29TH STREET NORTH WICHITA, KS 67220 316 683-5647

C.E.