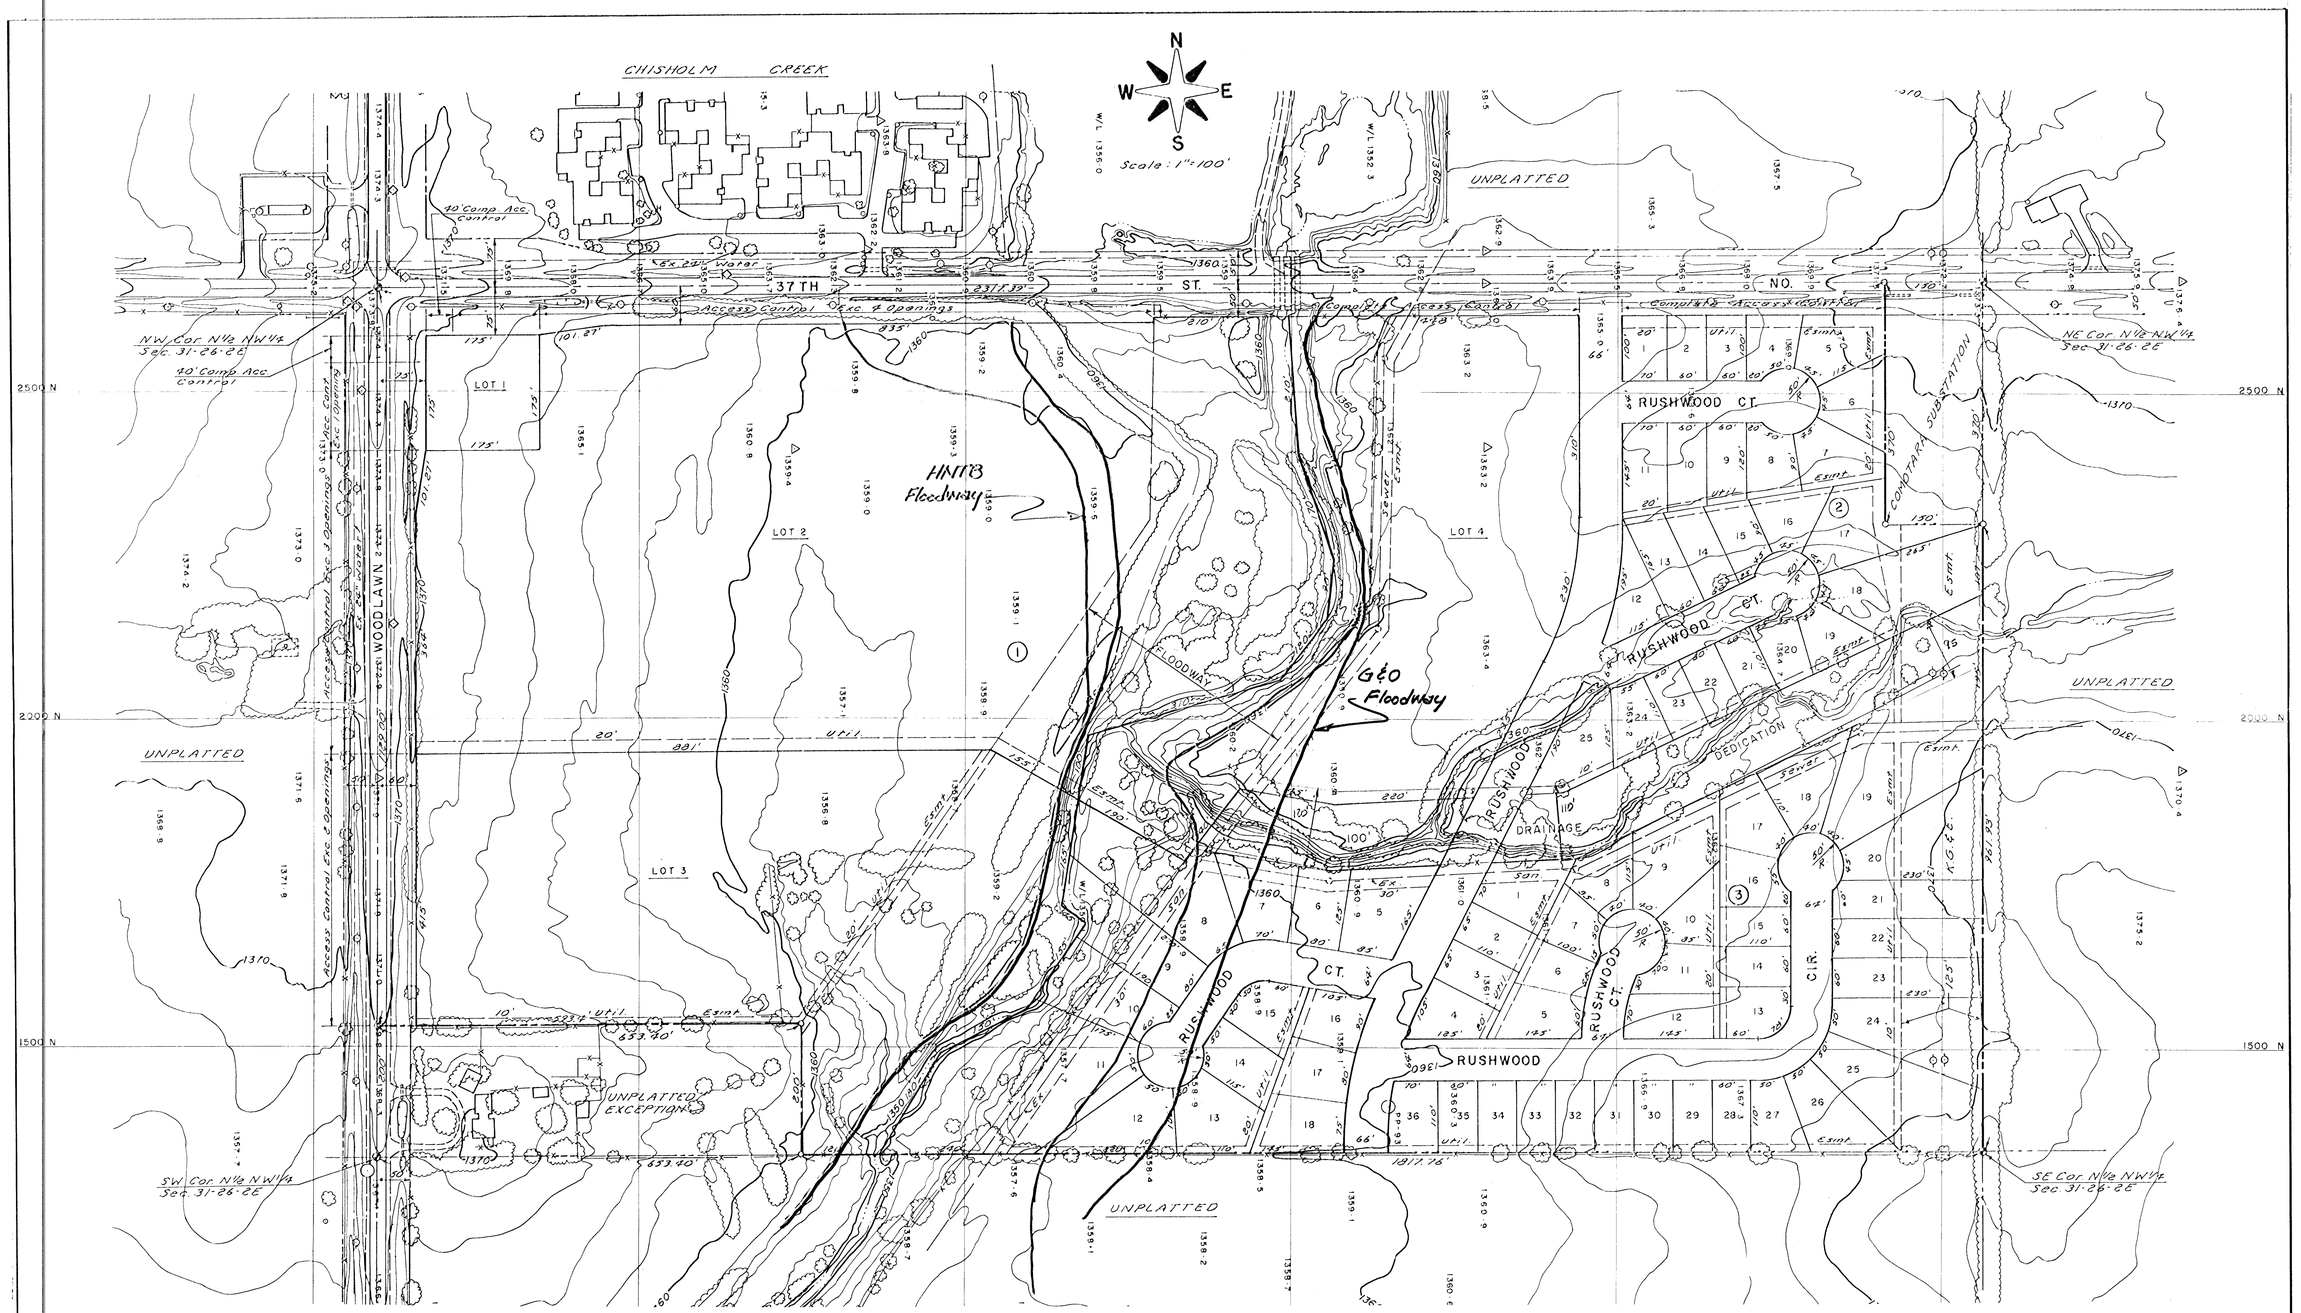

Note: Building Setbacks to Conform to Assoc. C.U.P.

PRELIMINARY PLAT

BRUSH CREEK ADDITION

THE N1/2 OF NW1/4 SEC. 31-26-2E, EXC. N.370' OF E. 150' & S. 200' OF W. 653.4'

May 12, 1983

BAUGHMAN COMPANY, P.A.
SURVEYING & ENGINEERING
316/262-7271 • 330 LAURA • WICHITA, KANSAS 67211