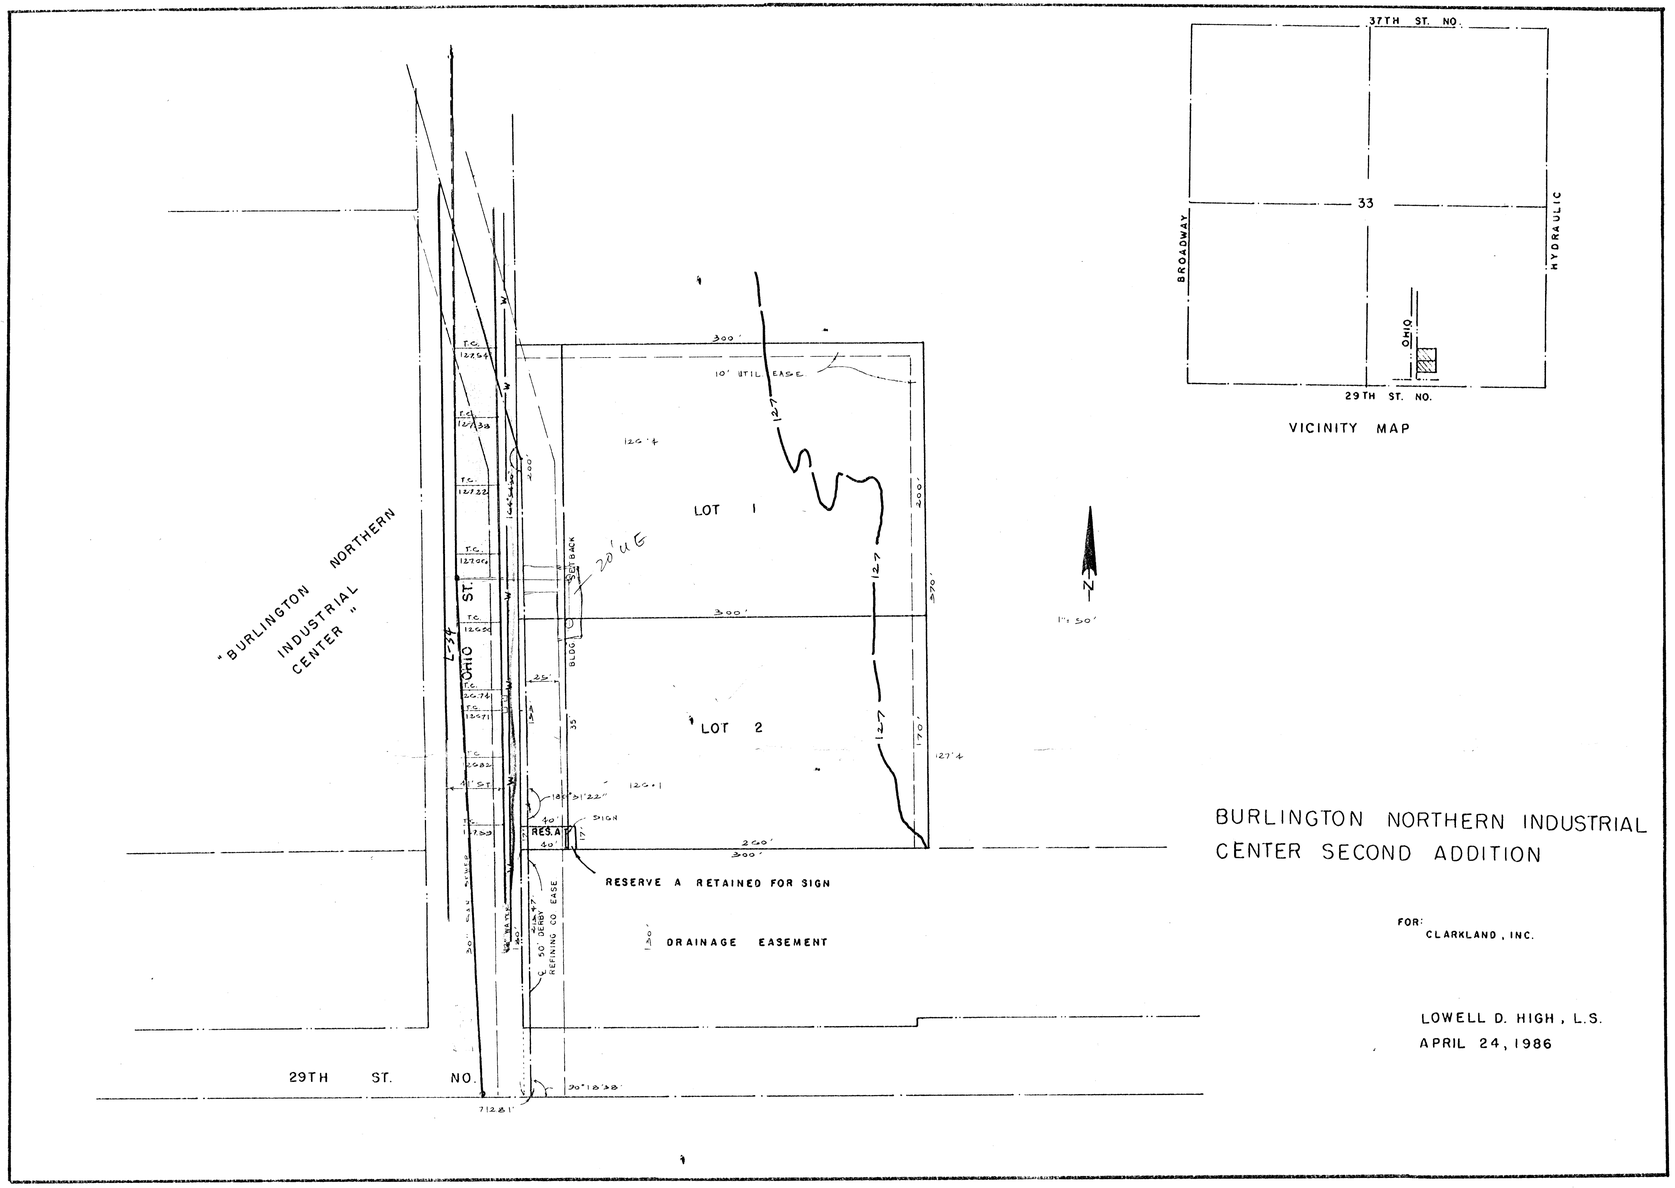

VICINITY MAP

BURLINGTON NORTHERN INDUSTRIAL CENTER SECOND ADDITION

FOR:
CLARKLAND, INC.

LOWELL D. HIGH, L.S.
APRIL 24, 1986