


$C_2 = 0.68$


$C_{100} = 0.80$

USE TC = 15 MIN.

$L_1 = 3.83$

$L_2 = 7.37$

SCALE: 1" = 100'

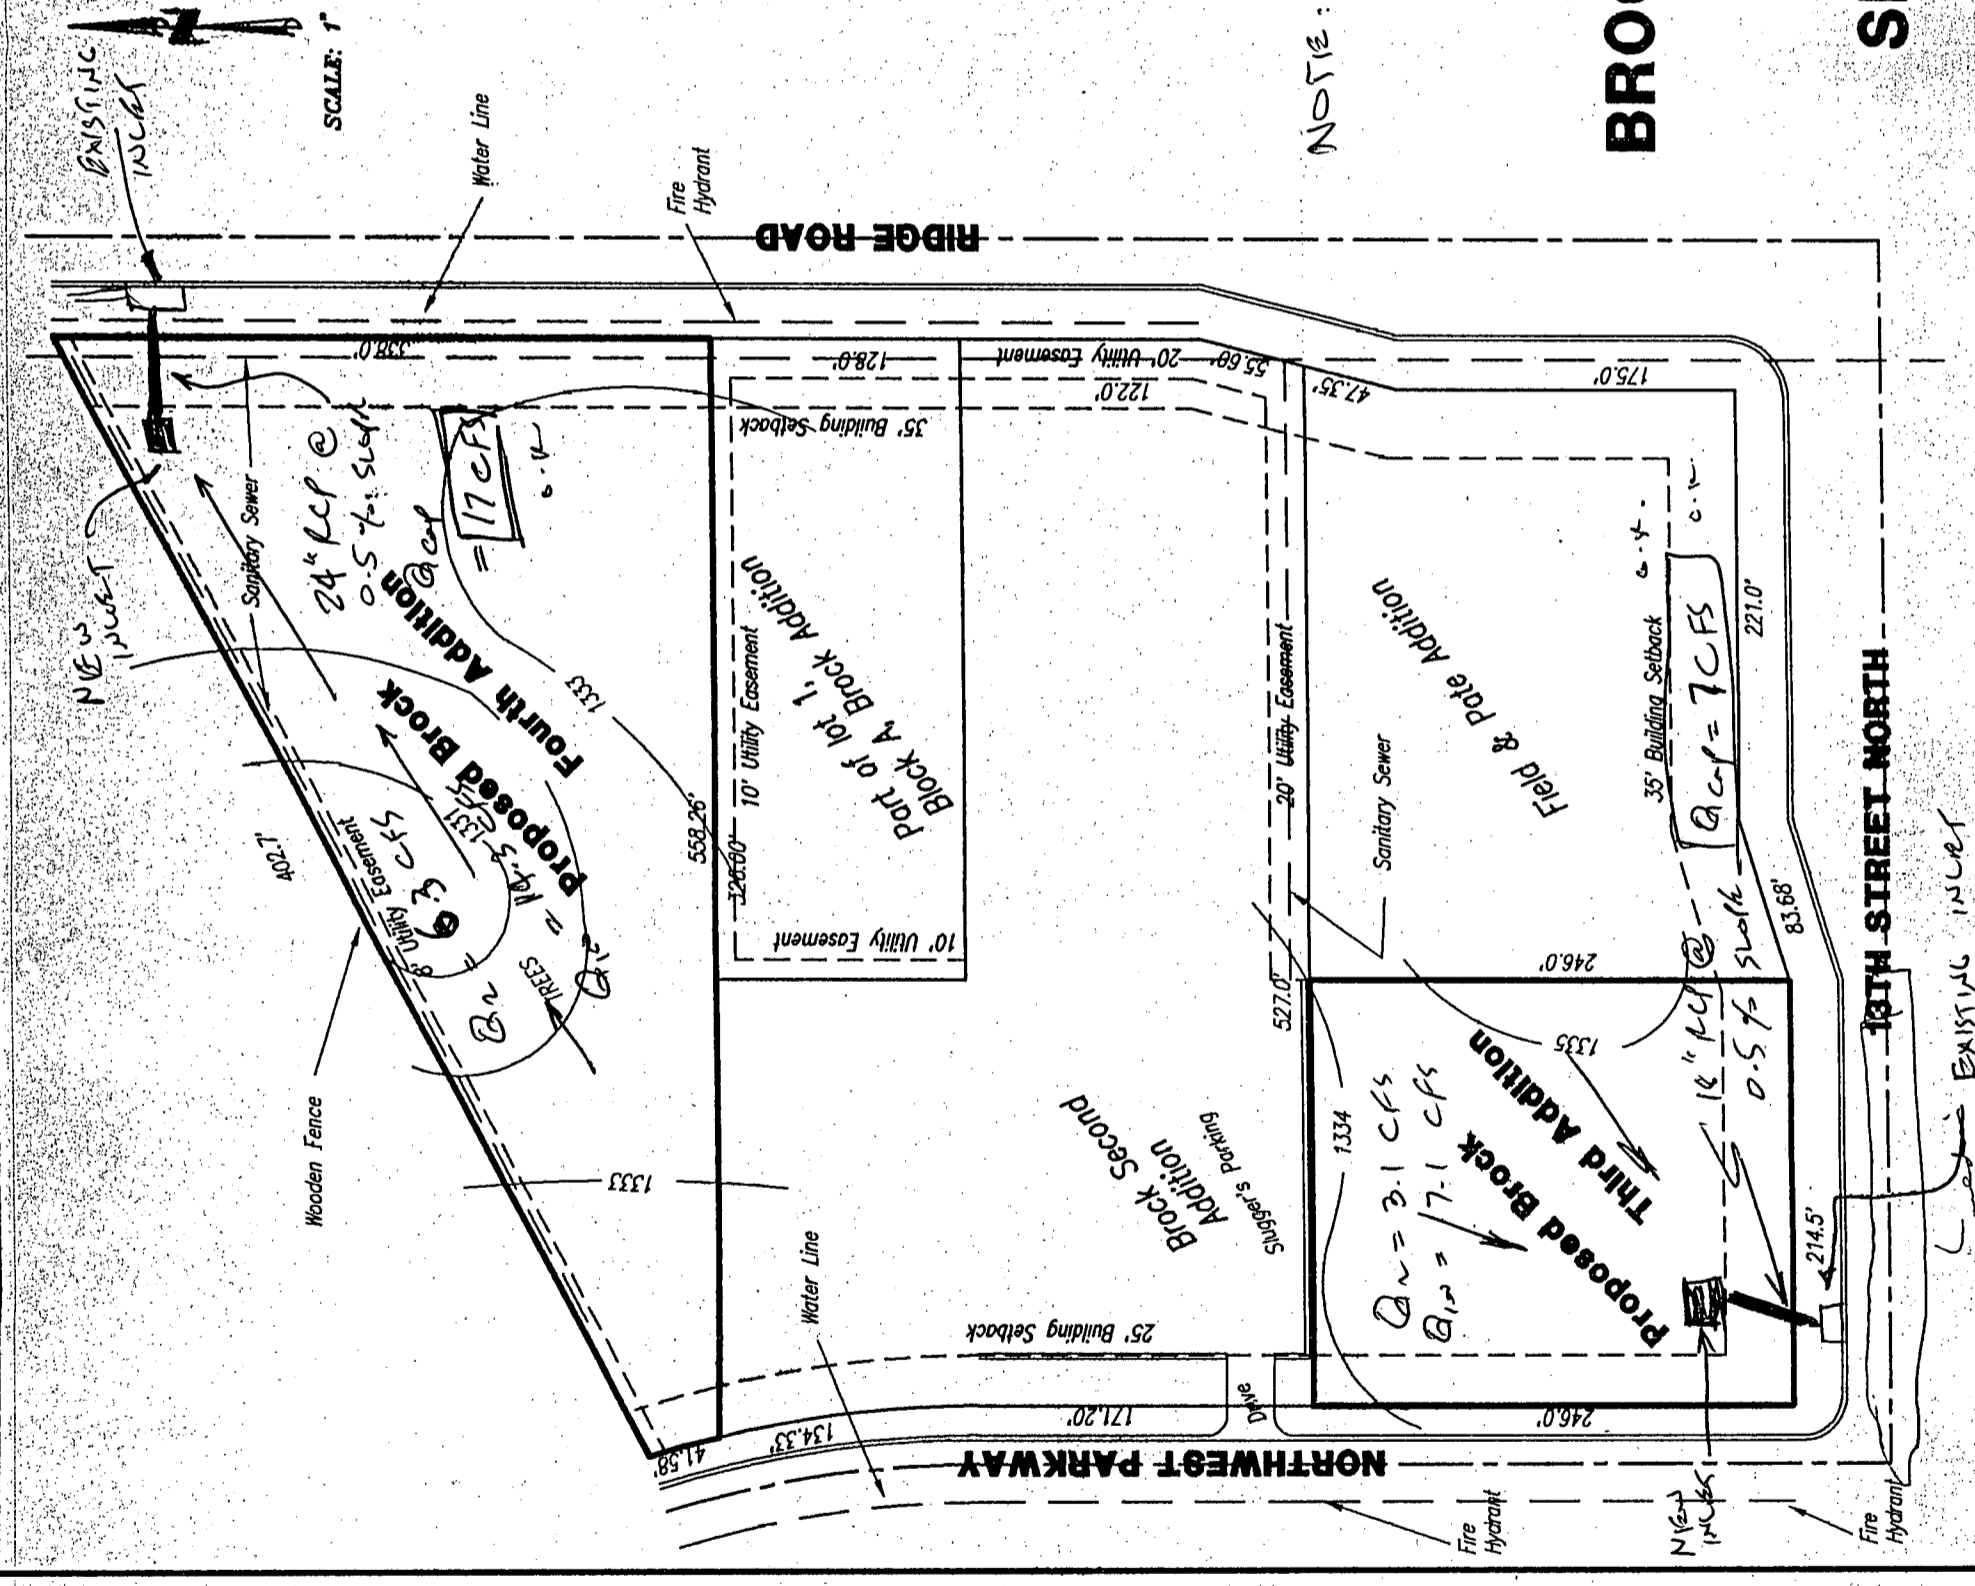

NOTE: STORM RETAINAGE MAP BE PROVIDED IN PARKING LOTS UPON DRAINAGE ANALYSIS.

DRAINAGE CALCULATIONS

# VICINITY MAP BROCK THIRD & FOURTH ADDITION TO WICHITA

## SEDGWICK COUNTY, KANSAS

A/2/97 K.C.

**OWNER:**

Patice Properties, LLC  
243 Portlock Road  
Honolulu, HI 96825

**SURVEYOR/ENGINEER:**

Babar M. Khan  
Municipal Engineers, P.A.  
254-Laura, Suite 201  
Wichita, Kansas 67211

