

PRELIMINARY PLAN

BRAD BOONE ADDITION

LOT 1, BLOCK 2, E. E. JABES ADDITION TO WICHITA, SEDGWICK COUNTY, KANSAS.


ROBERT B. BOONE

N


1" = 60'
Elev. = City Datum

BENCH MARK:
City Standard Disc (17th & Rock Rd)
28' E of & Rock Rd & 51' N. of
& R.R. Tracks
Elev. = 199.701 City Datum

LOT GRADING PLAN:
The lots shall be graded to
drain to the streets and drain-
age ditch via approved
driveways, frames, inlets, etc.
at the time of development.

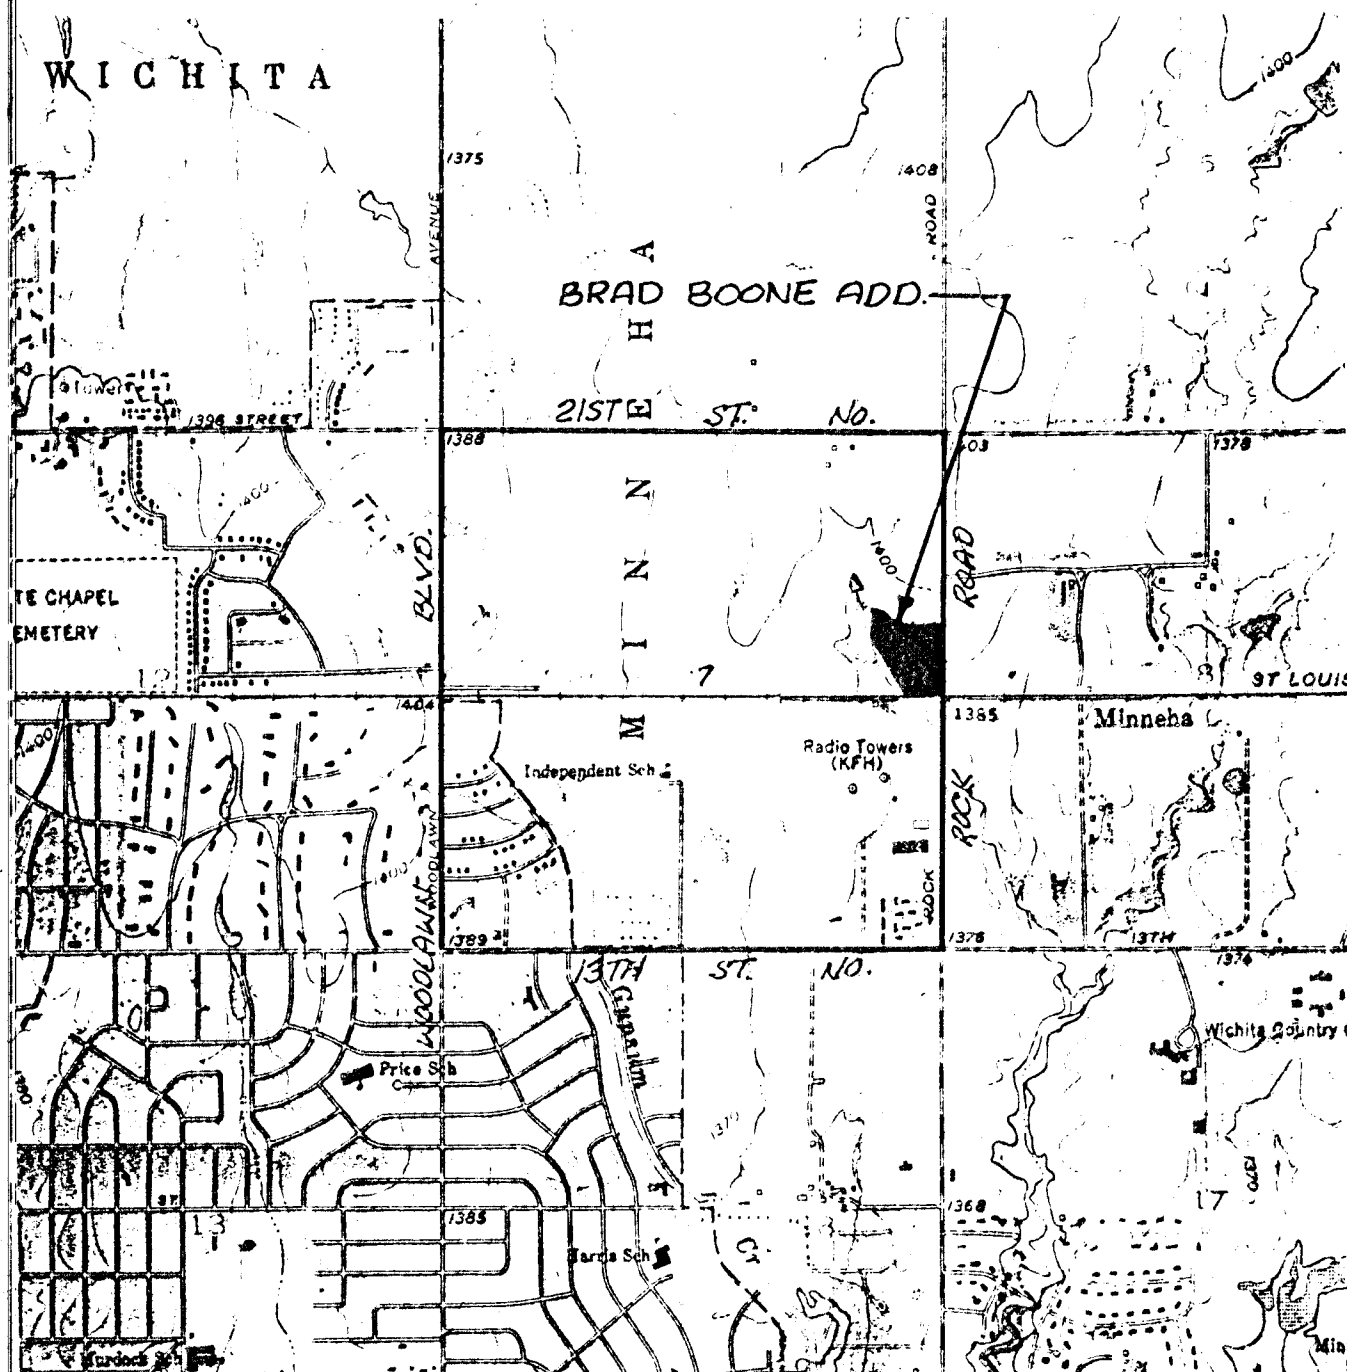

VICINITY PLAT
1" = 2000'

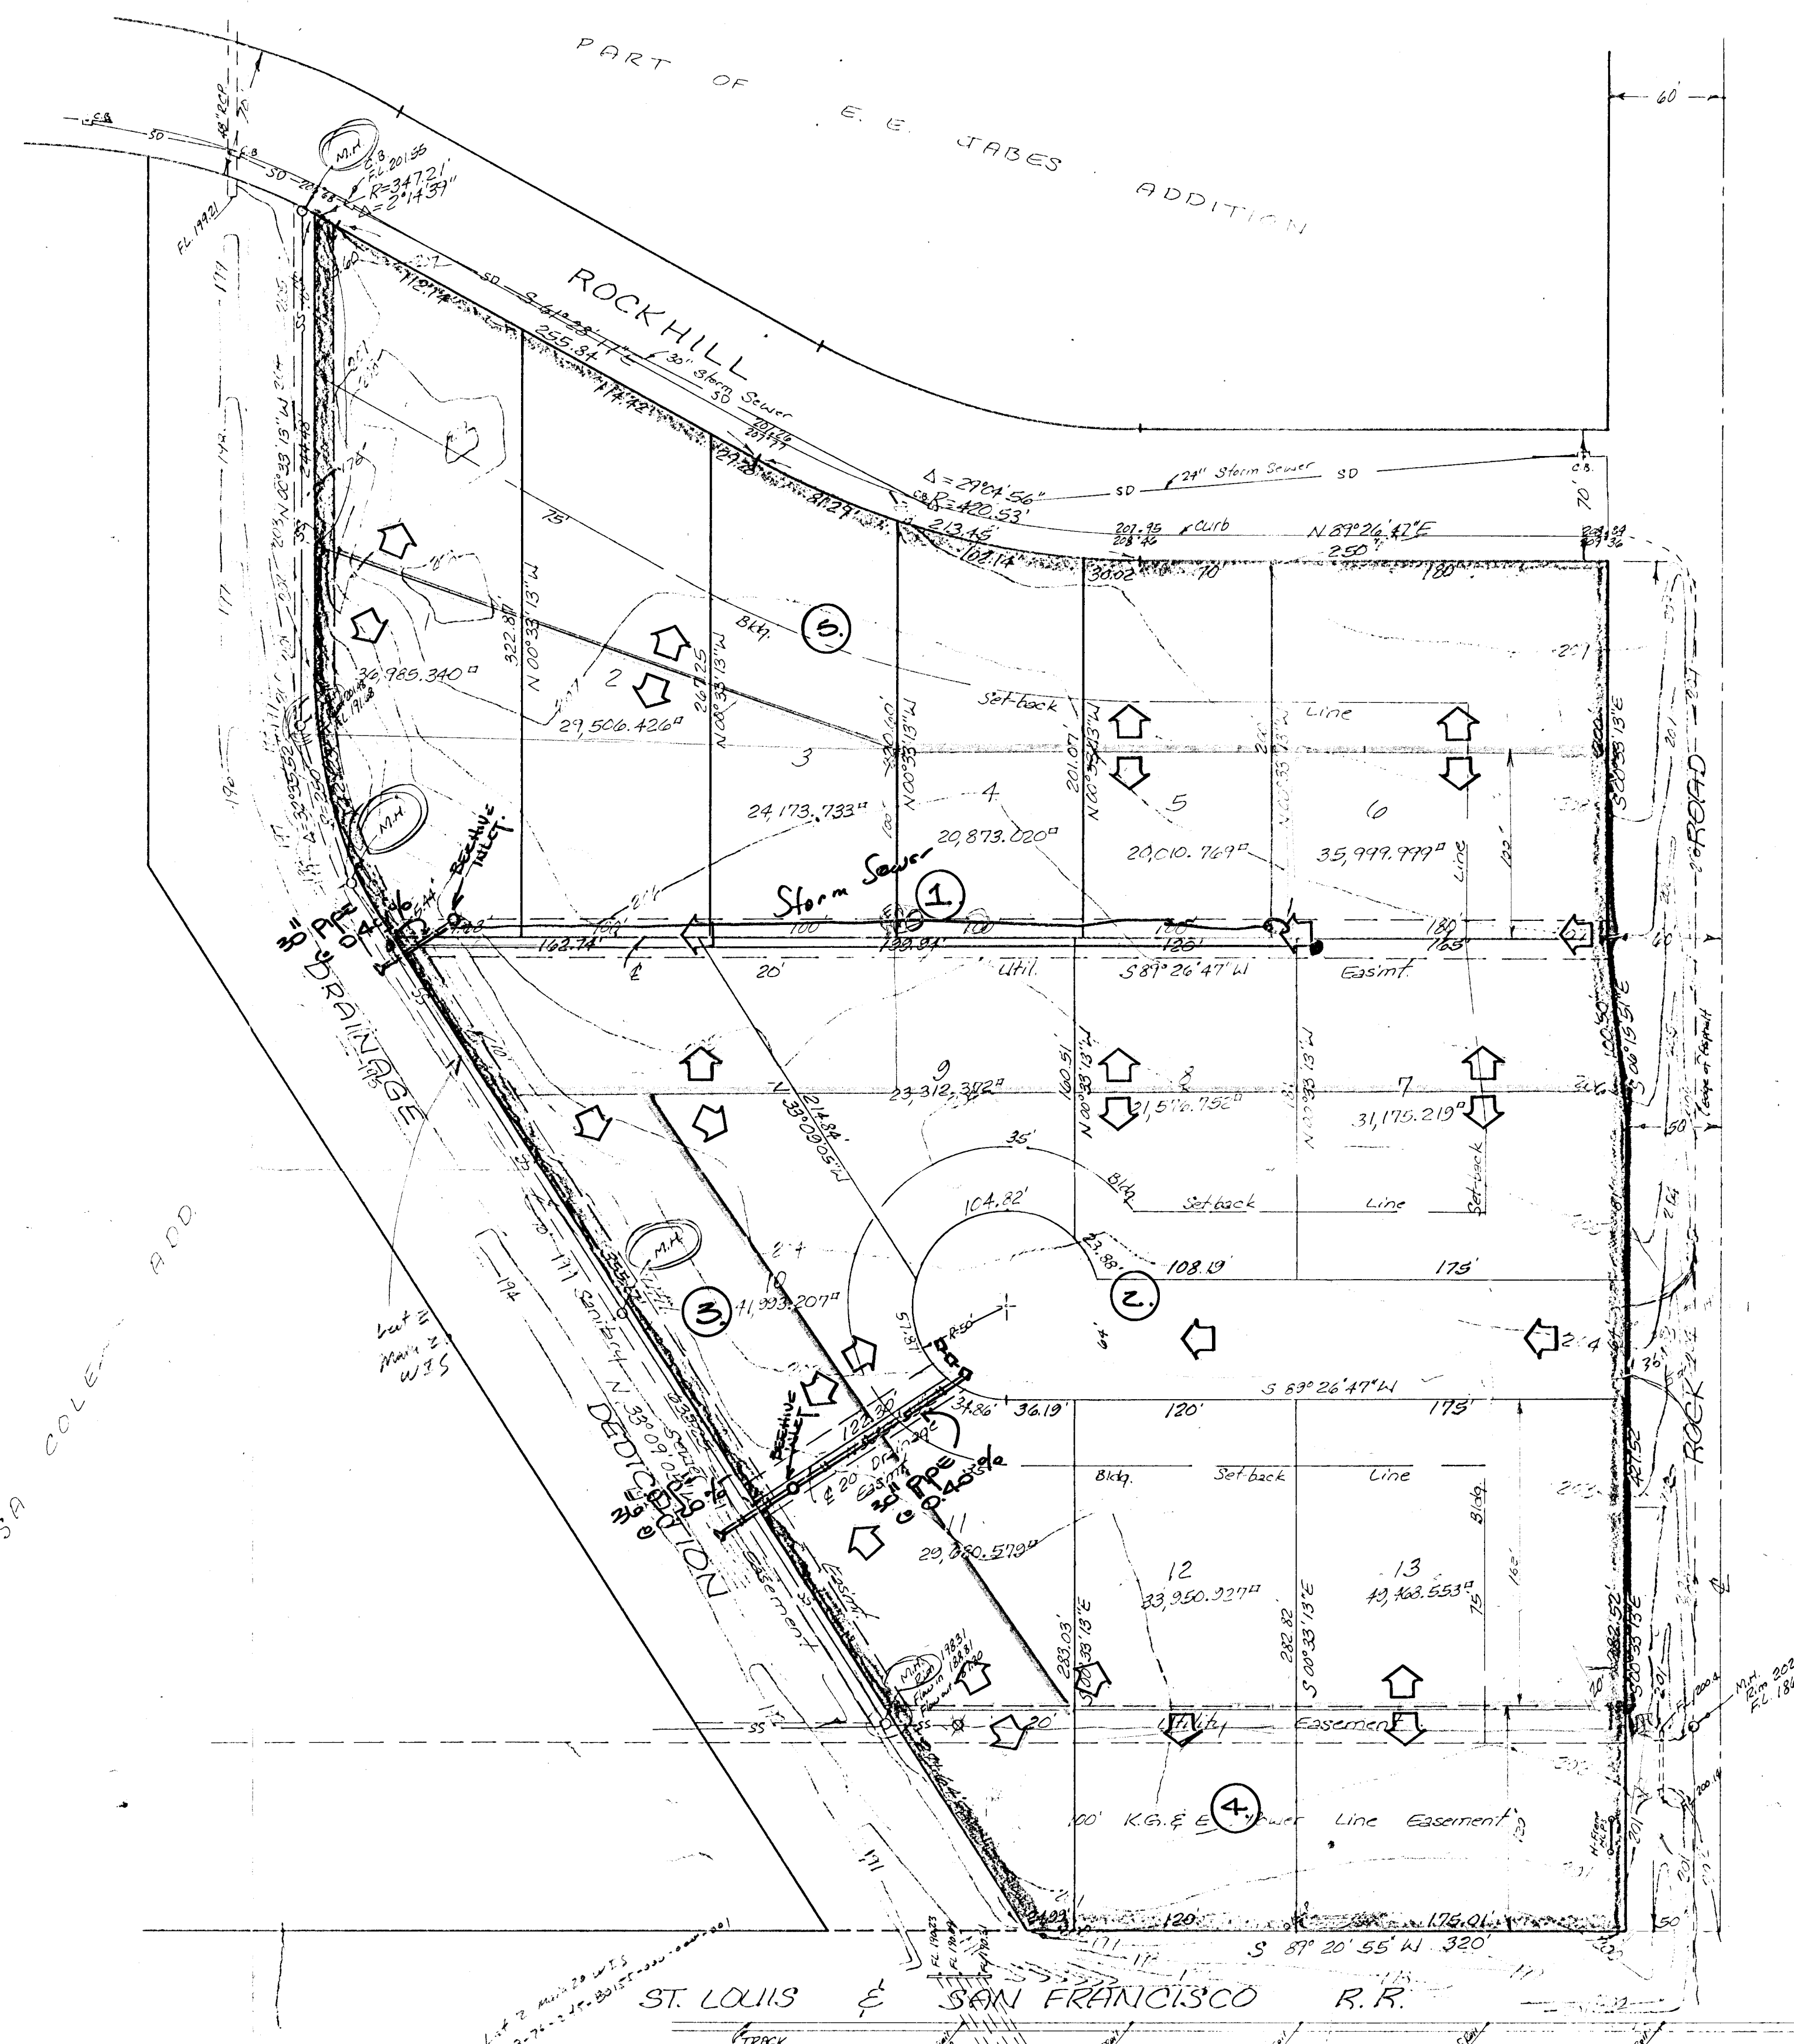

needs
letter
for south
sewer
serving
that was
total
E. E. Jabes
which was
already
approved
for S.E. could
be approved
again

SWS 112
or
SWS 134

NOTE:
GROSS SIZE OF PLAT
425,103,237 sq. ft.
9.757 acres

— DRAINAGE PLAN —

BAUGHMAN COMPANY, P.A.
SURVEYORS
316/262-7271 • 330 LAURA • WICHITA, KANSAS 67211

23 DEC 80
15 NOV 80
24 SEP 80