


N
 1" = 100'
 Elev = City Datum

BENCH MARK:
 City Standard Disc. 442' W.
 & 35' NE 1/4 of E. of Oliver
 and Geo Wash. Blvd.
 Elev. = 123.693 City Datum

McCConnell Air Force Base

With Mc
 13:11
 on intersection
 design

Recommend
 realign St.
 to intersect
 at 75'

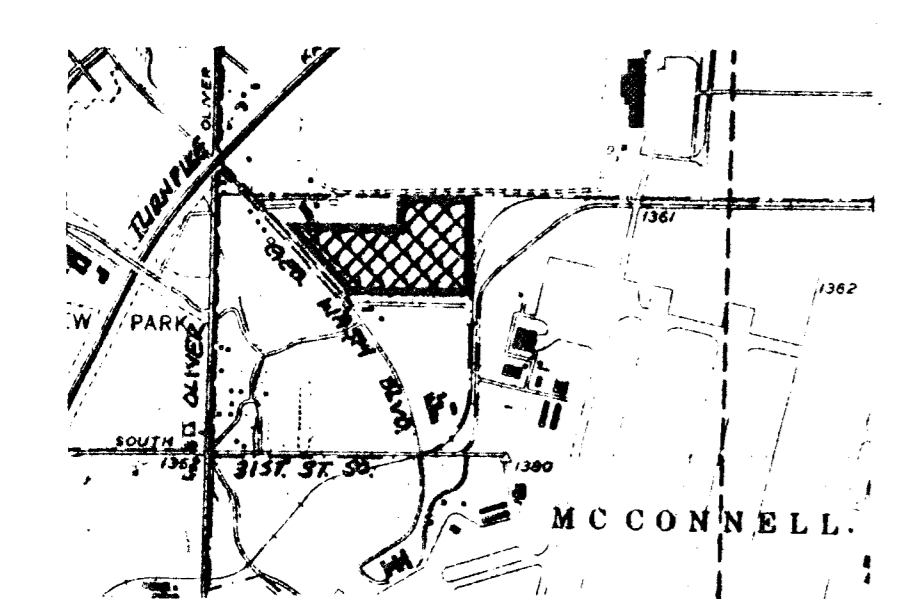

VICINITY PLAT
 1" = 2000'

PRELIMINARY PLAT
CHUZY BUSINESS PARK

TRACT IN THE SW 1/4 OF SEC. 1, TWP. 28-S, R-1-E

CARL CHUZY