


BENCHMARK:
 "□" cut top of curb, Southeast corner of Orme
 and Eastern Elevation = 143.21 City Datum

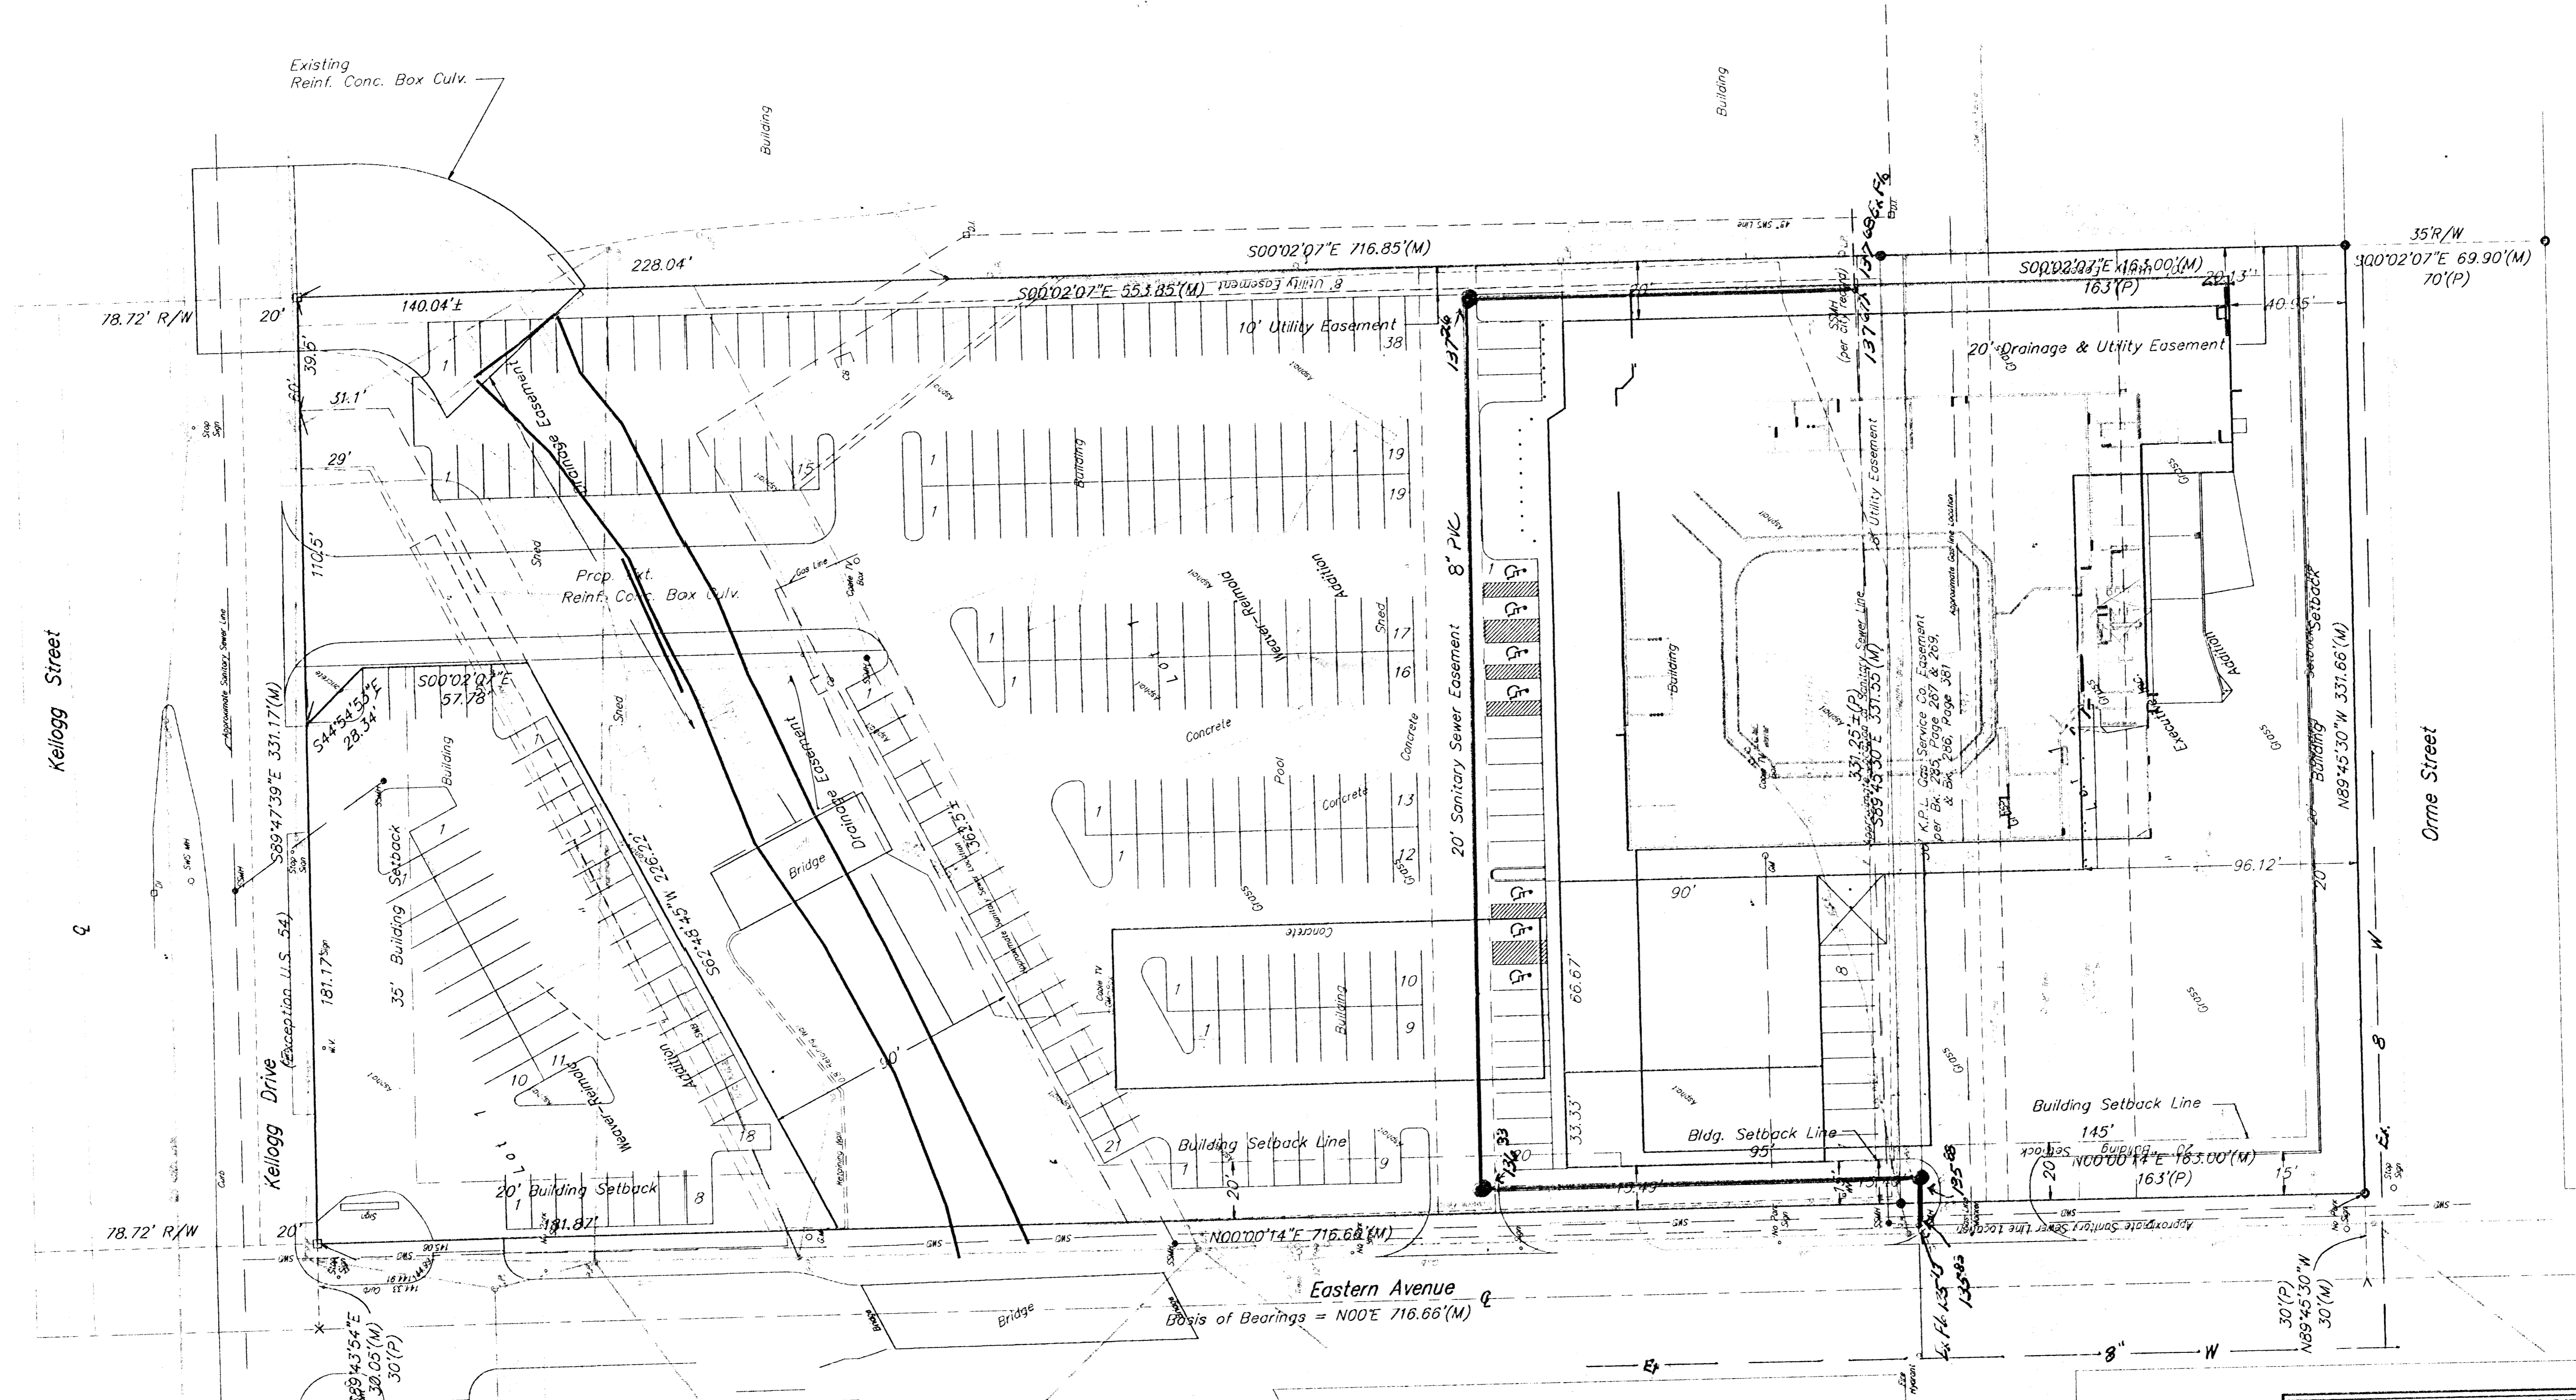

Eastern Avenue
 Basis of Bearings = N00°E 716.66'(M)

CIRCUIT CITY
UTILITY PLAN
 LOT 1, CIRCUIT CITY ADDITION

BAUGHMAN COMPANY P. A.
 ENGINEERING, SURVEYING, & PLANNING

510-292-7271 • 510 ELLIS • MOHTA, KANSAS 67211

DESIGN B.P.	DRAWN B.P.	APPROVED	DATE 1-22-26
PROJECT NUMBER		SCALE 1"=50'	
SHEET		OF	