


PRELIMINARY PLAT OF
BRADLEY FAIR 2ND ADDITION

OWNER: WILSON ESTATES
 200 MARKET CENTRE 155 N. MARKET
 WICHITA, KANSAS 67206

ENGINEER: PROFESSIONAL ENGINEERING CONSULTANTS, P.A.
 303 S. TOPEKA
 WICHITA, KANSAS 67202

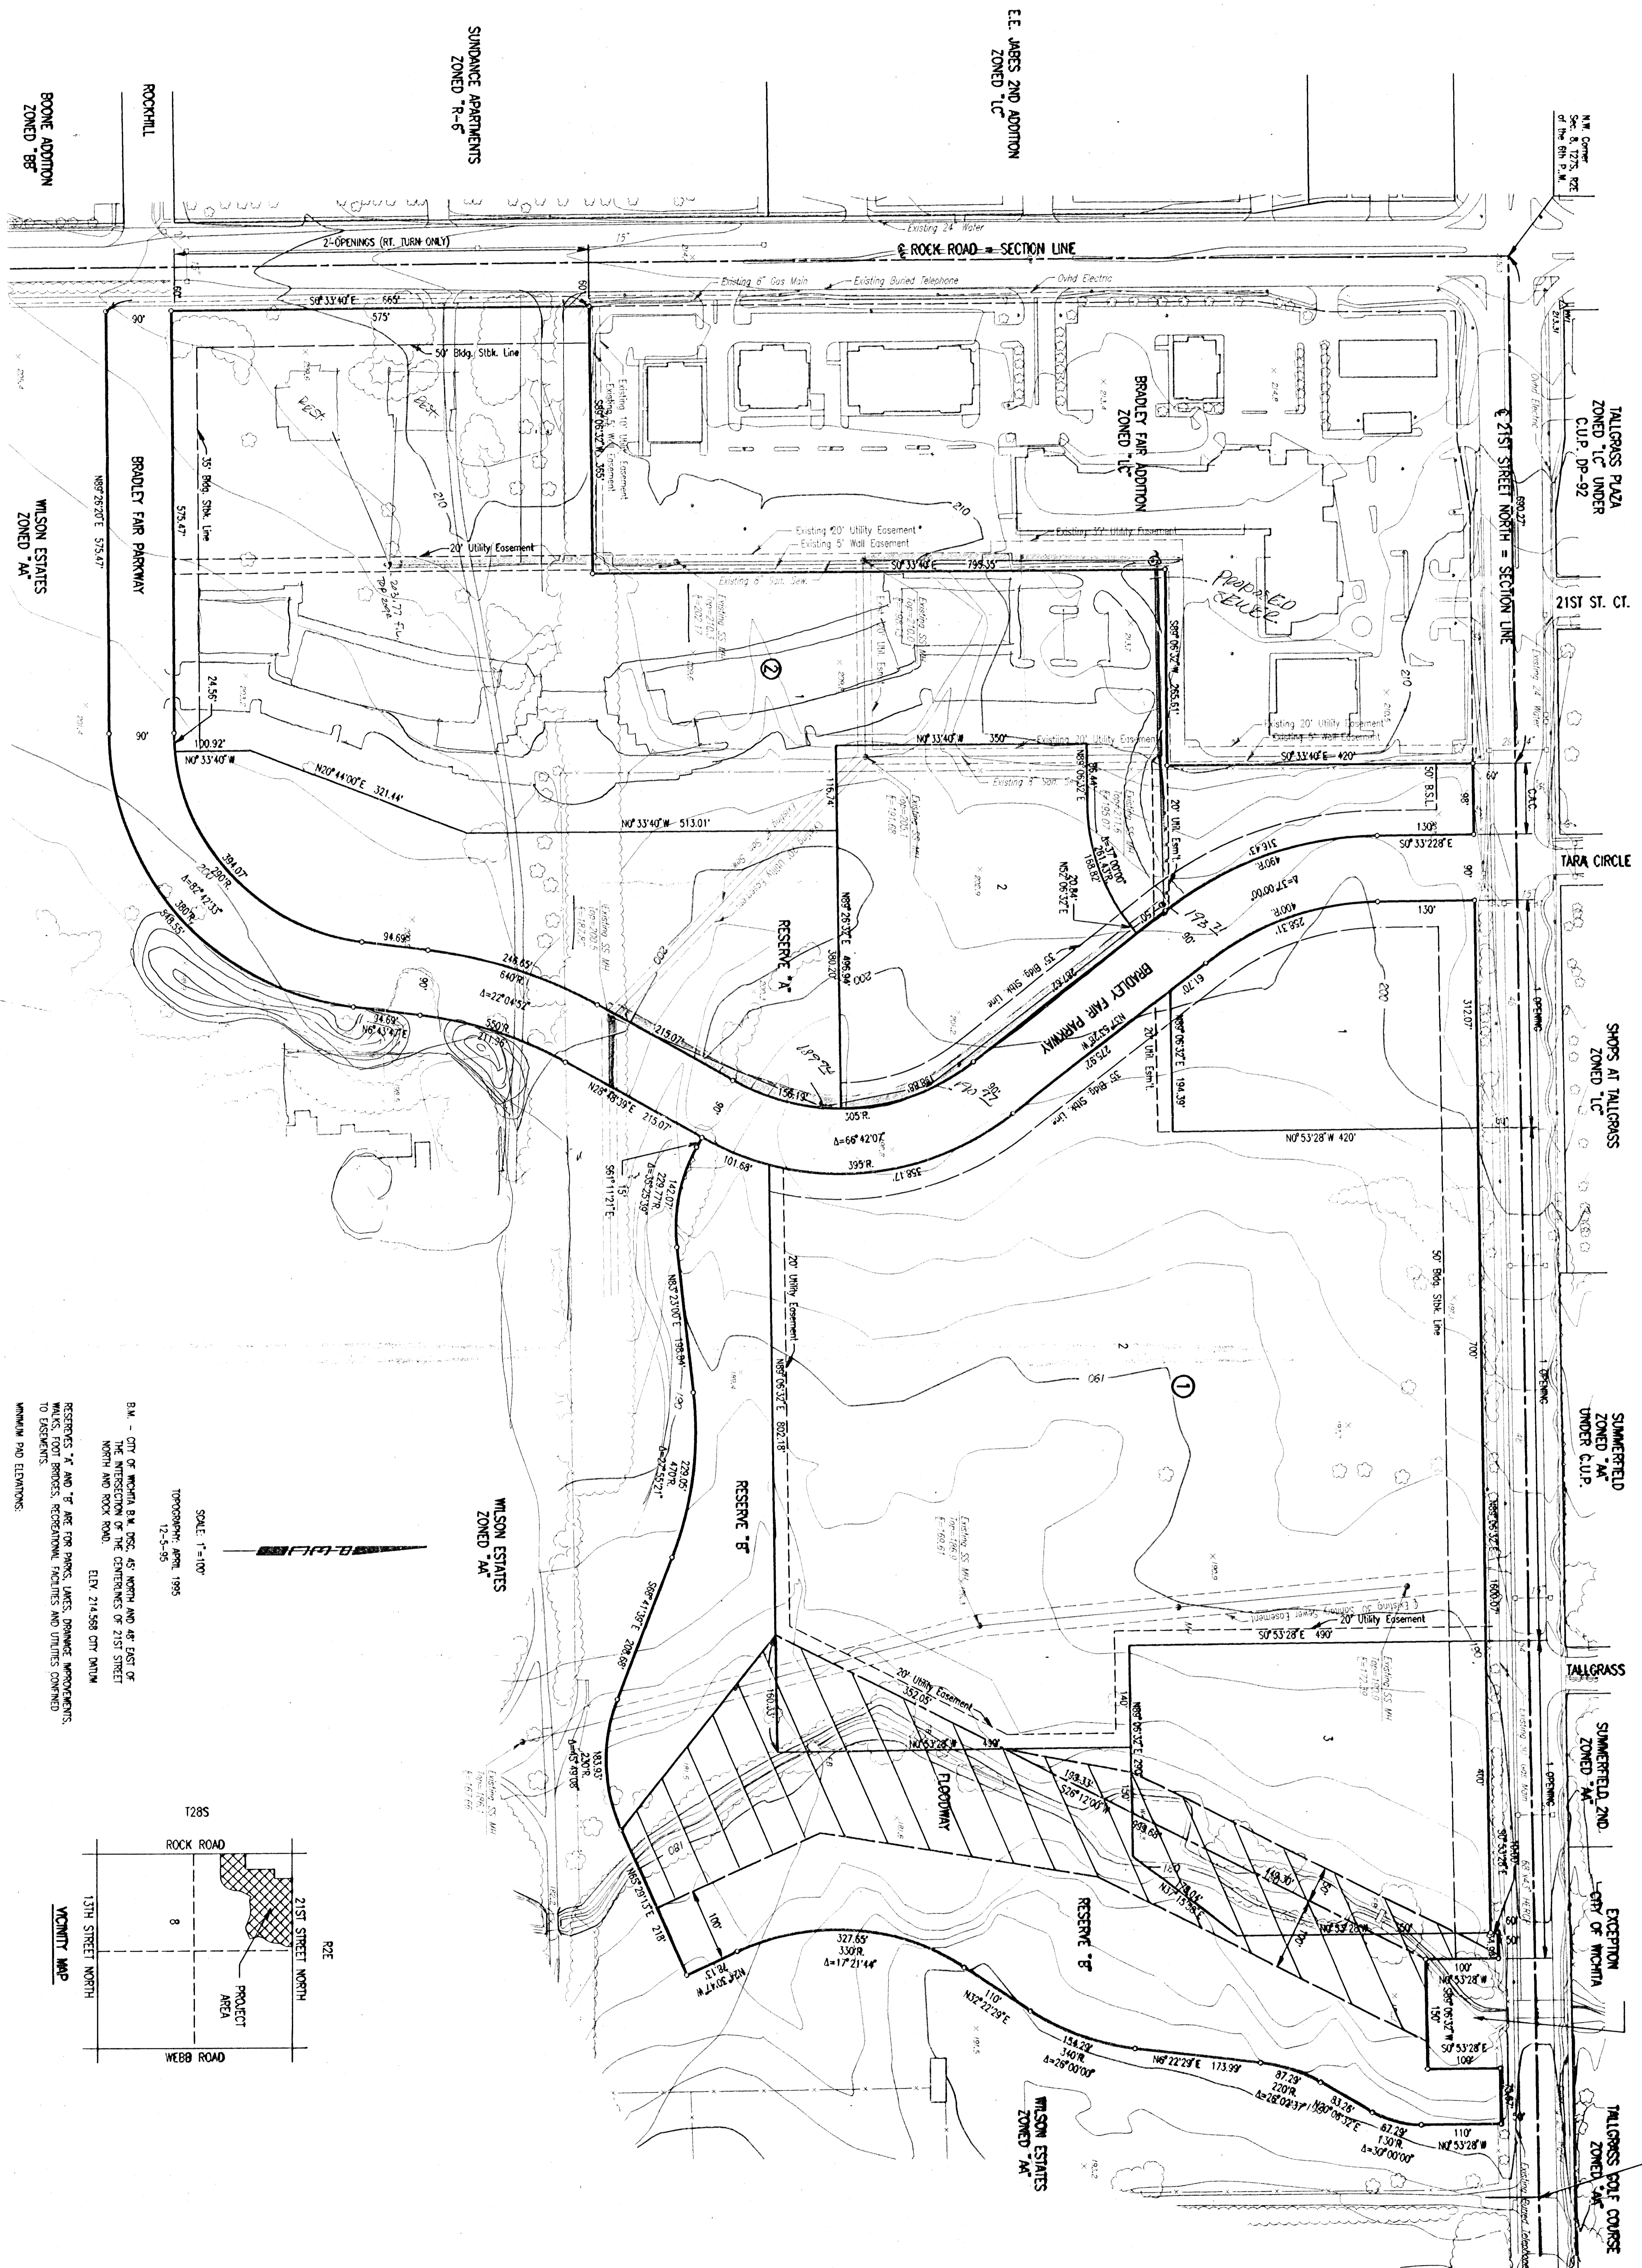

SCALE: 1"=100'



