L-23

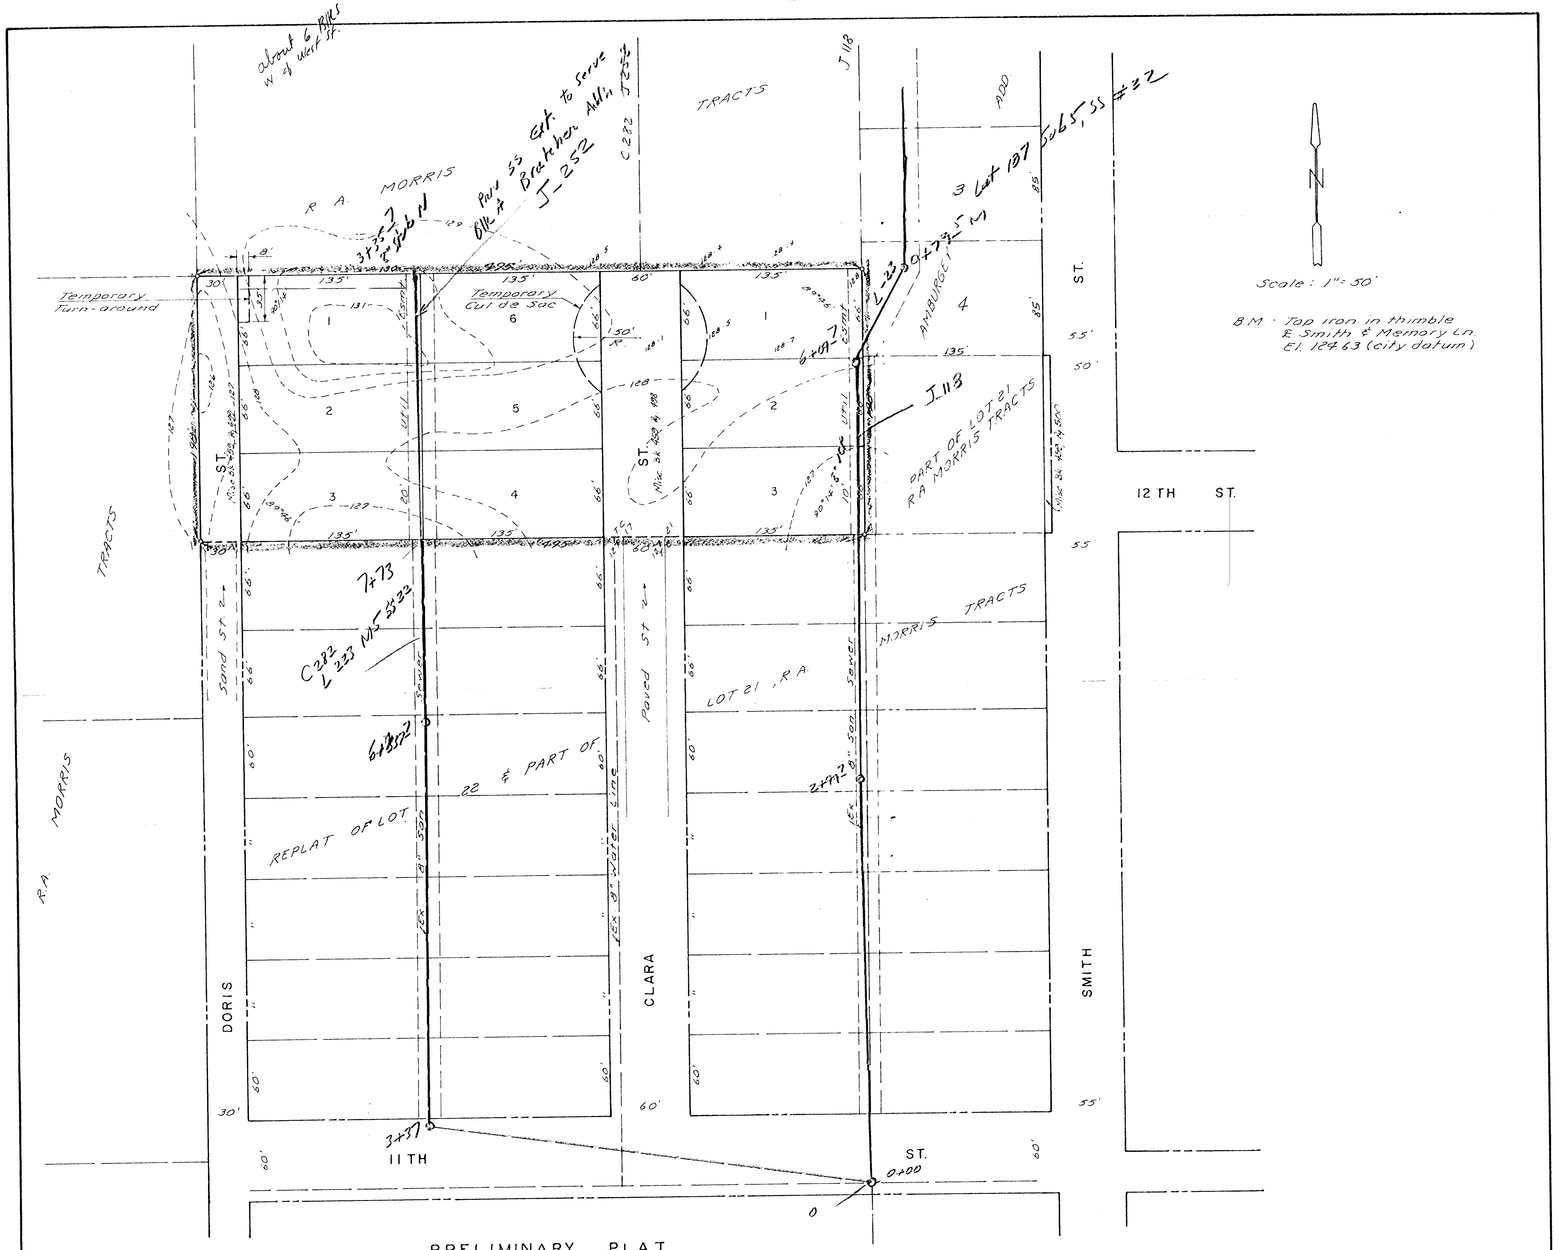

PRELIMINARY PLAT

BRATCHER ADDITION

A REPLAT OF THE N. 198' OF LOT 21, EXC. E. 140'
R. A. MORRIS TRACTS
MICHAEL D. BRATCHER & JACK R. AMBURGEY

Oct 24, 1983

BAUGHMAN COMPANY, P.A.
SURVEYING & ENGINEERING
316/262-7271 • 330 LAURA • WICHITA, KANSAS 67211