


# drainage plan

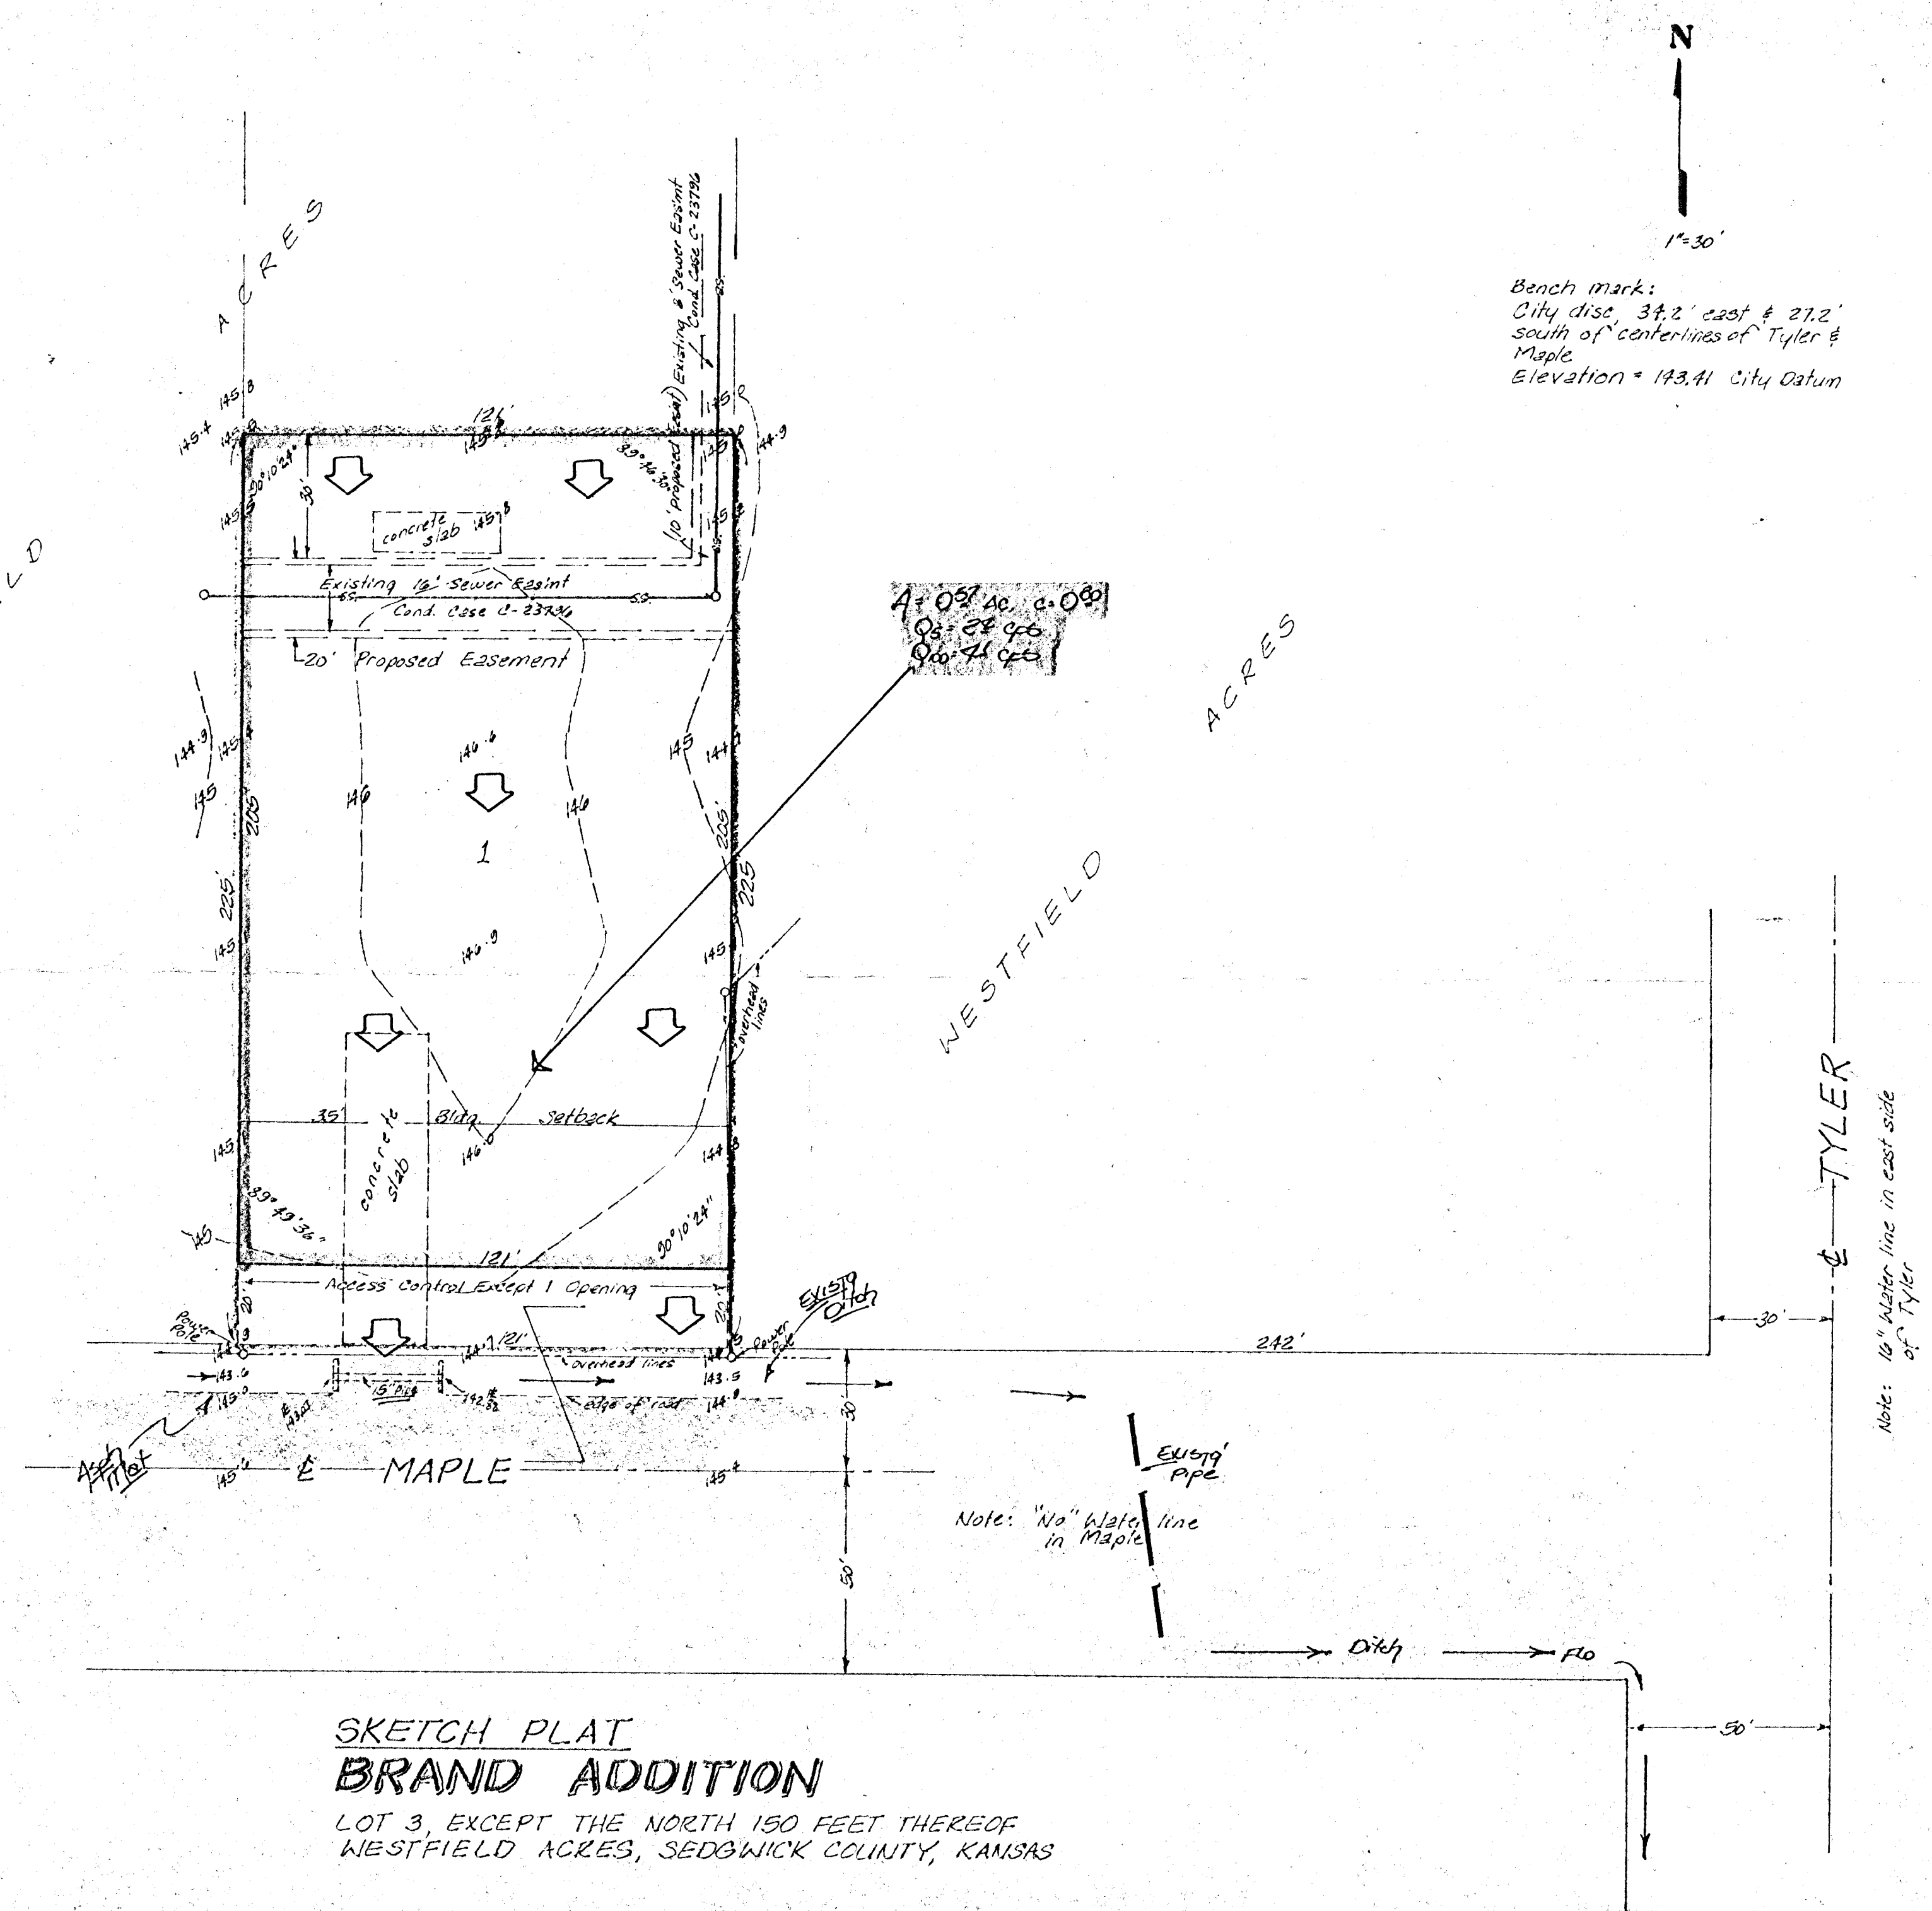

1"=30'

Bench mark:  
 City disc, 34.2' east & 27.2'  
 south of centerlines of Tyler &  
 Maple.  

SKETCH PLAT  
**BRAND ADDITION**  
 LOT 3, EXCEPT THE NORTH 150 FEET THEREOF  
 WESTFIELD ACRES, SEDGWICK COUNTY, KANSAS

OWNER: MELVIN R. BRAND

**BAUGHMAN COMPANY, P.A.**  
 SURVEYING & ENGINEERING  
 316/262-7271 • 330 LAURA • WICHITA, KANSAS 67211

MARCH 18, 1983

TYLER  

Note: "No" water line in Maple