



DATE: _____
 BY: _____
 PLANNING: _____
 SURVEYED: _____
 ALLOTTMENT CHECKED: _____
 NOTE BOOK NO. _____
 RE. OF WAY CHECKED: _____

DATE: _____
 BY: _____
 PLANNING: _____
 SURVEYED: _____
 ALLOTTMENT CHECKED: _____
 NOTE BOOK NO. _____
 RE. OF WAY CHECKED: _____

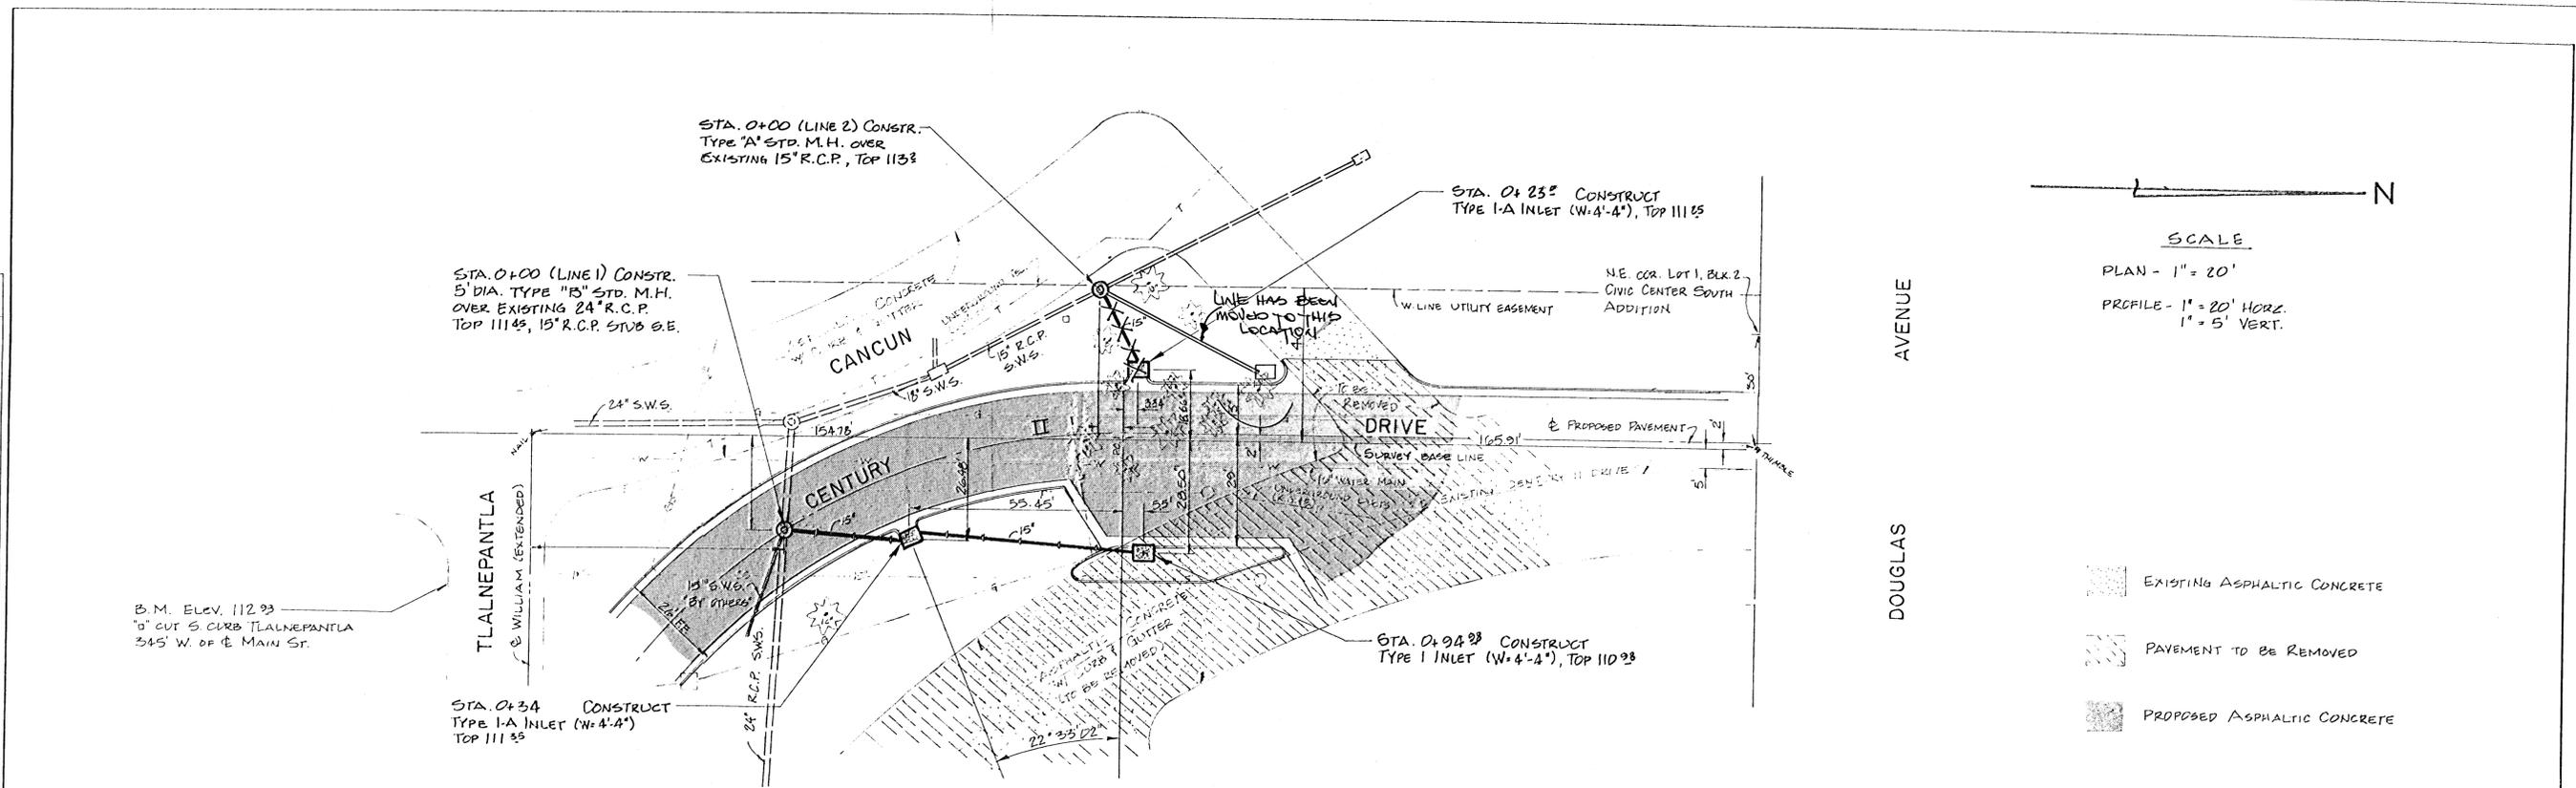

SCALE
 PLAN - 1" = 20'
 PROFILE - 1" = 20' HORIZ.
 1" = 5' VERT.

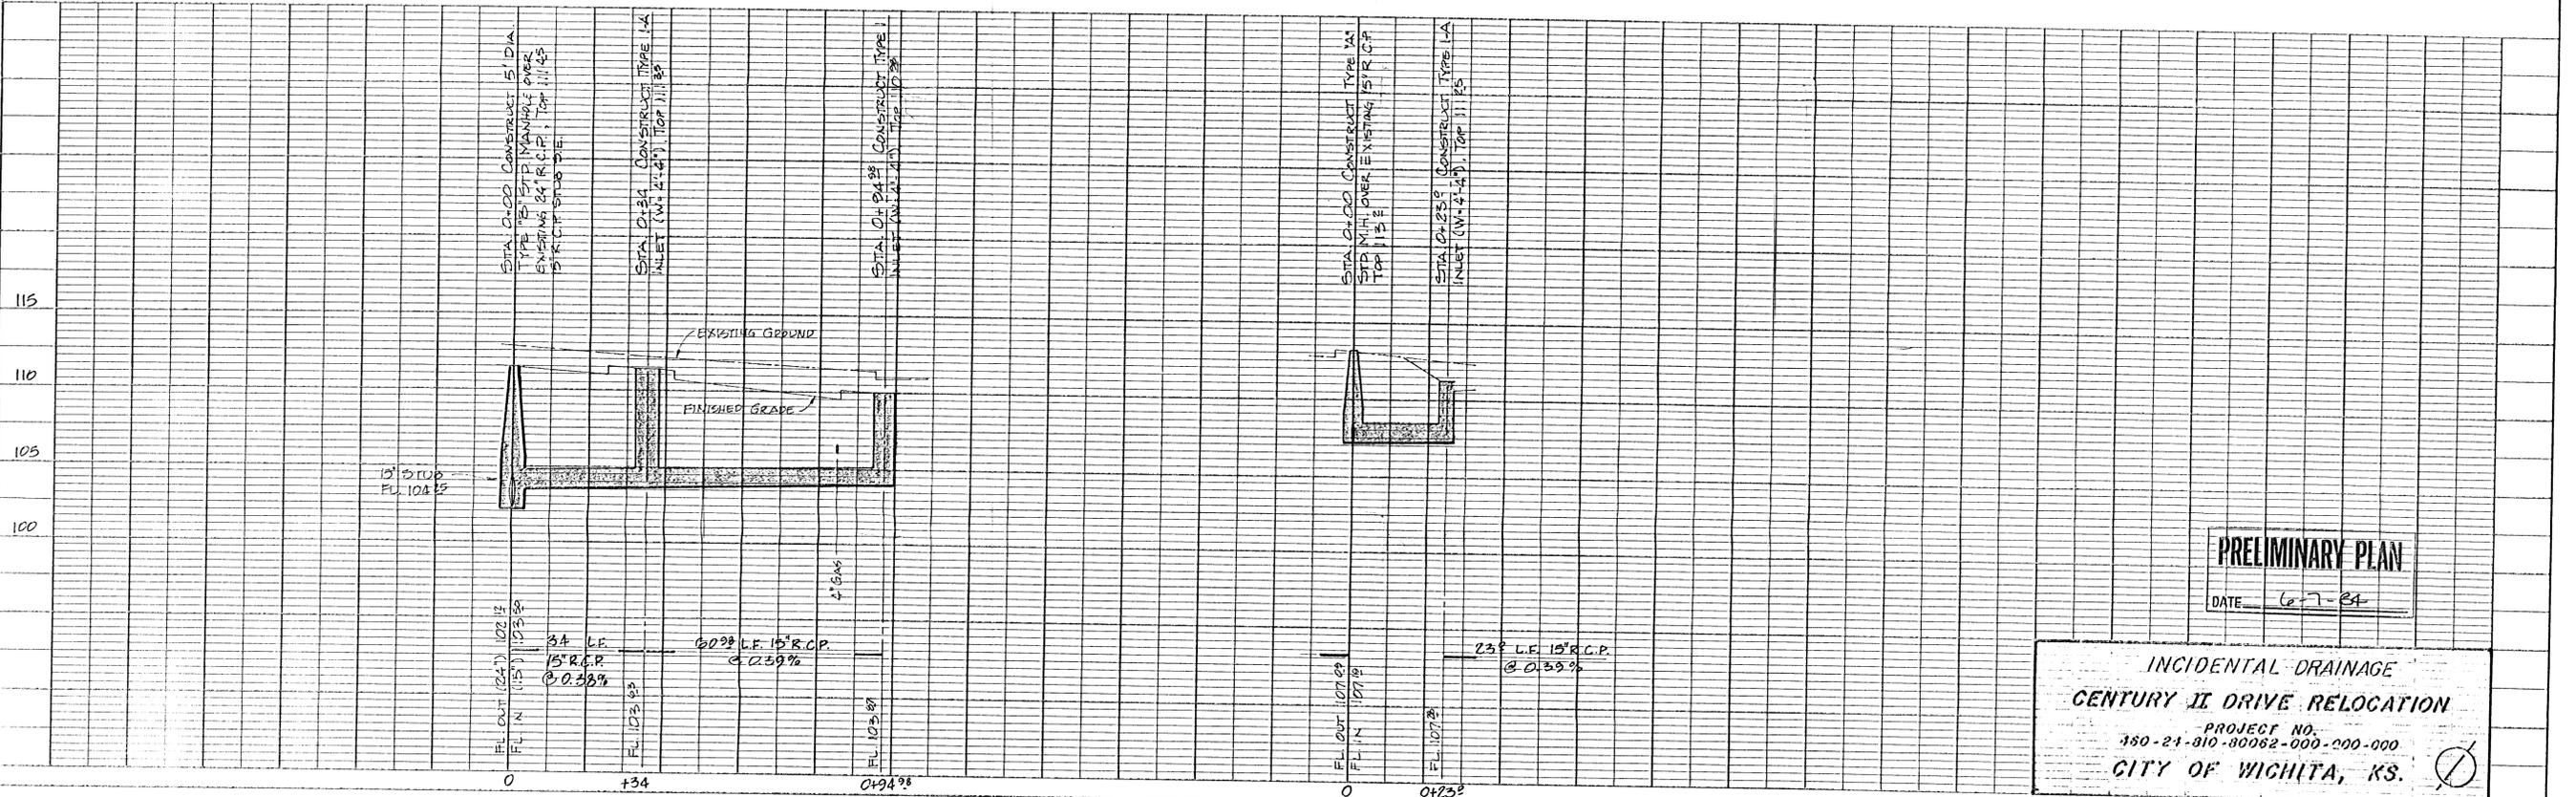

PRELIMINARY PLAN
 DATE: 6-7-84

INCIDENTAL DRAINAGE
 CENTURY II DRIVE RELOCATION
 PROJECT NO. 350-21-810-80082-000-200-000
 CITY OF WICHITA, KS.

