


PLANS REVIEWED
 FIRE PREVENTION BUREAU
 CITY OF WICHITA
 DATE 10/29/02 BY [Signature]

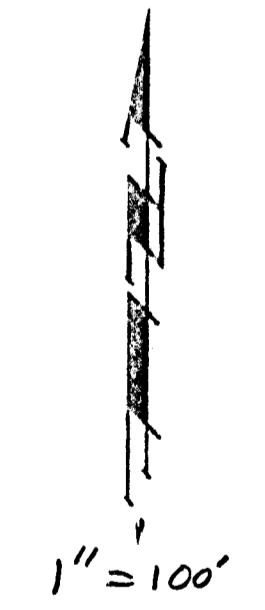

**BREEZY POINTE
 2ND ADDITION**
 WICHITA, SEDGWICK COUNTY, KANSAS.
Waterline / Hydrant Layout